

FINAL PROOF SURVEY AND CLAIM OF BENEFICIAL USE LOCATED WITHIN

RECEIVED

JUN 15 2000

WATER RESOURCES DEPT.
SALEM, OREGON


NE 1/4, NW 1/4, SECTION 23, T.3S., R.24E., W.M
MORROW COUNTY, OREGON

APPLICATION S-83742

PERMIT 53502

APPLICANT: PATRICIA F. WALKER


CORNER TIE:
SPRING BOX IS
LOCATED
620' SOUTH AND
360' WEST OF THE
NORTH 1/4 CORNER
OF SECTION 23,
T.3S., R.24E.

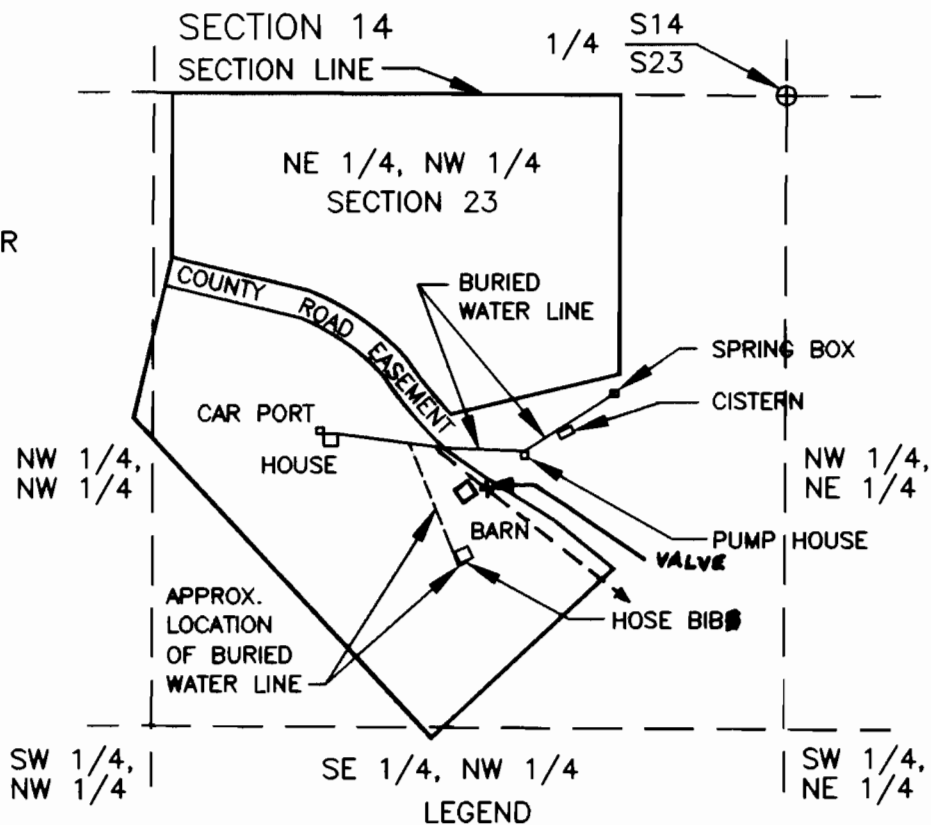

- LEGEND
- ⊕ MONUMENTED CORNER
 - BURIED WATER LINE. SIZE & MATERIAL UNKNOWN
 - - - APPROXIMATE LOCATION OF BURIED WATER LINE. SIZE & MATERIAL UNKNOWN

REV. MAY 12, 2000

THIS MAP IS PREPARED
FOR THE EXPRESS
PURPOSE TO SHOW WATER
APPROPRIATION AND USE.
IT IS NOT INTENDED TO
SHOW OR LOCATE
PROPERTY OWNERSHIP
LINES.

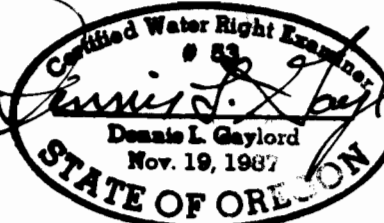

RENEWS 6/30/2001

DENNIS L. GAYLORD,
CWRE
71614 S.W. LAKE DRIVE
PENDLETON, OR 97801
(541)-276-6260 ©

May 8, 2000

Drawn by: Mill Creek Drafting