




T.6N. R.34E. W.M.

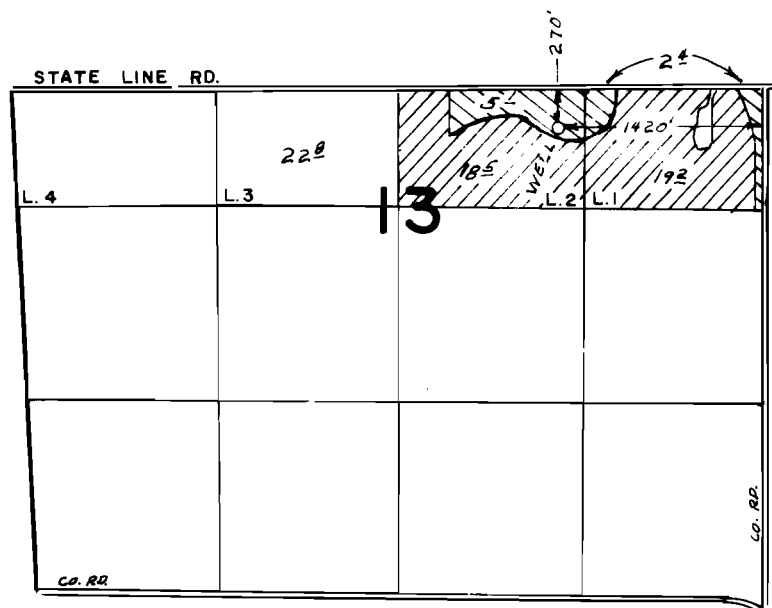

PRIMARY 
SUPPLEMENTAL 

FINAL PROOF SURVEY UNDER

Application No. G-6233 Permit No. G-5880
IN NAME OF

.....ROWENA M. BOSTWICK.....

Surveyed APR. 28. 1977, by L.H. NUNN.....