


T.9&10S.,R.21E.,W.M.

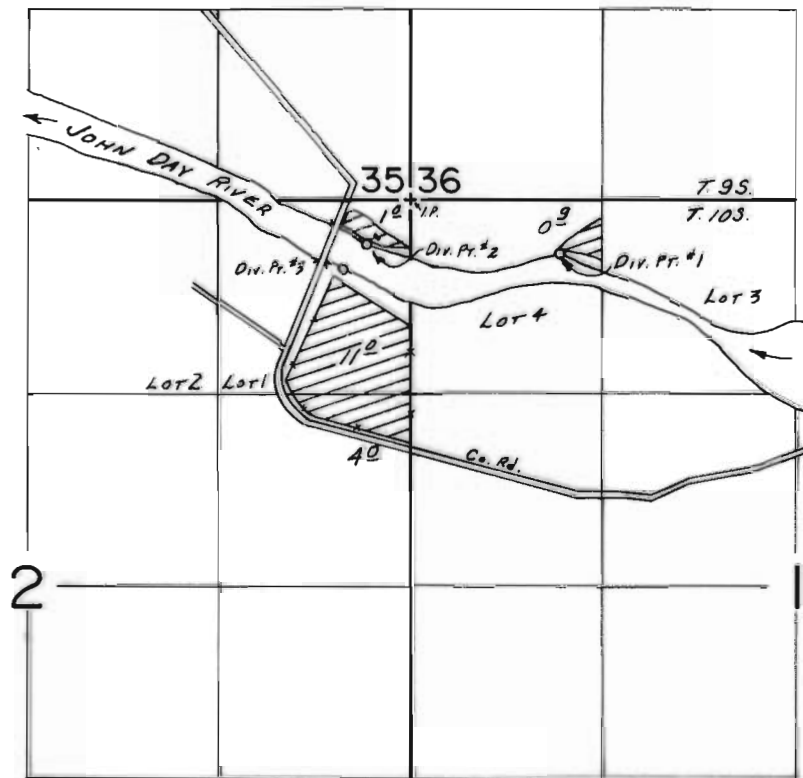

Div. Pts. Loc: #1-360'S. & 1020'E.; #2-290'S. & 280'W.; #3-480'S. & 450'W.; ALL FROM NE COR. SEC. 2.

FINAL PROOF SURVEY UNDER

Application No. 52684... Permit No. 38066.....
IN NAME OF

CHARLES D. POWELL

Surveyed JUNE 26, 1980, by S.C. BROWN