


Holiday Ditch

4349
3947
7682
77011

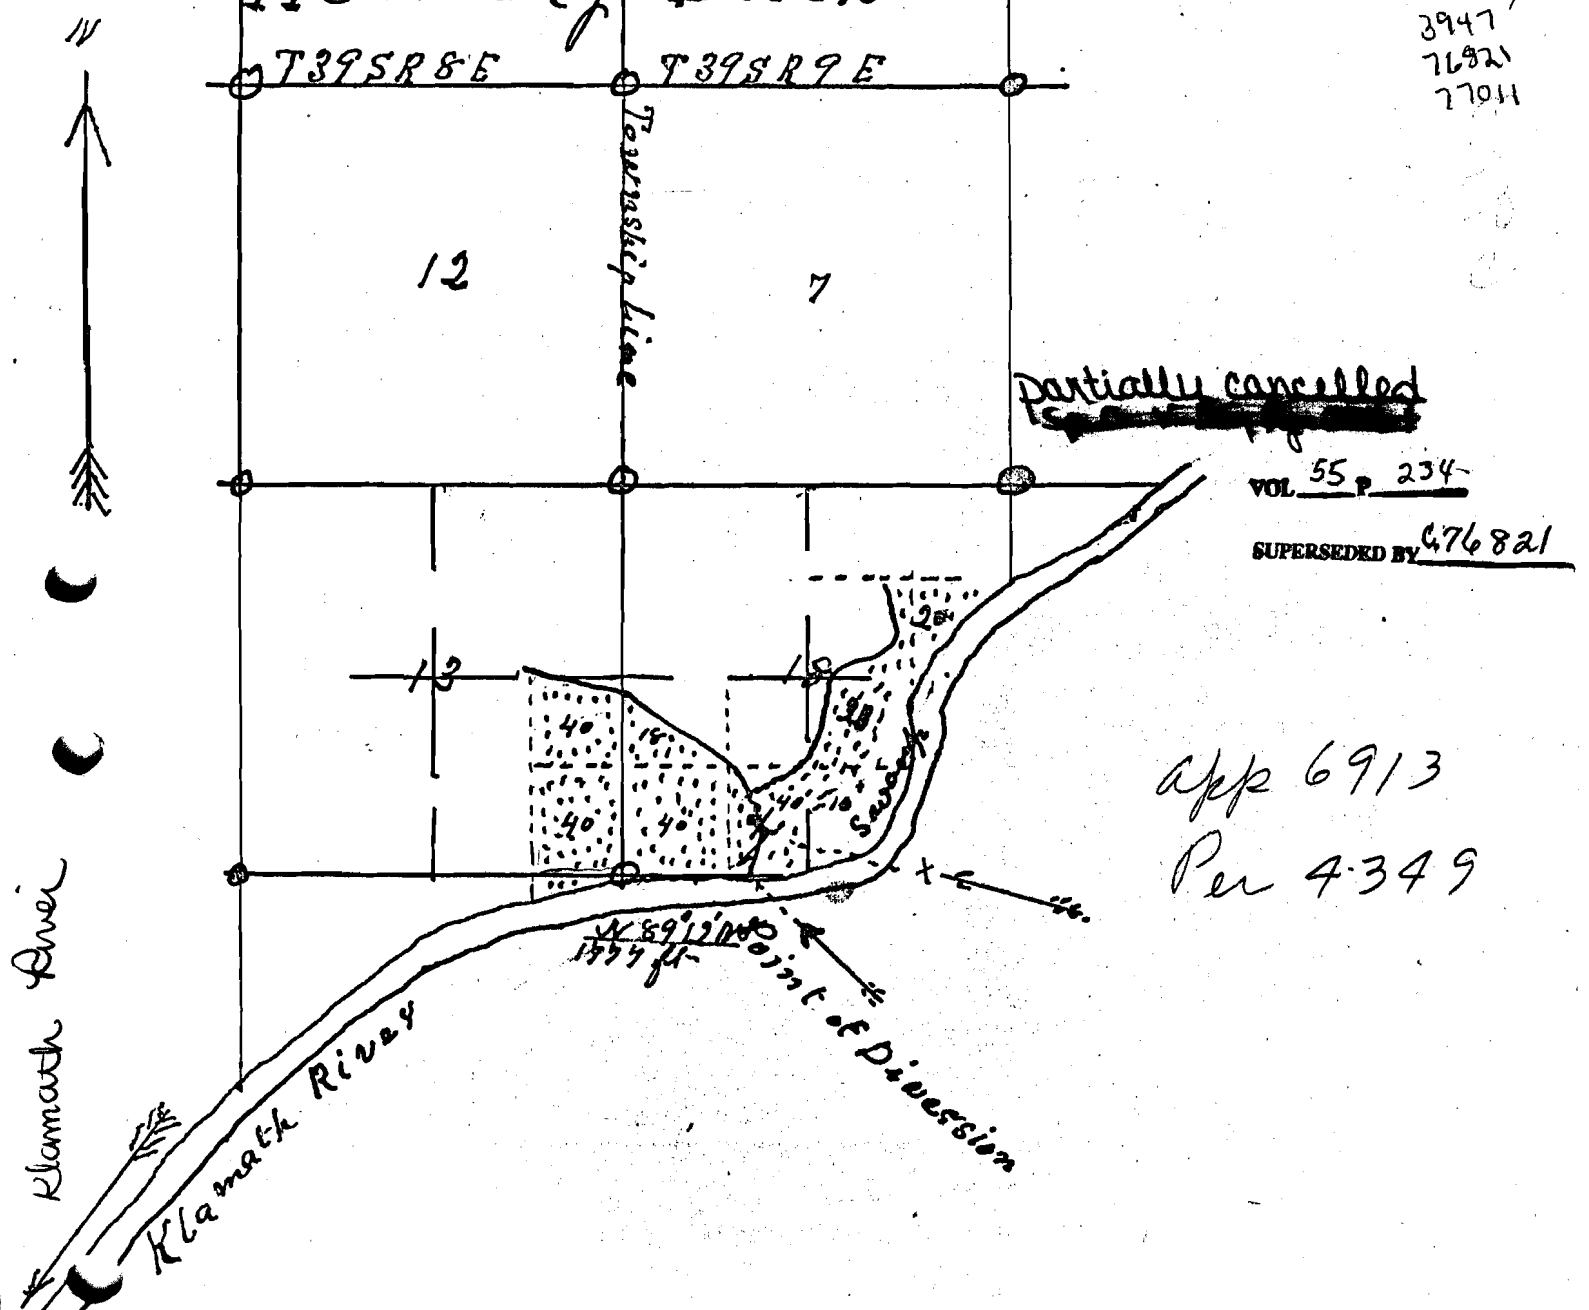

~~partially cancelled~~
VOL. 55, P. 234-
SUPERSEDED BY 476821

App 6913
Per 4349

I R A Emmitt of Klamath Falls Oregon do hereby certify that this map was made from notes taken during an actual survey made by me on Nov 18th 1919 and that it correctly represents the works described in the accompanying application together with the location of streams and other ditches in the immediate vicinity

R A Emmitt
Surveyor

STATE ENGINEER
RECEIVED
NOV 29 1919
