


T26S.R7W.W.M.

1 INCH = 1320 FEET

RECEIVED

MAY 2 1989

WATER RIGHTS OFFICE

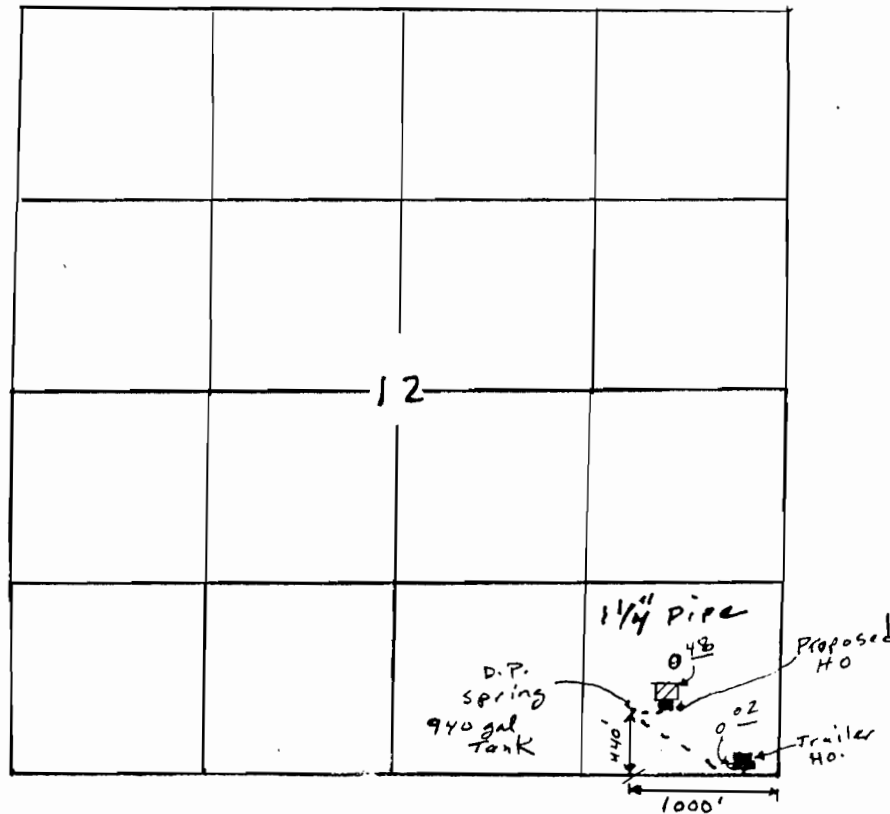

THE PURPOSE OF THIS MAP IS TO IDENTIFY THE LOCATION OF THE WATER RIGHT. IT IS NOT INTENDED TO PROVIDE INFORMATION RELATIVE TO THE LOCATION OF PROPERTY OWNERSHIP BOUNDARY LINES.



FINAL PROOF SURVEY UNDER

Application No. 71966 Permit No. 51853
IN NAME OF
KENNETH AND PATRICIA KALCHERT

Surveyed OCT 7 1998 by DUANE KIRBY