


RECEIVED

MAR 24 1981

WATER RESOURCES DEPT
SALEM, OREGON

T2S, R44 E.W.M.

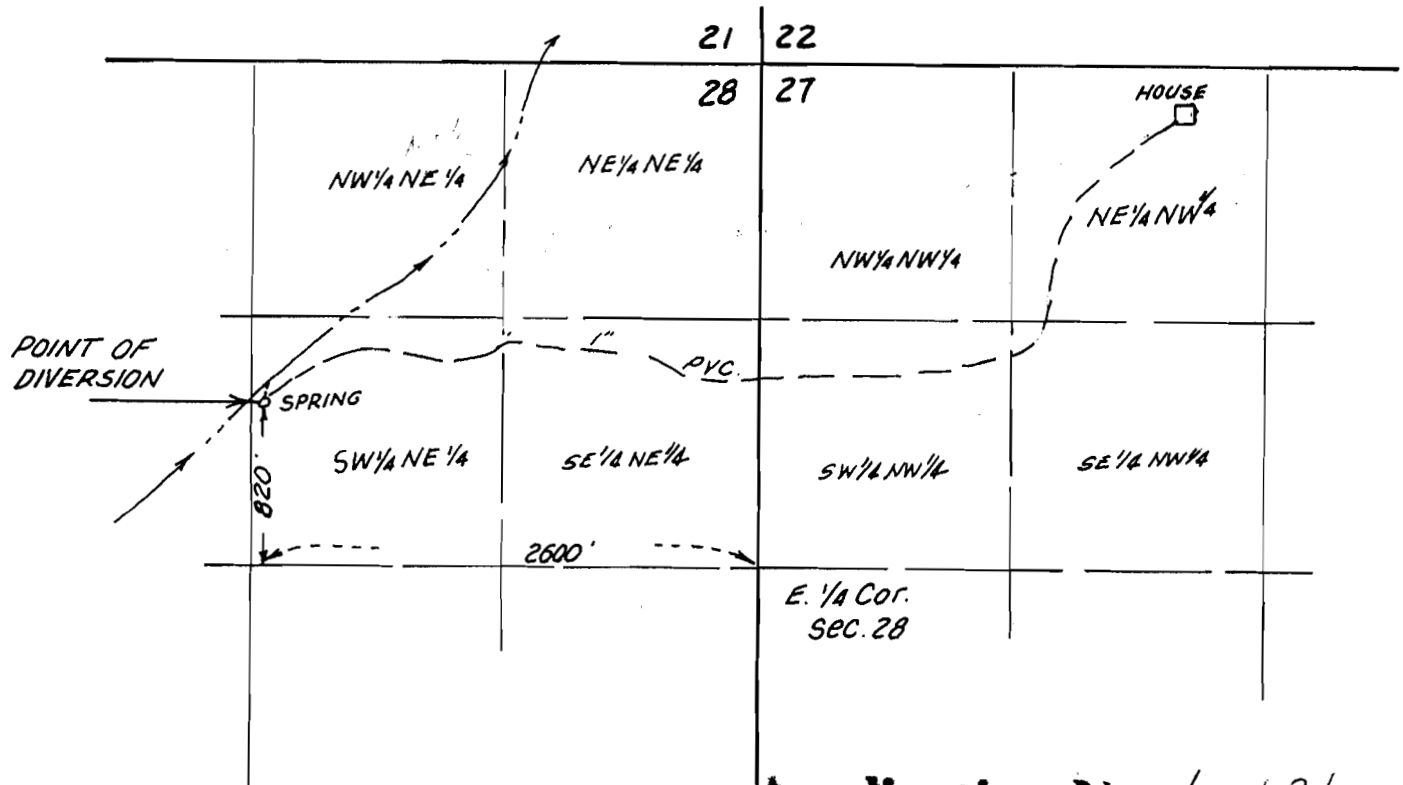

Application No. 61436
Permit No. 45652

SCALE: 1" = 1000'

Prepared for Dan Gile
By: Verne H. Russell - PLS 427
Date: March 5, 1981