


T. 7S., R. 5W., W.M.

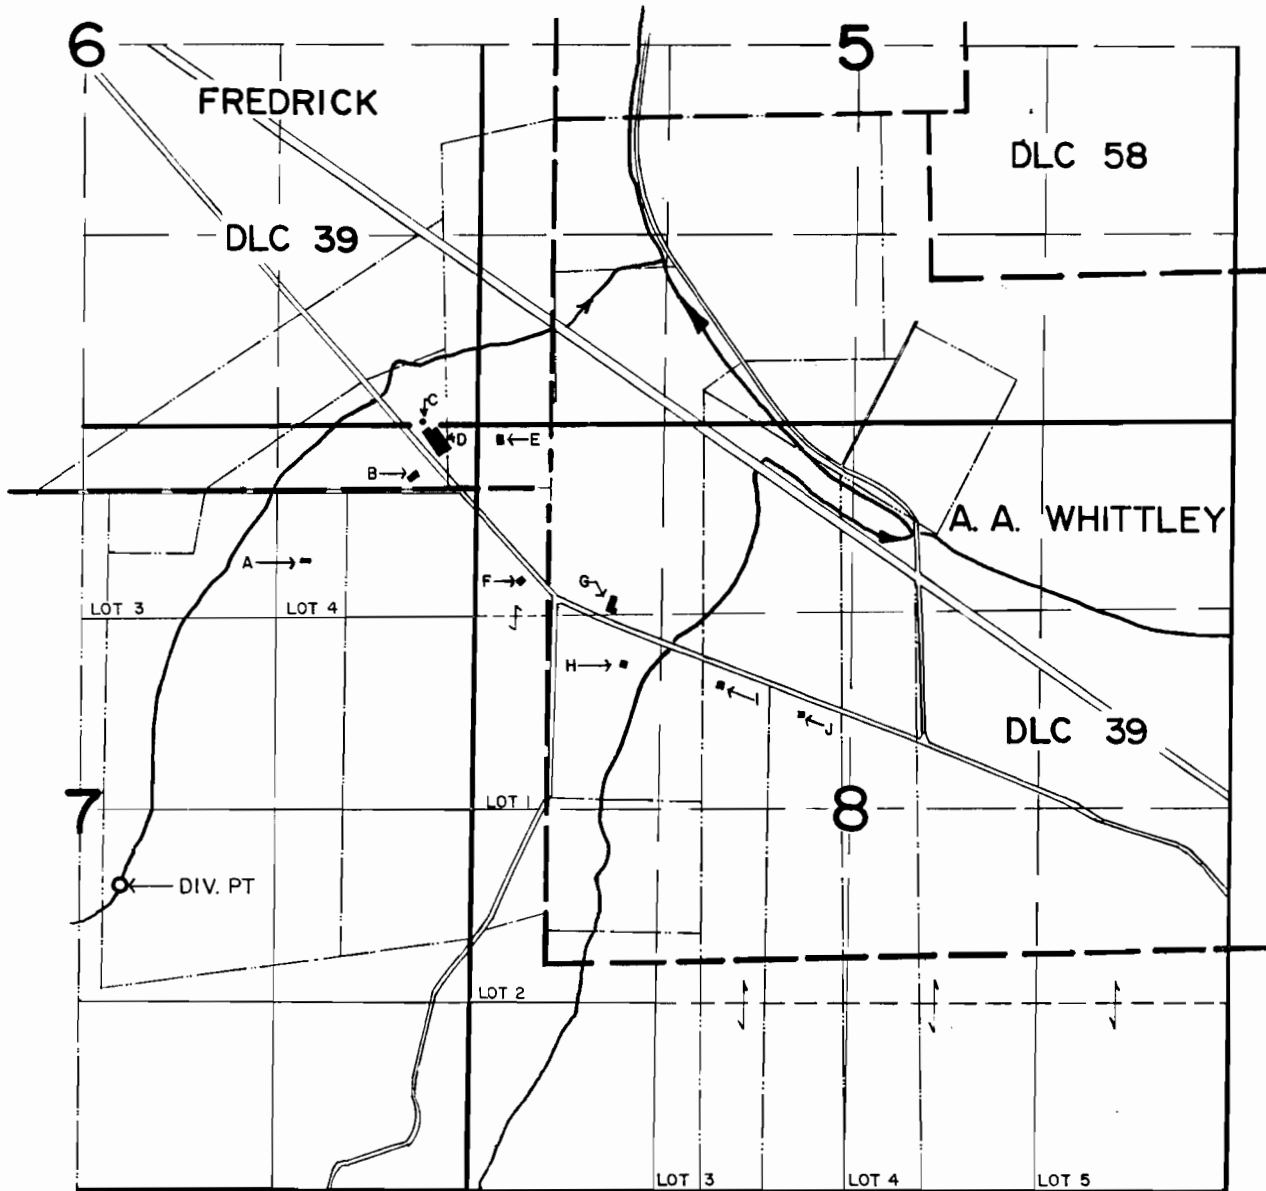

- A) AUGUST MAY
- B) DAVID NACHTIGAL
- C) PARISH HOUSE
- D) CHURCH
- E) ABRAHAM M. TOEWS
- F) P. H. HUGHES, TRUSTEE
- G) SCHOOL
- H) JACOB H. VOTH
- I) JOHN K. REIMER
- J) OTTO F. MAY

FIELD INSPECTION

OF DOMESTIC USE UNDER CERTIFICATE 7702

Application No. 11956. Permit No. 8394.....

IN NAME OF

AUGUST MAY, et al

Surveyed AUG 12, 1980 by L.M. TOLL