


T.3N., R.10W., W.M.
SECTION 11

RECEIVED

FEB 08 2000

WATER RESOURCES DEPT.
SALEM, OREGON

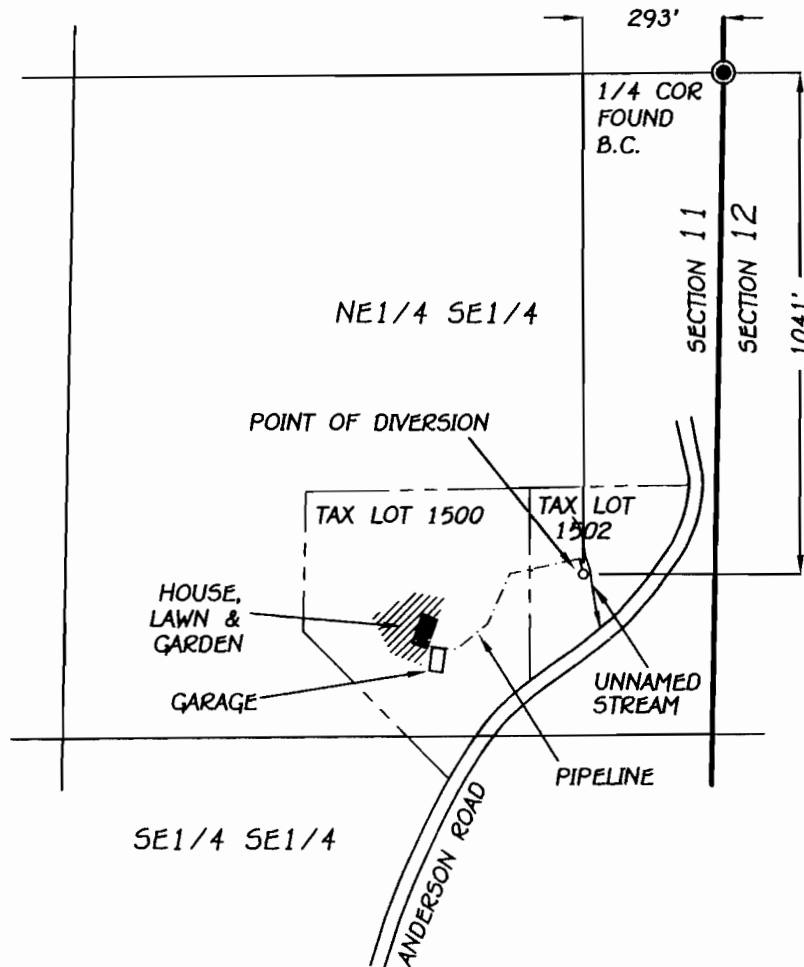

SCALE:
1" = 400'

FINAL PROOF SURVEY


UNDER

APPLICATION NO. 73419, PERMIT NO. 52194

IN THE NAME OF

JAMES R. DEY & ELIZABETH M. DEY

SURVEYED SEPT. 1, 1999

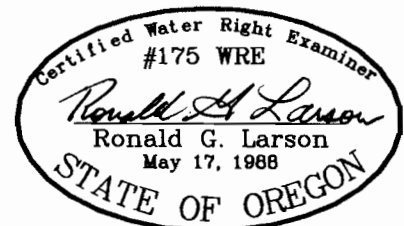

RENEWAL DATE: DECEMBER 31, 2000

FILE: 3515-10020-02-02.DWG

THE PURPOSE OF THIS MAP IS TO IDENTIFY THE LOCATION OF THE WATER RIGHT. IT IS NOT INTENDED TO PROVIDE INFORMATION RELATIVE TO THE LOCATION OF PROPERTY OWNERSHIP BOUNDARY LINES.

HLB & ASSOCIATES, INC.
SURVEYING • ENGINEERING • PLANNING

4253A HWY 101 N.
GEARHART, OR 97138
(503) 738-3425
FAX: (503) 738-7455