


T.4S.R.3W.W.M.

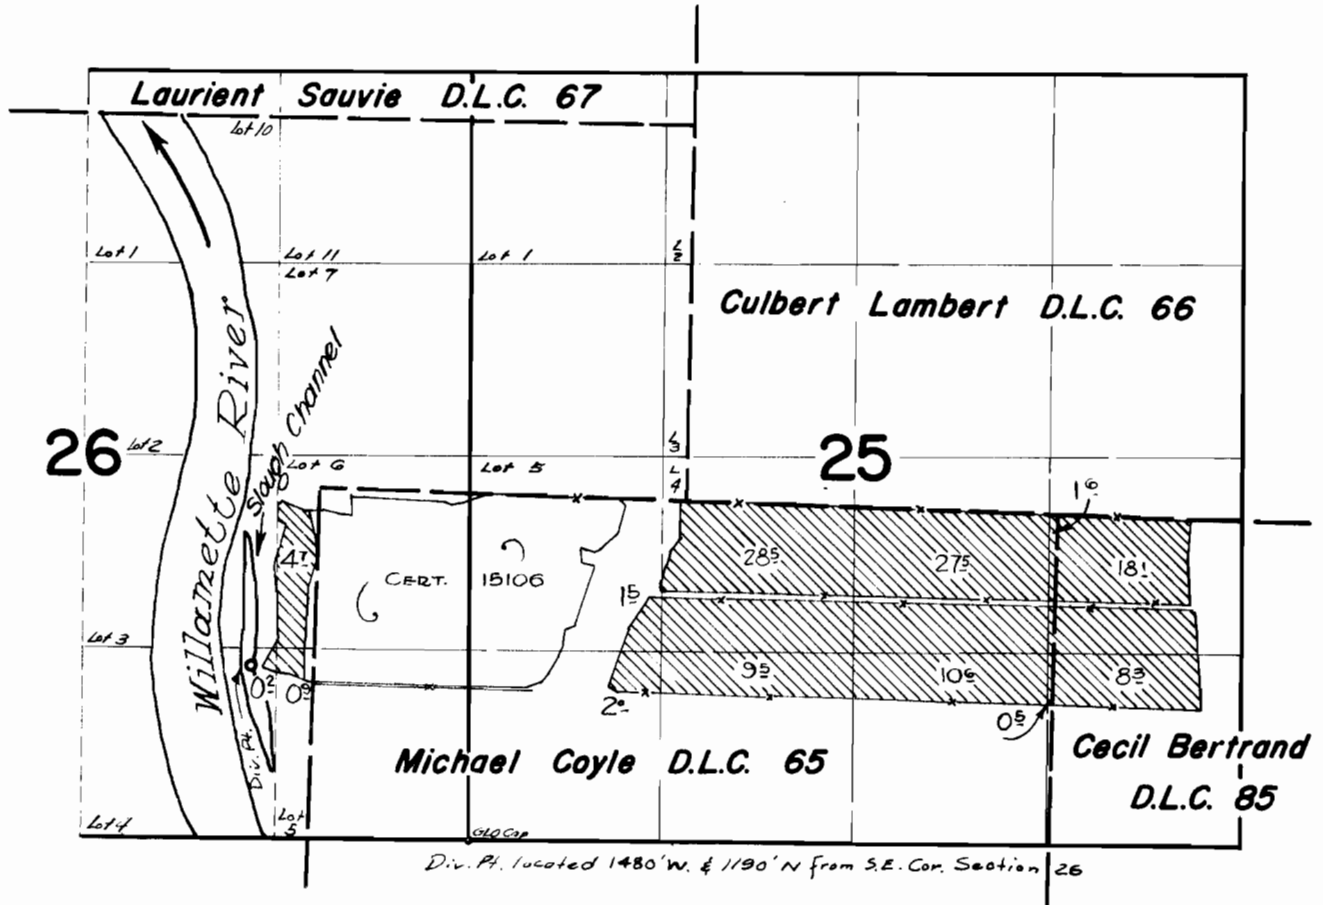

**FINAL PROOF SURVEY**  
UNDER

Application No. 37629 ... Permit No. 28058 ...  
IN NAME OF

**C. H. COYLE**

Surveyed June 2, 1905 by *[Signature]*