


G-10146
67727
77033

T.24S., R.18E., W.M.

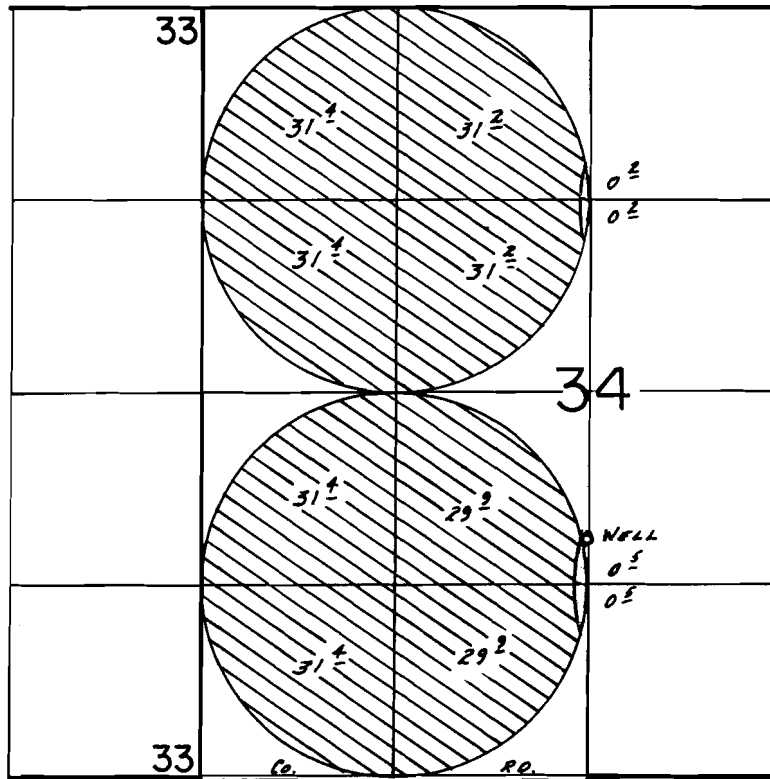

WELL LOC.: 1630' N. & 2630' E. FROM SW COR. SEC. 34.

SCALE: 1" = 1320'

FINAL PROOF SURVEY UNDER

Application No. G-10956 Permit No. G-10146....
IN NAME OF

960 RANCH, INC.....

Surveyed Sept. 1, 1988, by B.W. BISHOP.....