


T.37S., R.7W., W.M.

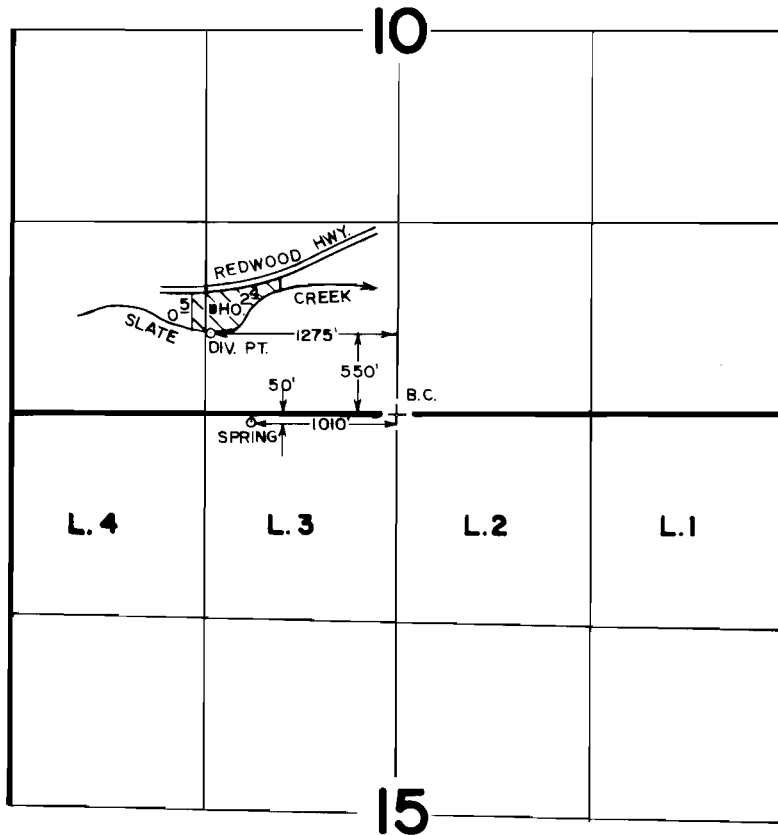

FINAL PROOF SURVEY
UNDER

Application No. **49099** Permit No. **36154**.....
IN NAME OF

.....**MICHAEL S. & LYNN WRIGHT**.....

Surveyed **AUG. 16**, 19**82**, by **B. S. JAMES**.....

SCALE: 4" = 1 MILE