


11988

Sec. 27
28
33
34

Tp. 10
R20 E

On 8396
7705

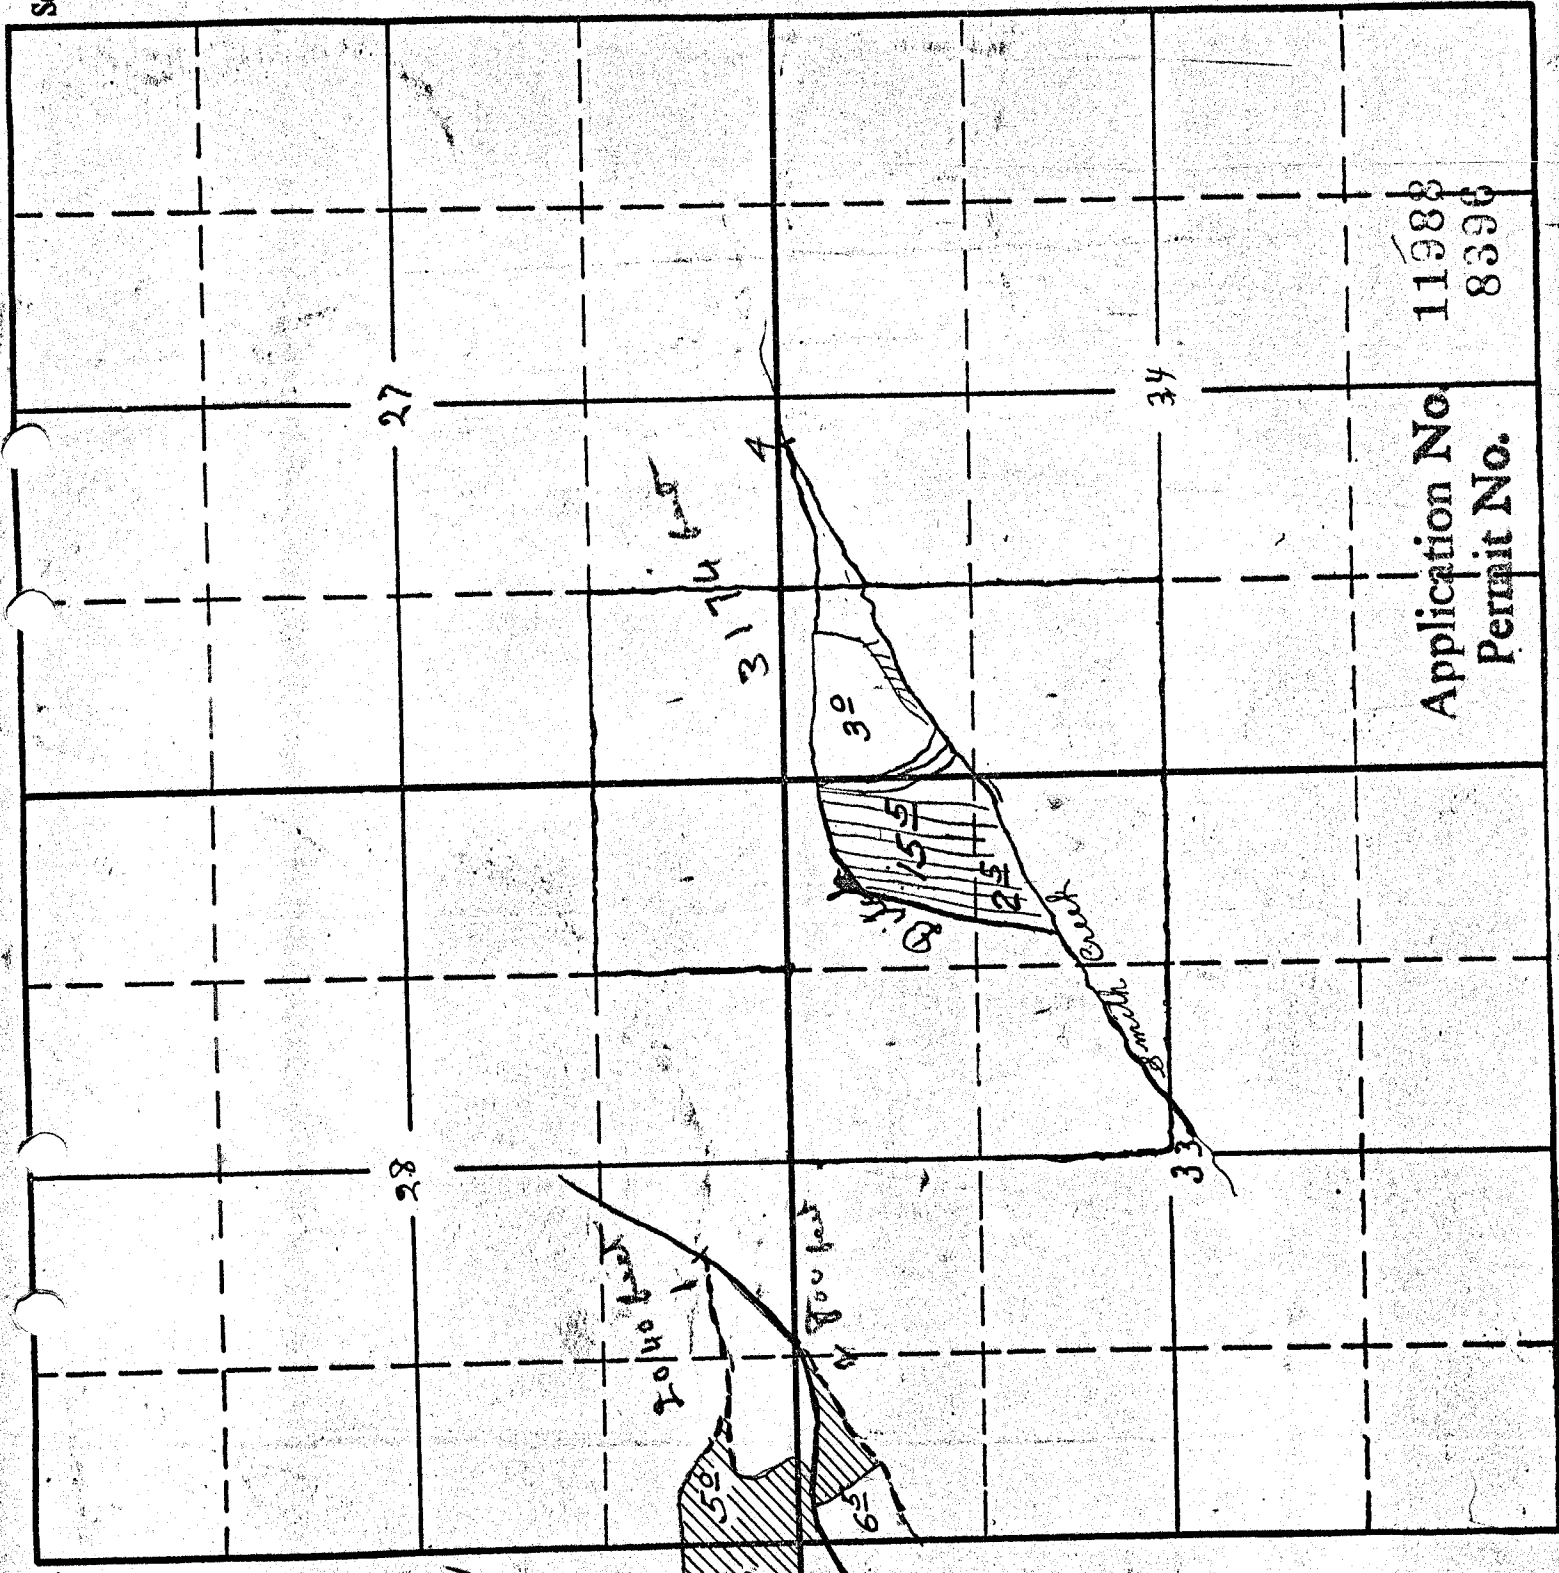

Application No. 11988
Permit No. 8396