


T.24S.R.7 W.W.M.

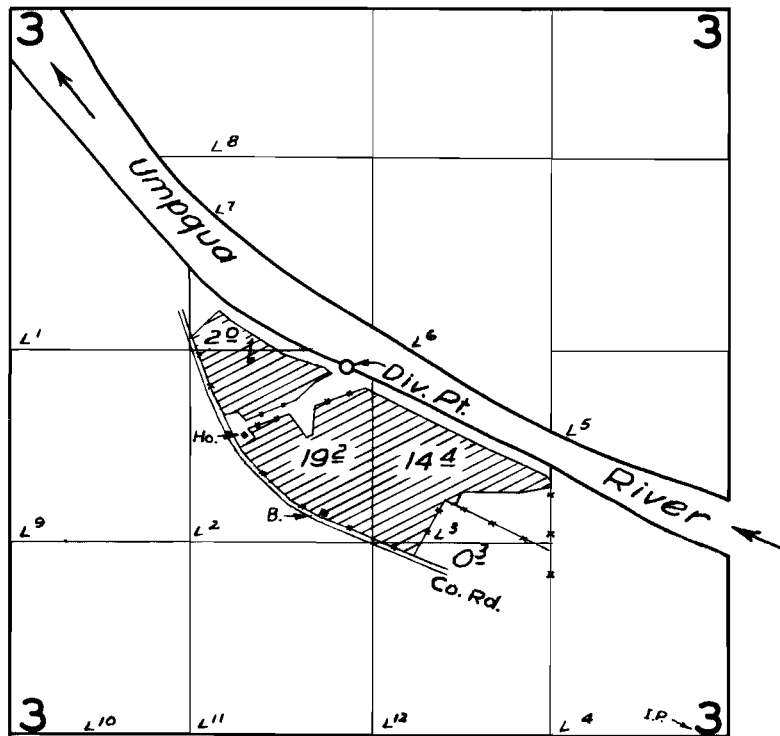

FINAL PROOF SURVEY
UNDER

Application No. 27182 Permit No. 21378
IN NAME OF

Carl W. Brownson

Surveyed Aug. 18 1957, by m. Bish