


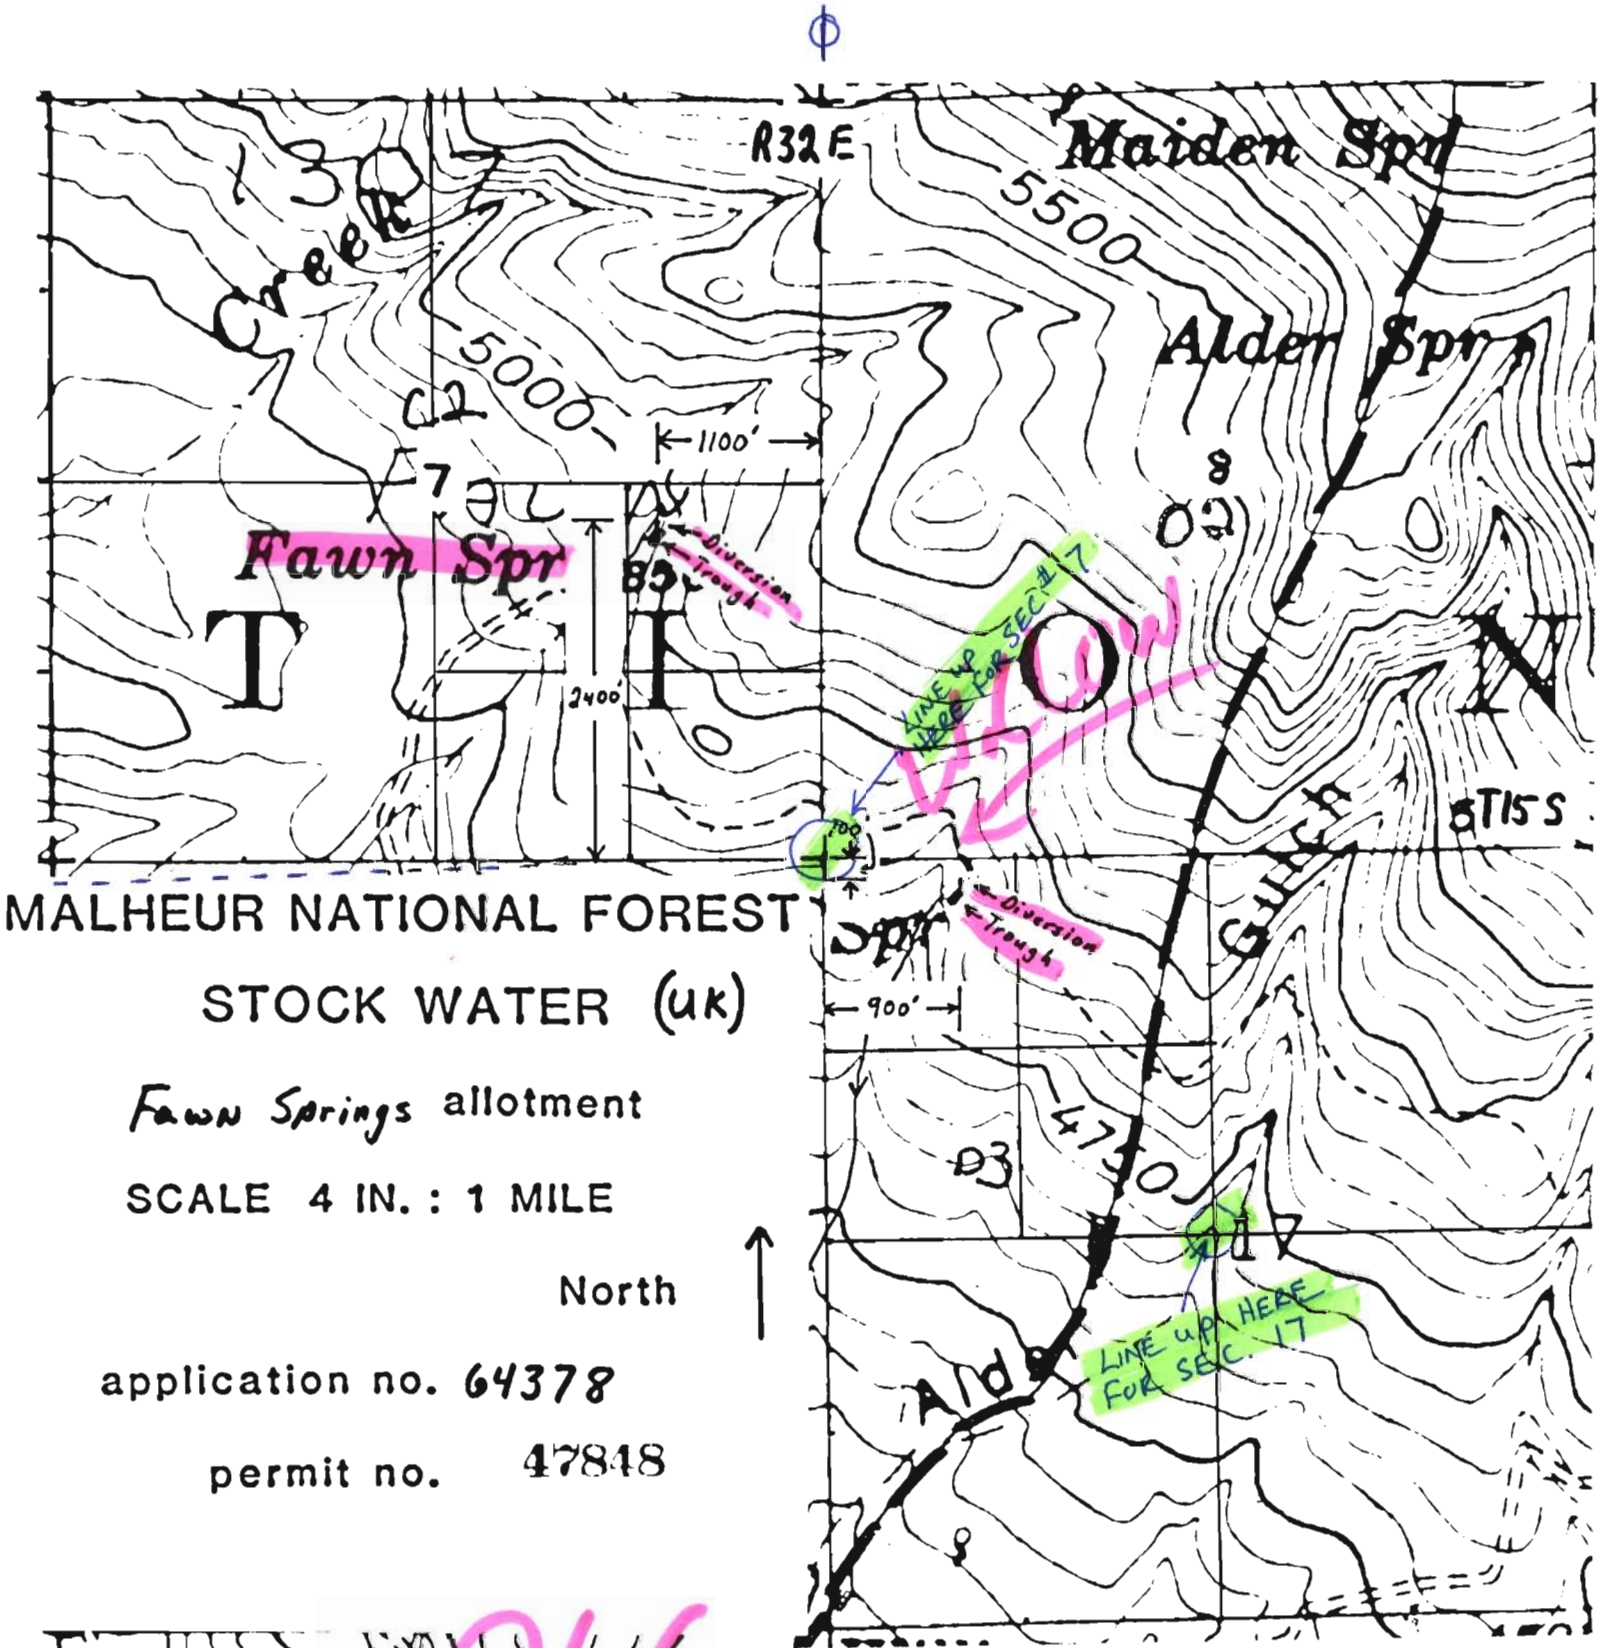

MALHEUR NATIONAL FOREST

STOCK WATER (UK)

Fawn Springs allotment

SCALE 4 IN. : 1 MILE

North

application no. 64378

permit no. 47848

RECEIVED

MAY 31 1983

WATER RESOURCES DEPT.
SALEM, OREGON