

MALHEUR NATIONAL FOREST
STOCK WATER


Fawn Springs allotment

SCALE 4 IN. : 1 MILE

North ↑

application no. 64379

permit no. 47849

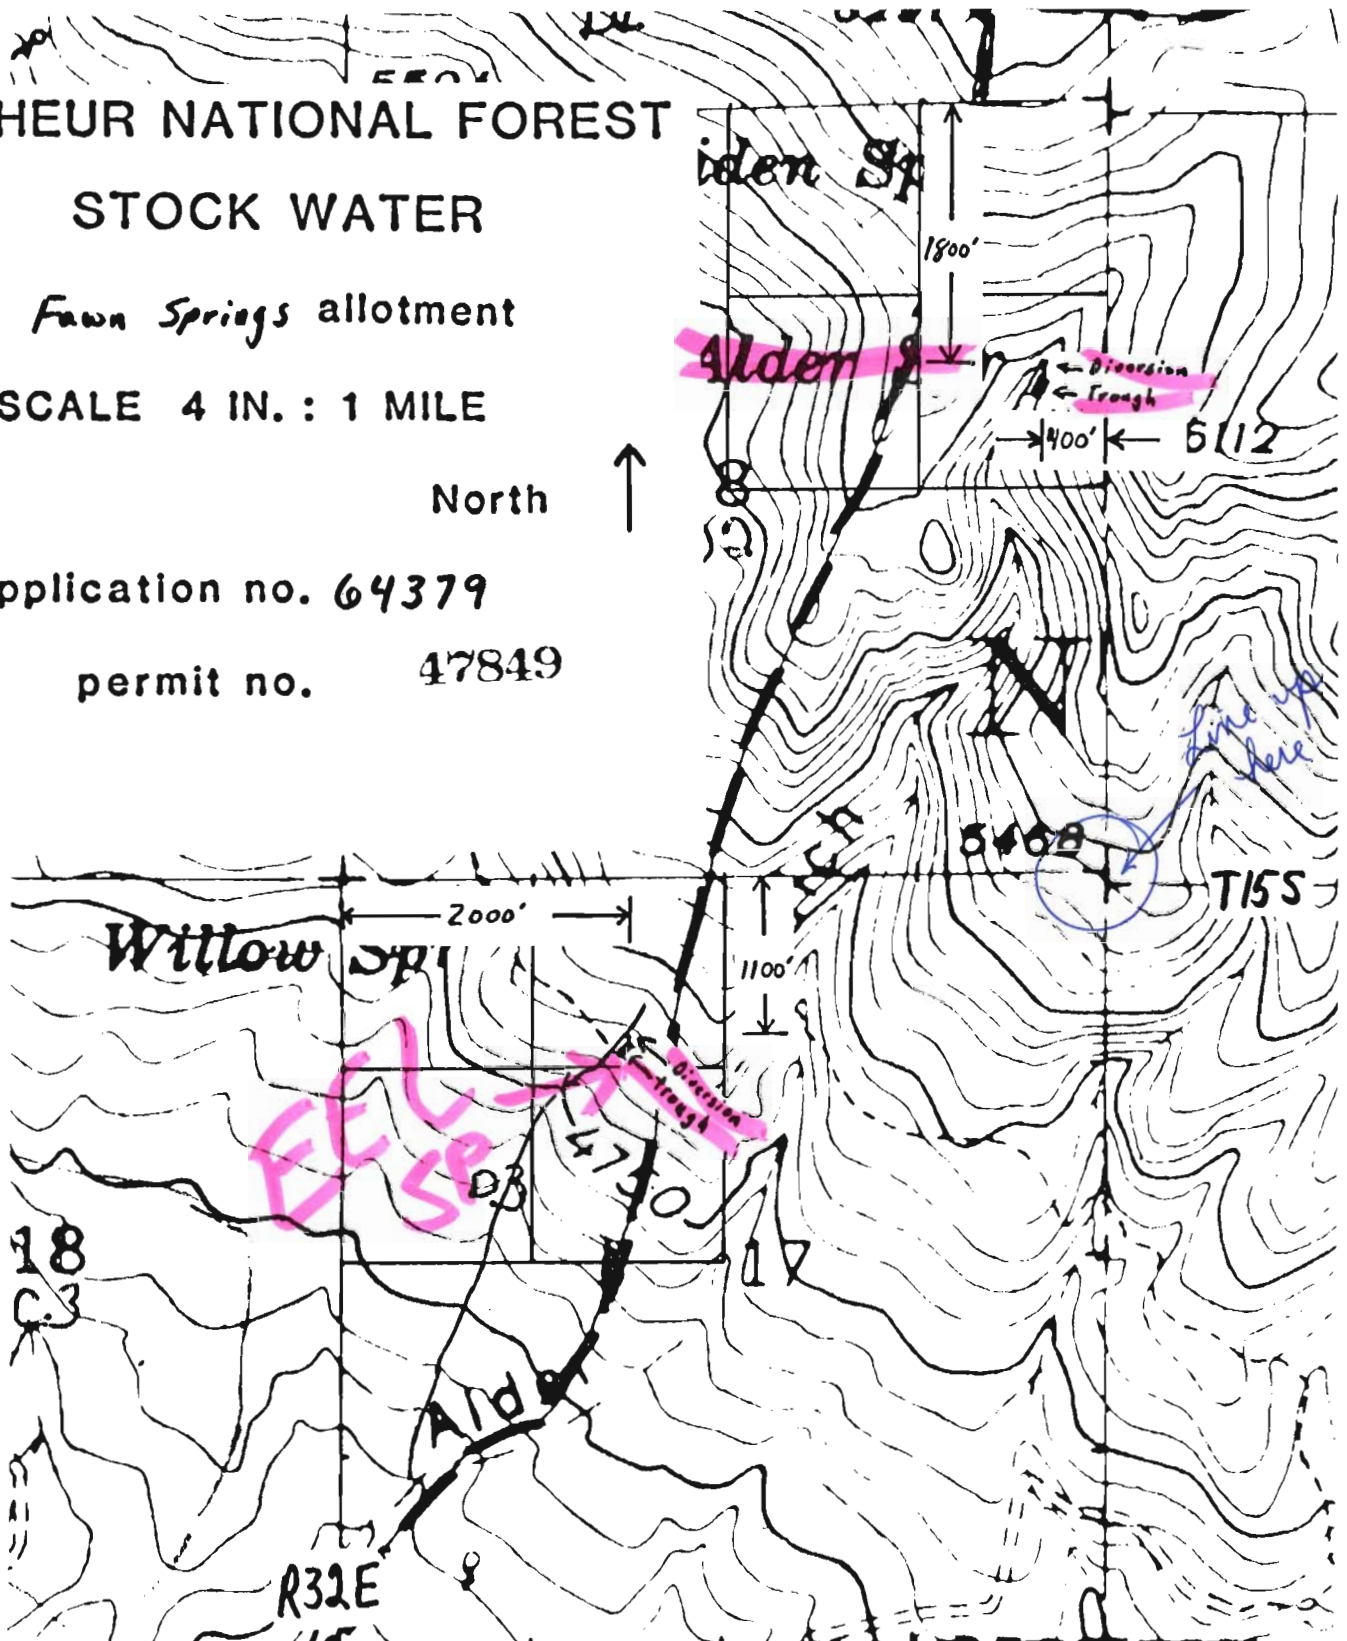

RECEIVED

MAY 3 1 1983

WATER RESOURCES DEPT.
SALEM, OREGON

COPY