MALHEUR NATIONAL FOREST

STOCK WATER (XJ)

RECEIVED
MAY 3 1 1983
WATER RESOURCES DEPT.
SALEM, OREGON

Murderer's allotment
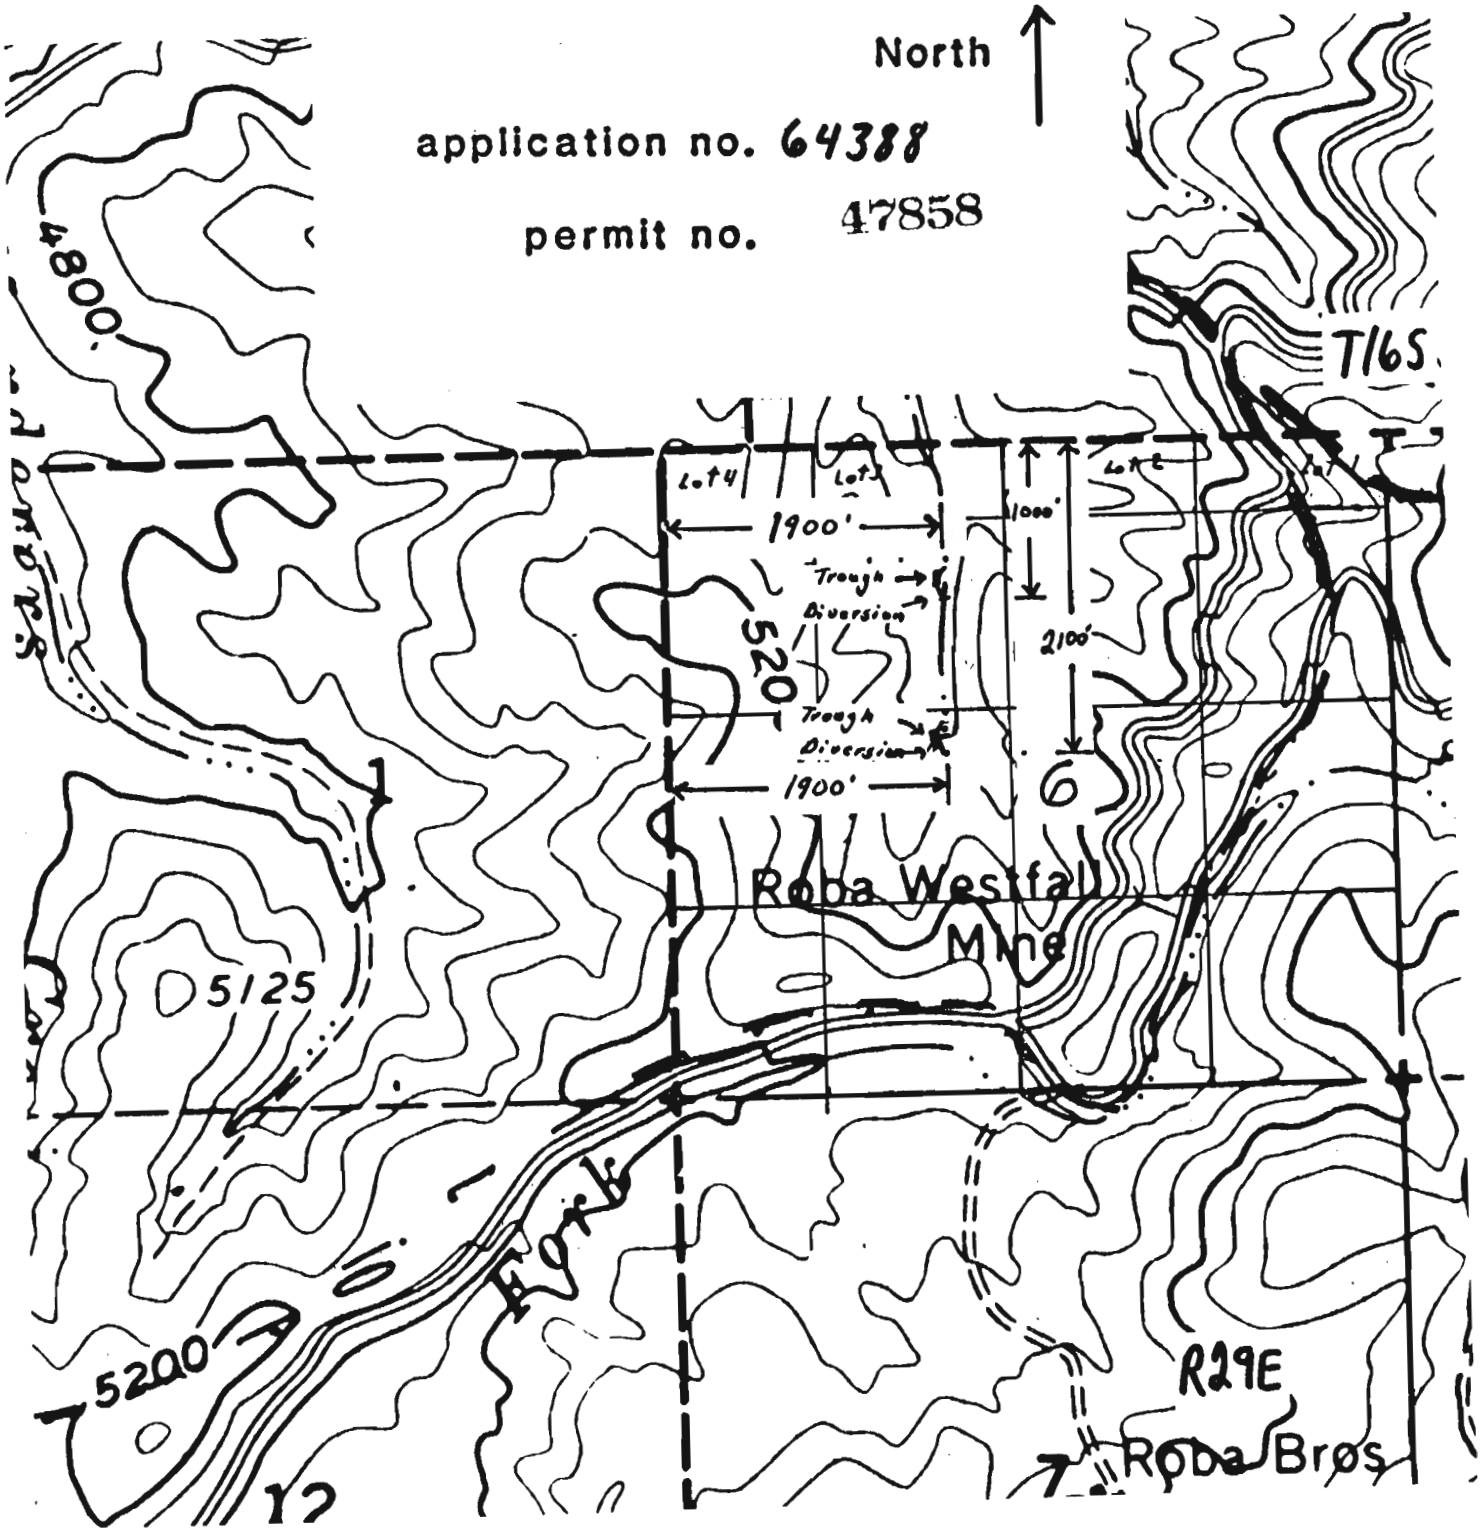
SCALE 4 IN. : 1 MILE