


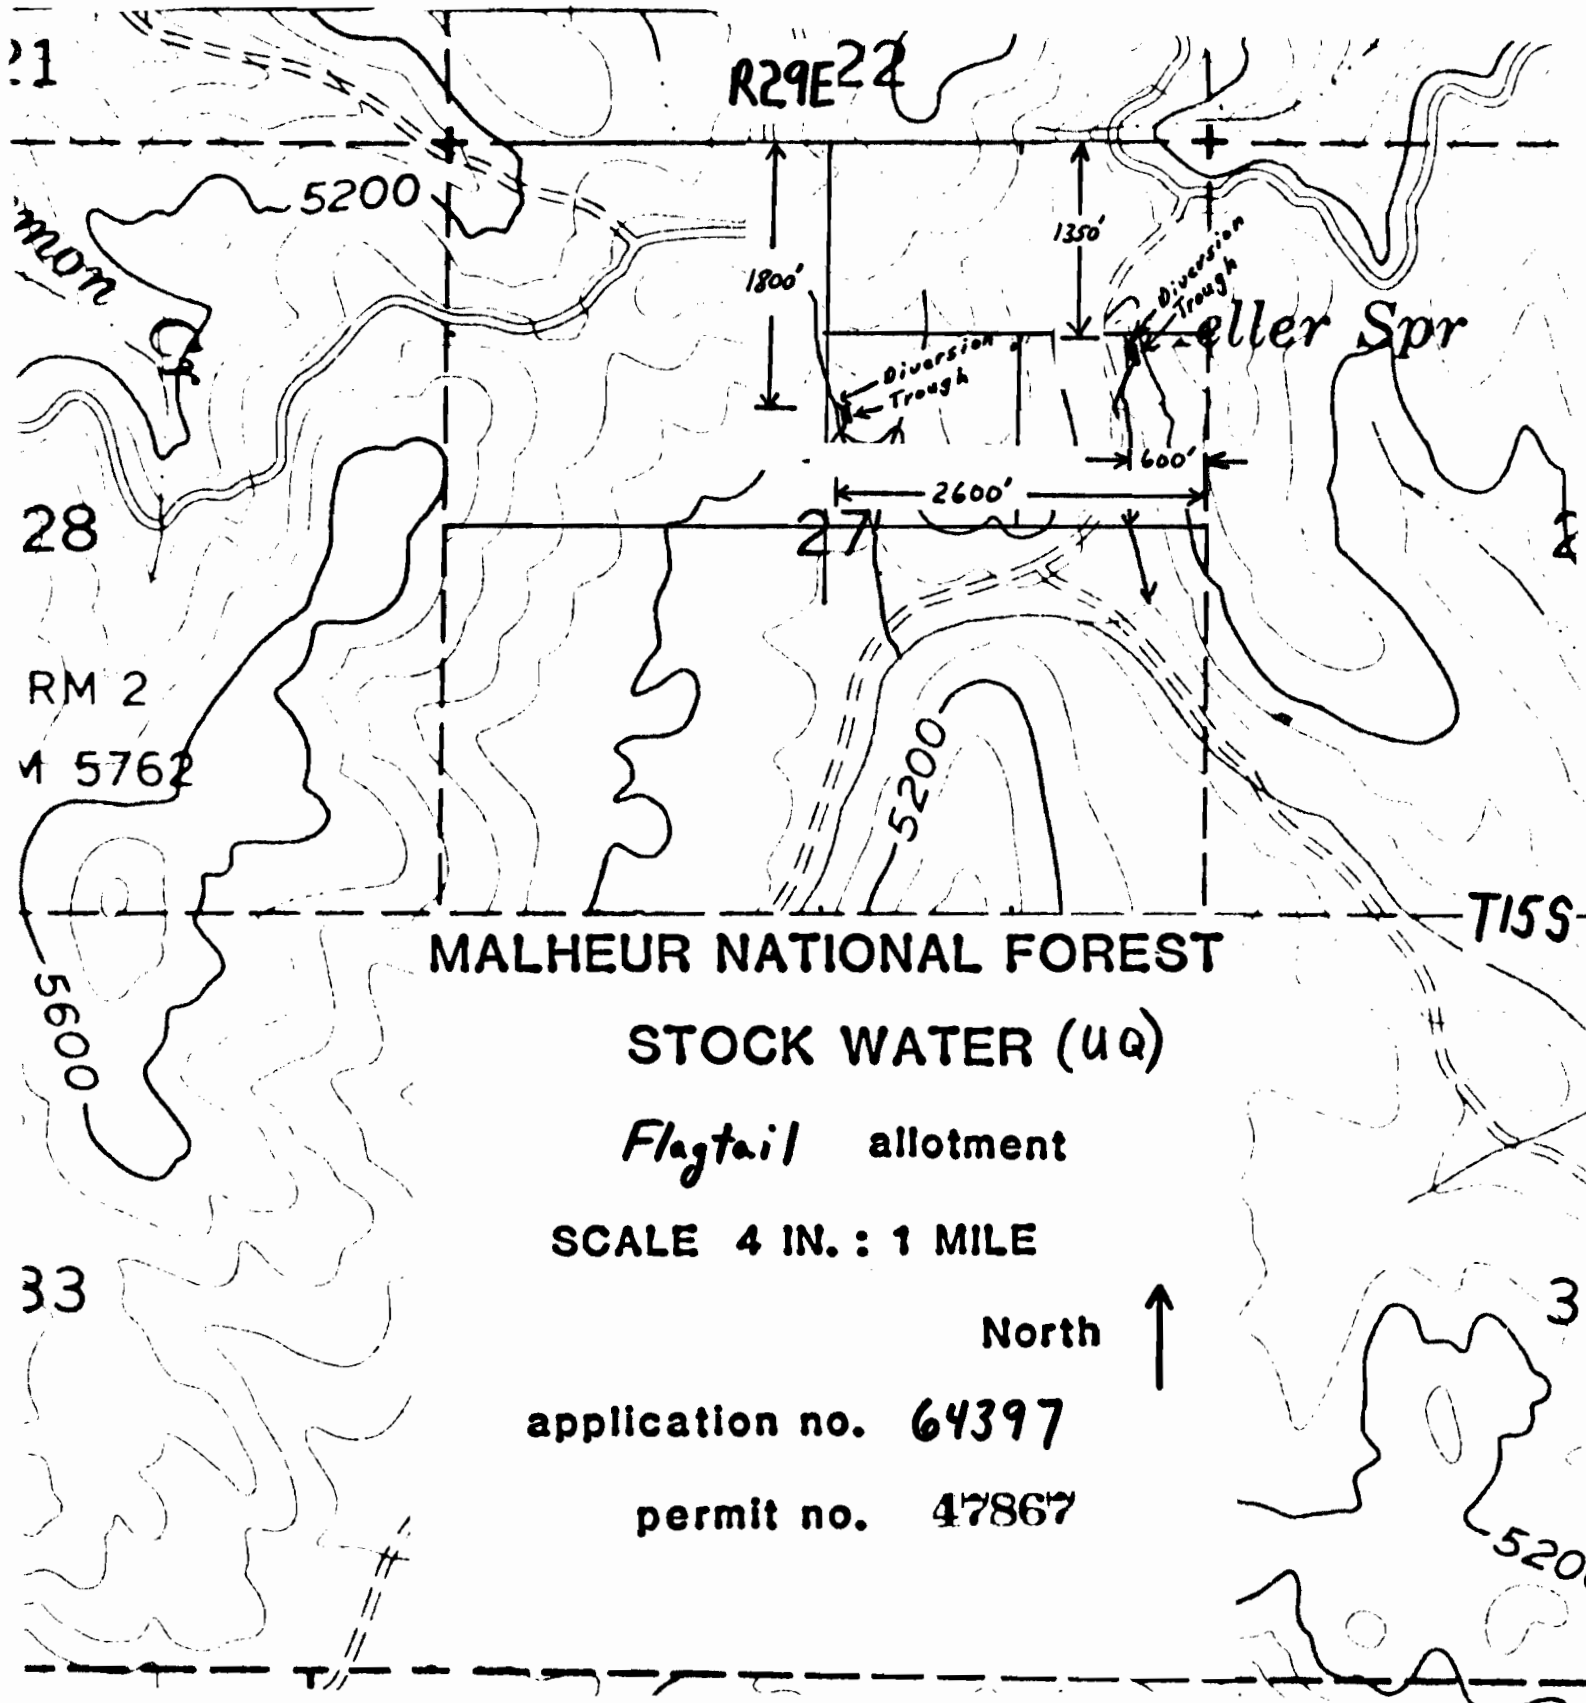

RECEIVED

MAY 3 1 1983

WATER RESOURCES DEPT.
SALEM, OREGON