


RECEIVED
MAY 31 1983
WATER RESOURCES DEPT.
SALEM, OREGON

R32E

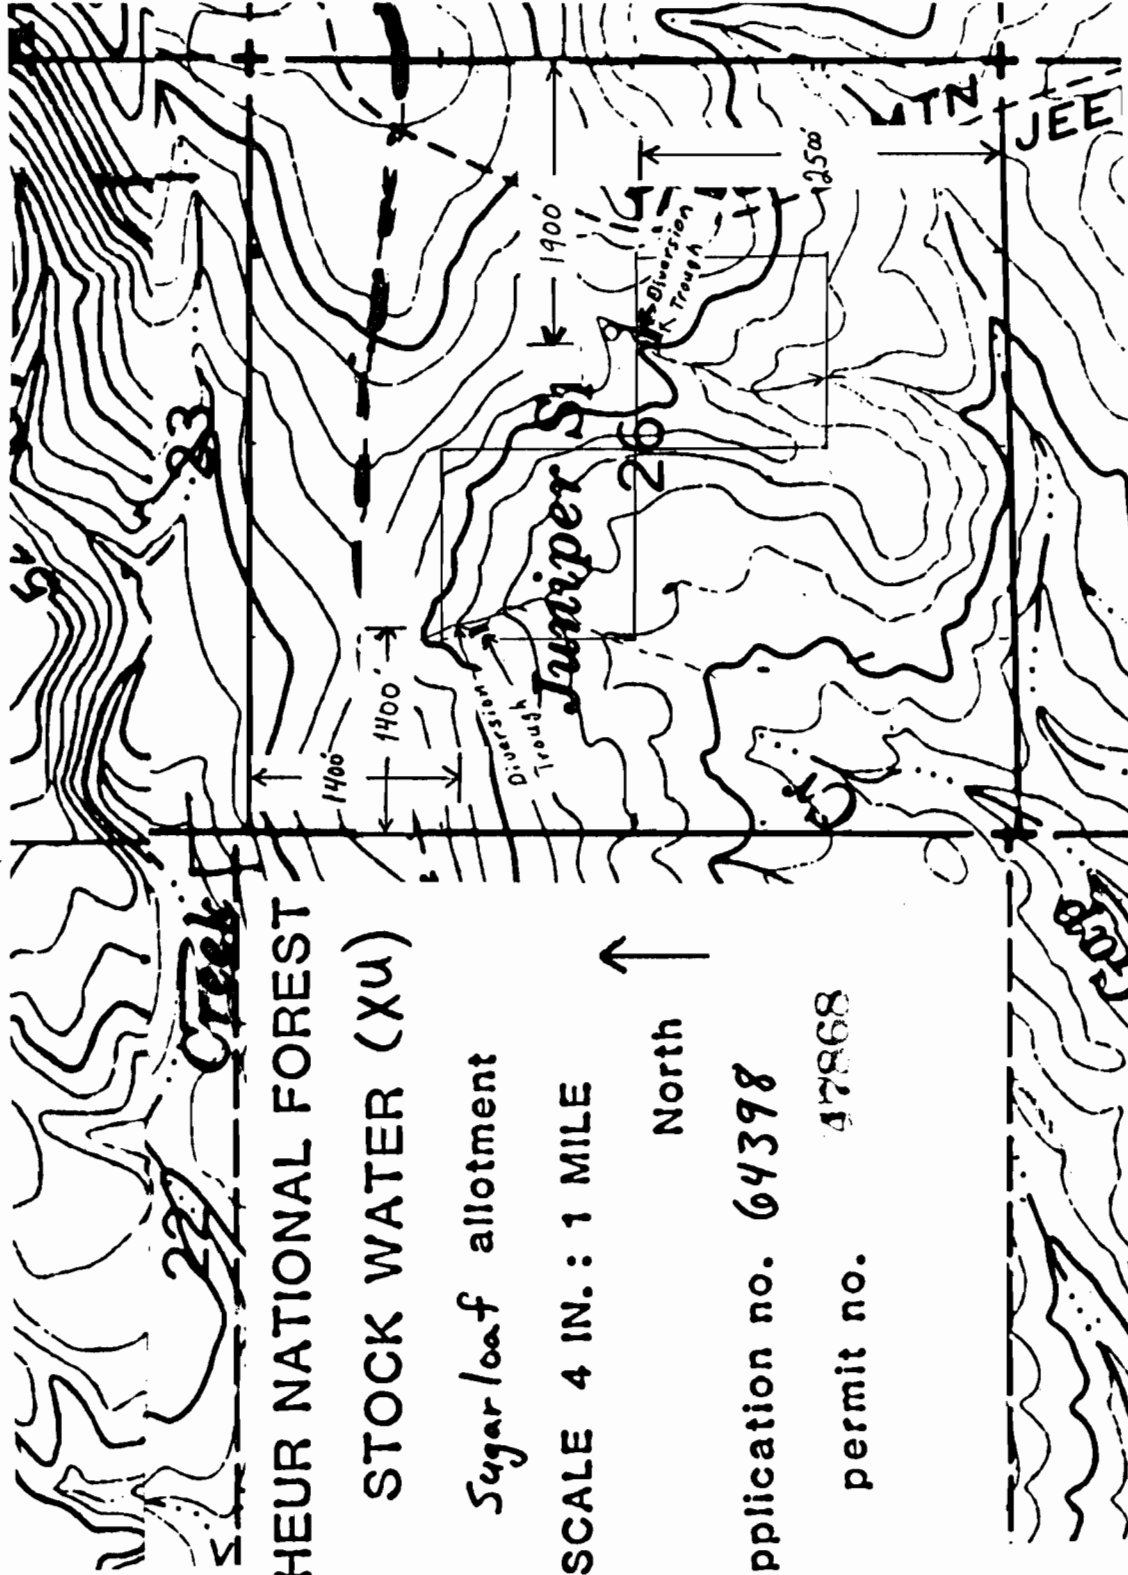

MALHEUR NATIONAL FOREST

STOCK WATER (Xu)

Sugarloaf allotment

SCALE 4 IN. : 1 MILE

North

application no. 64398

permit no. 47868