
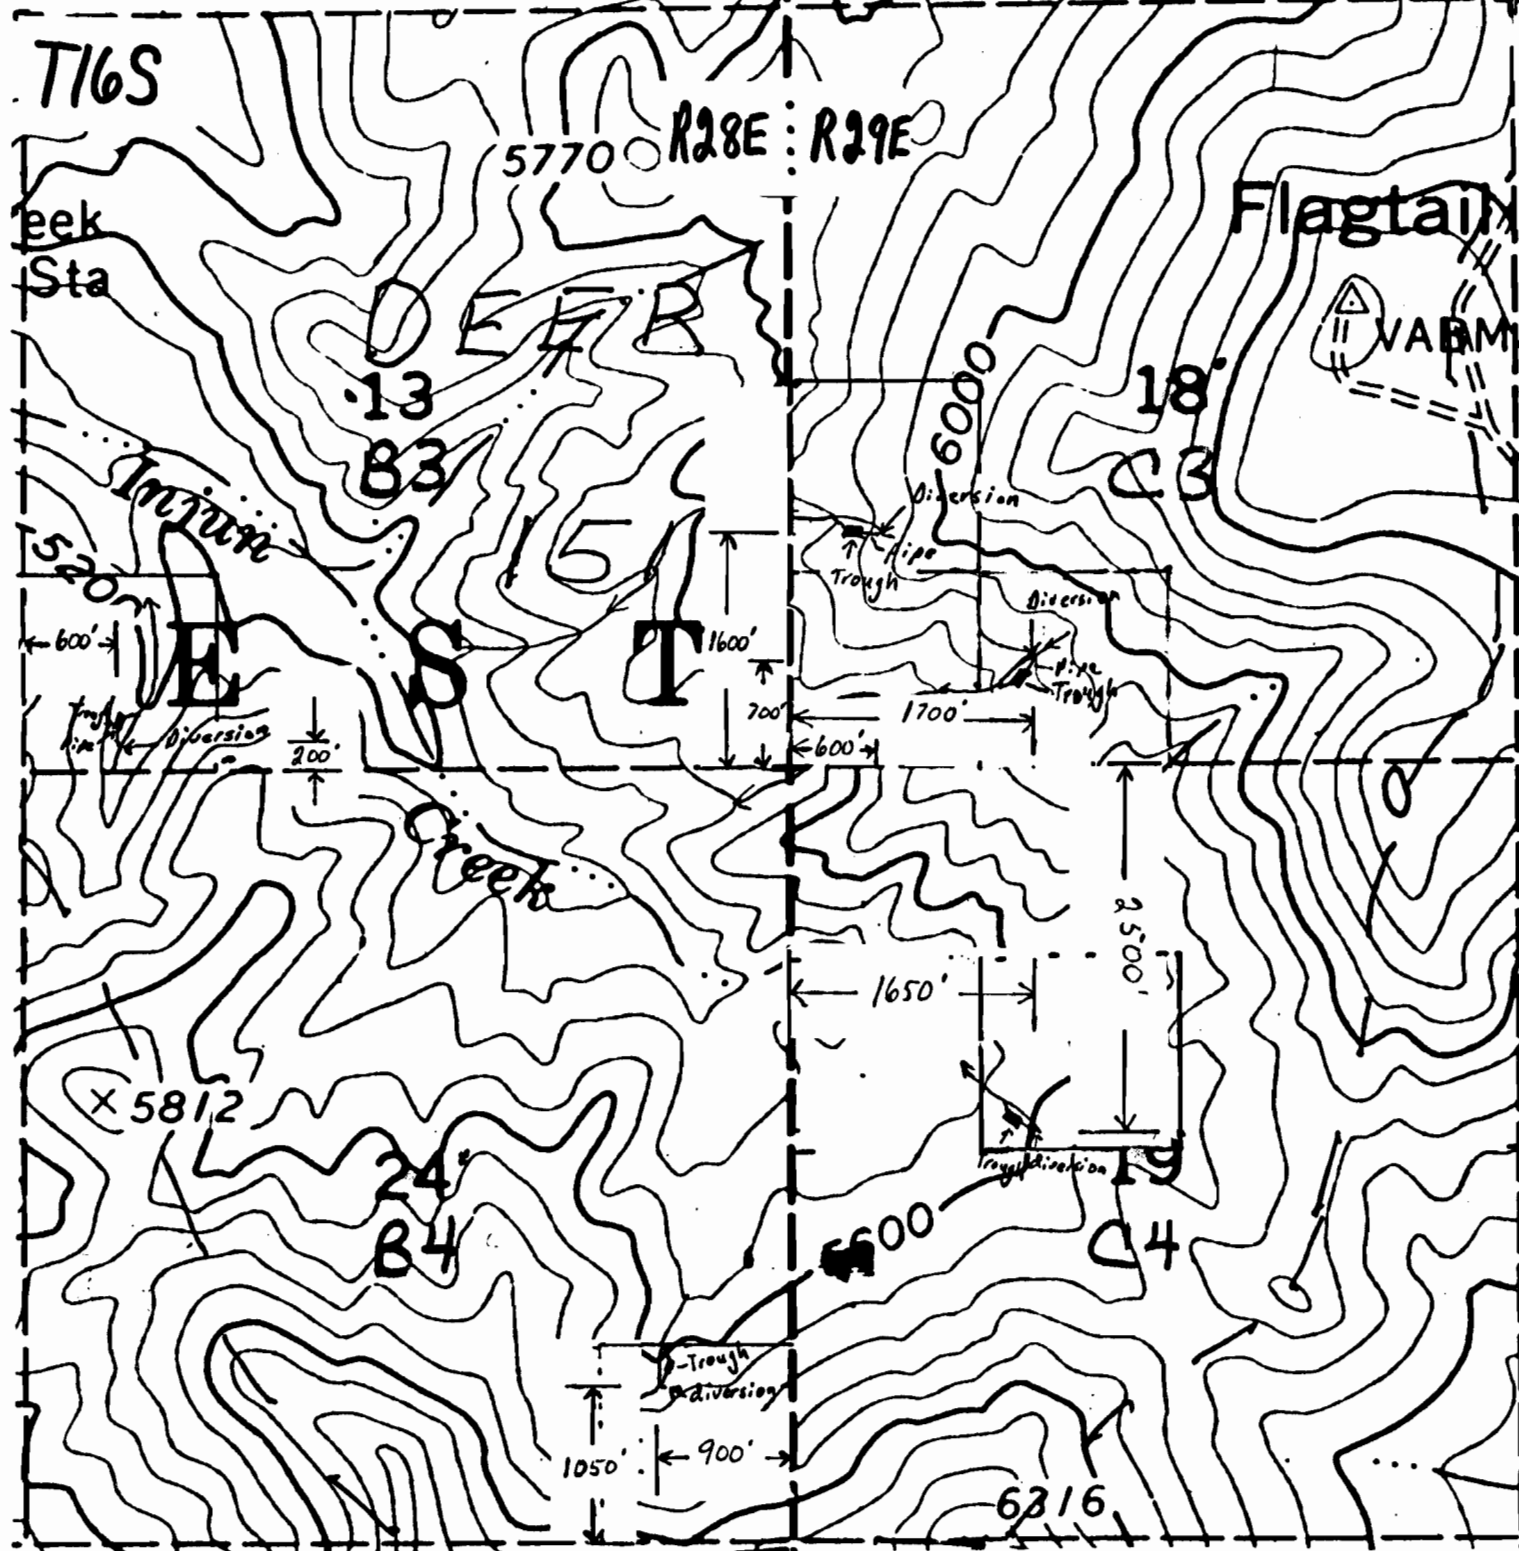


RECEIVED

MAY 31 1983

**WATER RESOURCES DEPT.
SALEM, OREGON**

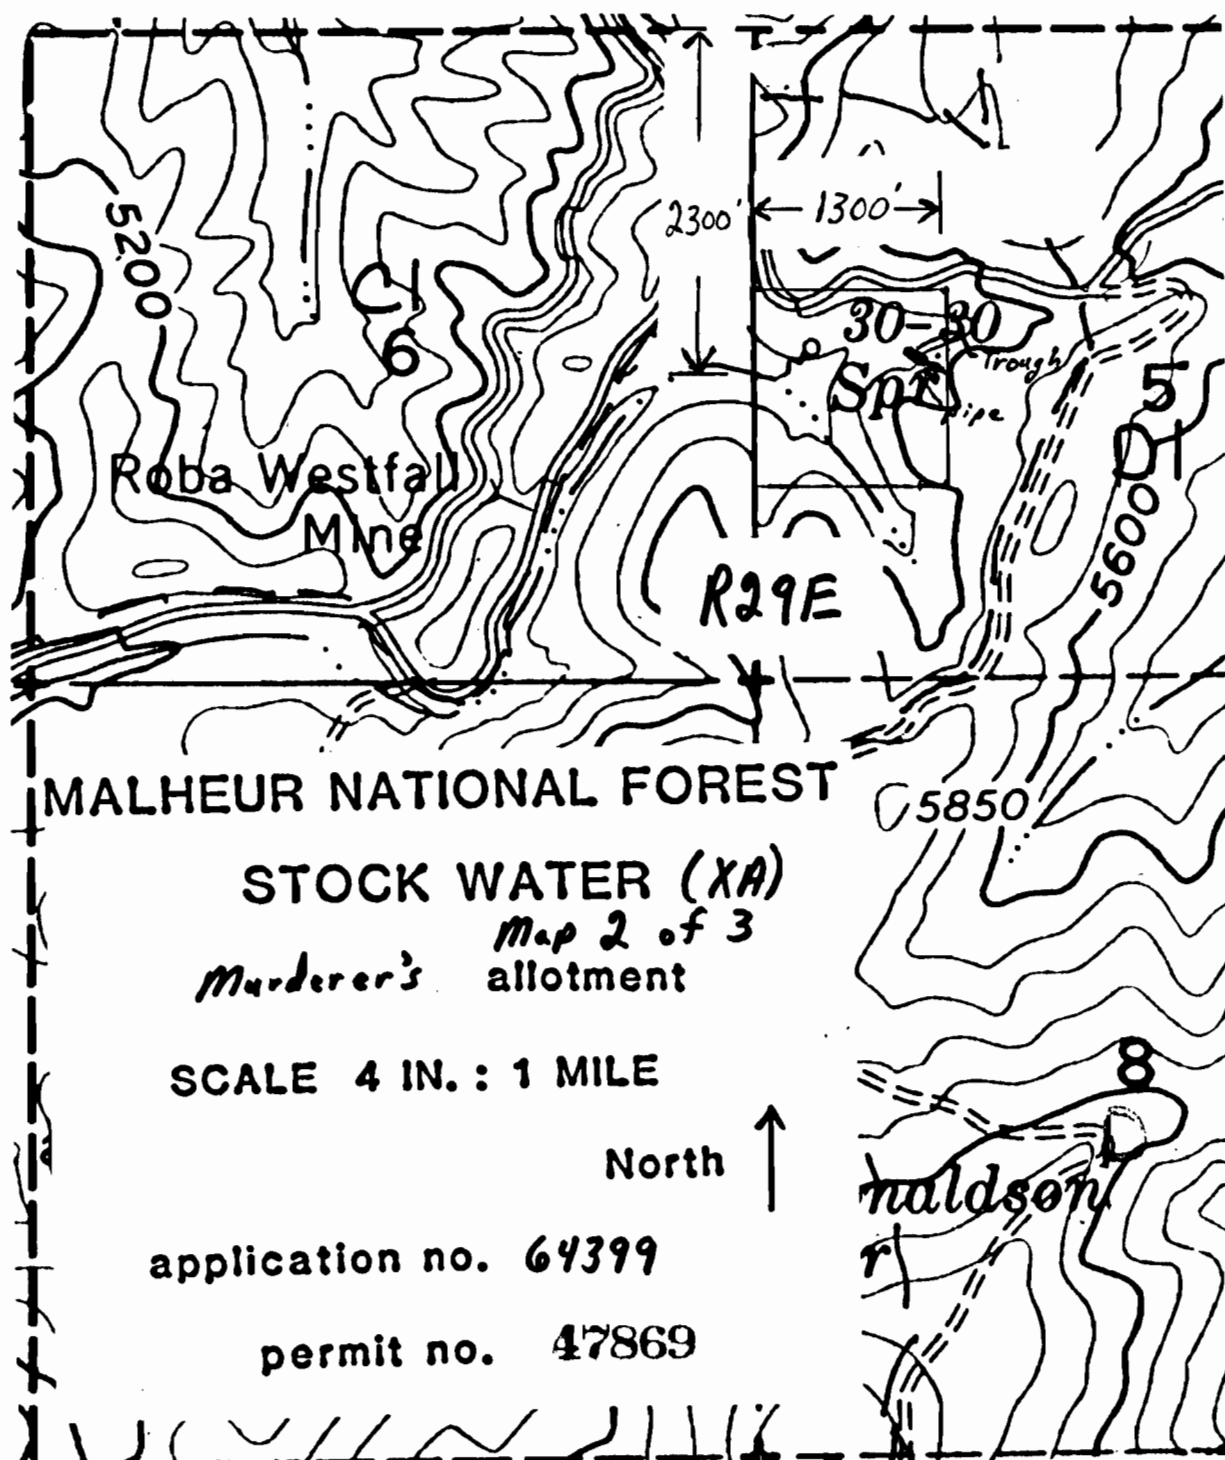

MALHEUR NATIONAL FOREST

STOCK WATER (XA)


Murderer's allotment

SCALE 4 IN. : 1 MILE

T16S R28E

North ↑

application no. 64399

permit no. 47869

