

MALHEUR NATIONAL FOREST

STOCK WATER SW-24


allotment

Tp. 12S, R 33E ROUNDTOP
SCALE 4 IN. : 1 MILE

North

application no. 62868

permit no. 49004

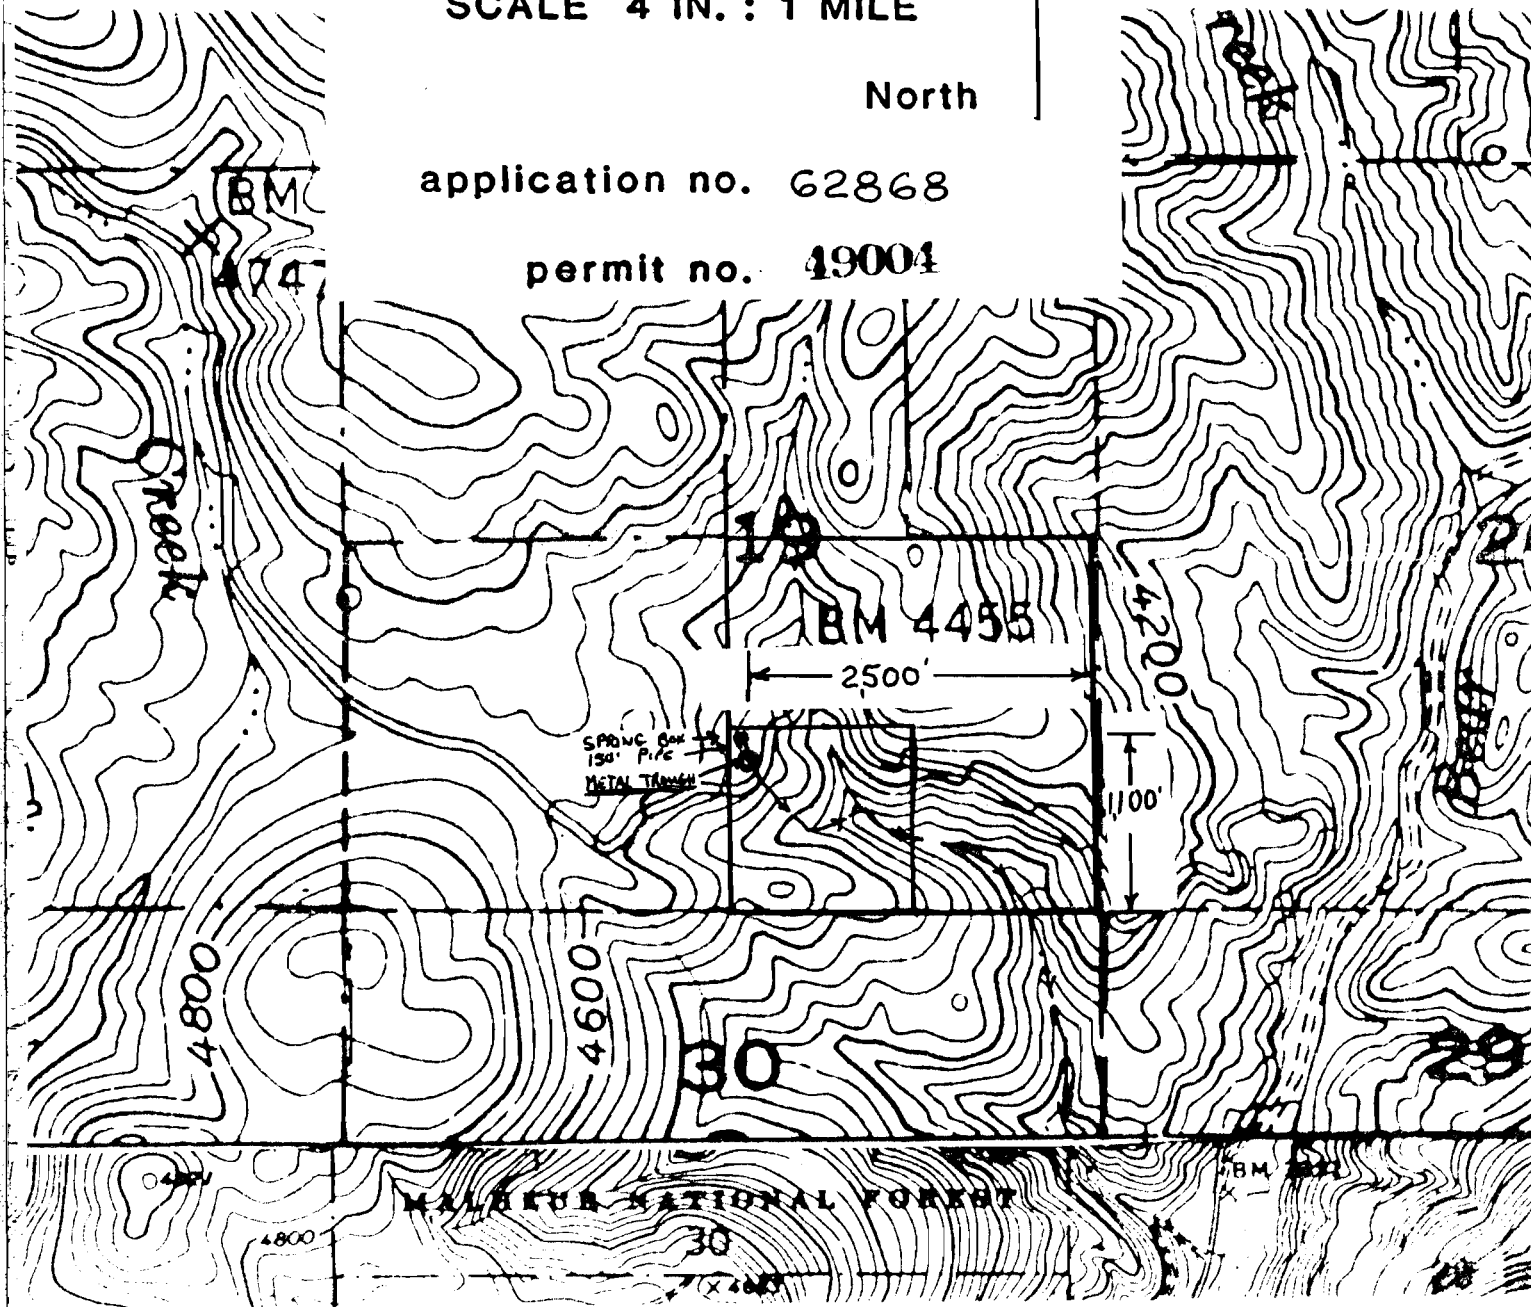

RECEIVED

JUL 13 1983

WATER RESOURCES DEPT. WATER RESOURCES DEPT.
SALEM, OREGON

RECEIVED

JUN 15 1983

SALEM, OREGON