

MALHEUR NATIONAL FOREST

STOCK WATER SW-28

Tp 12s R33E
Sec. 19

allotment


ROUND TOP

SCALE 4 IN. : 1 MILE

North ↑

application no. 62869

permit no. 49005

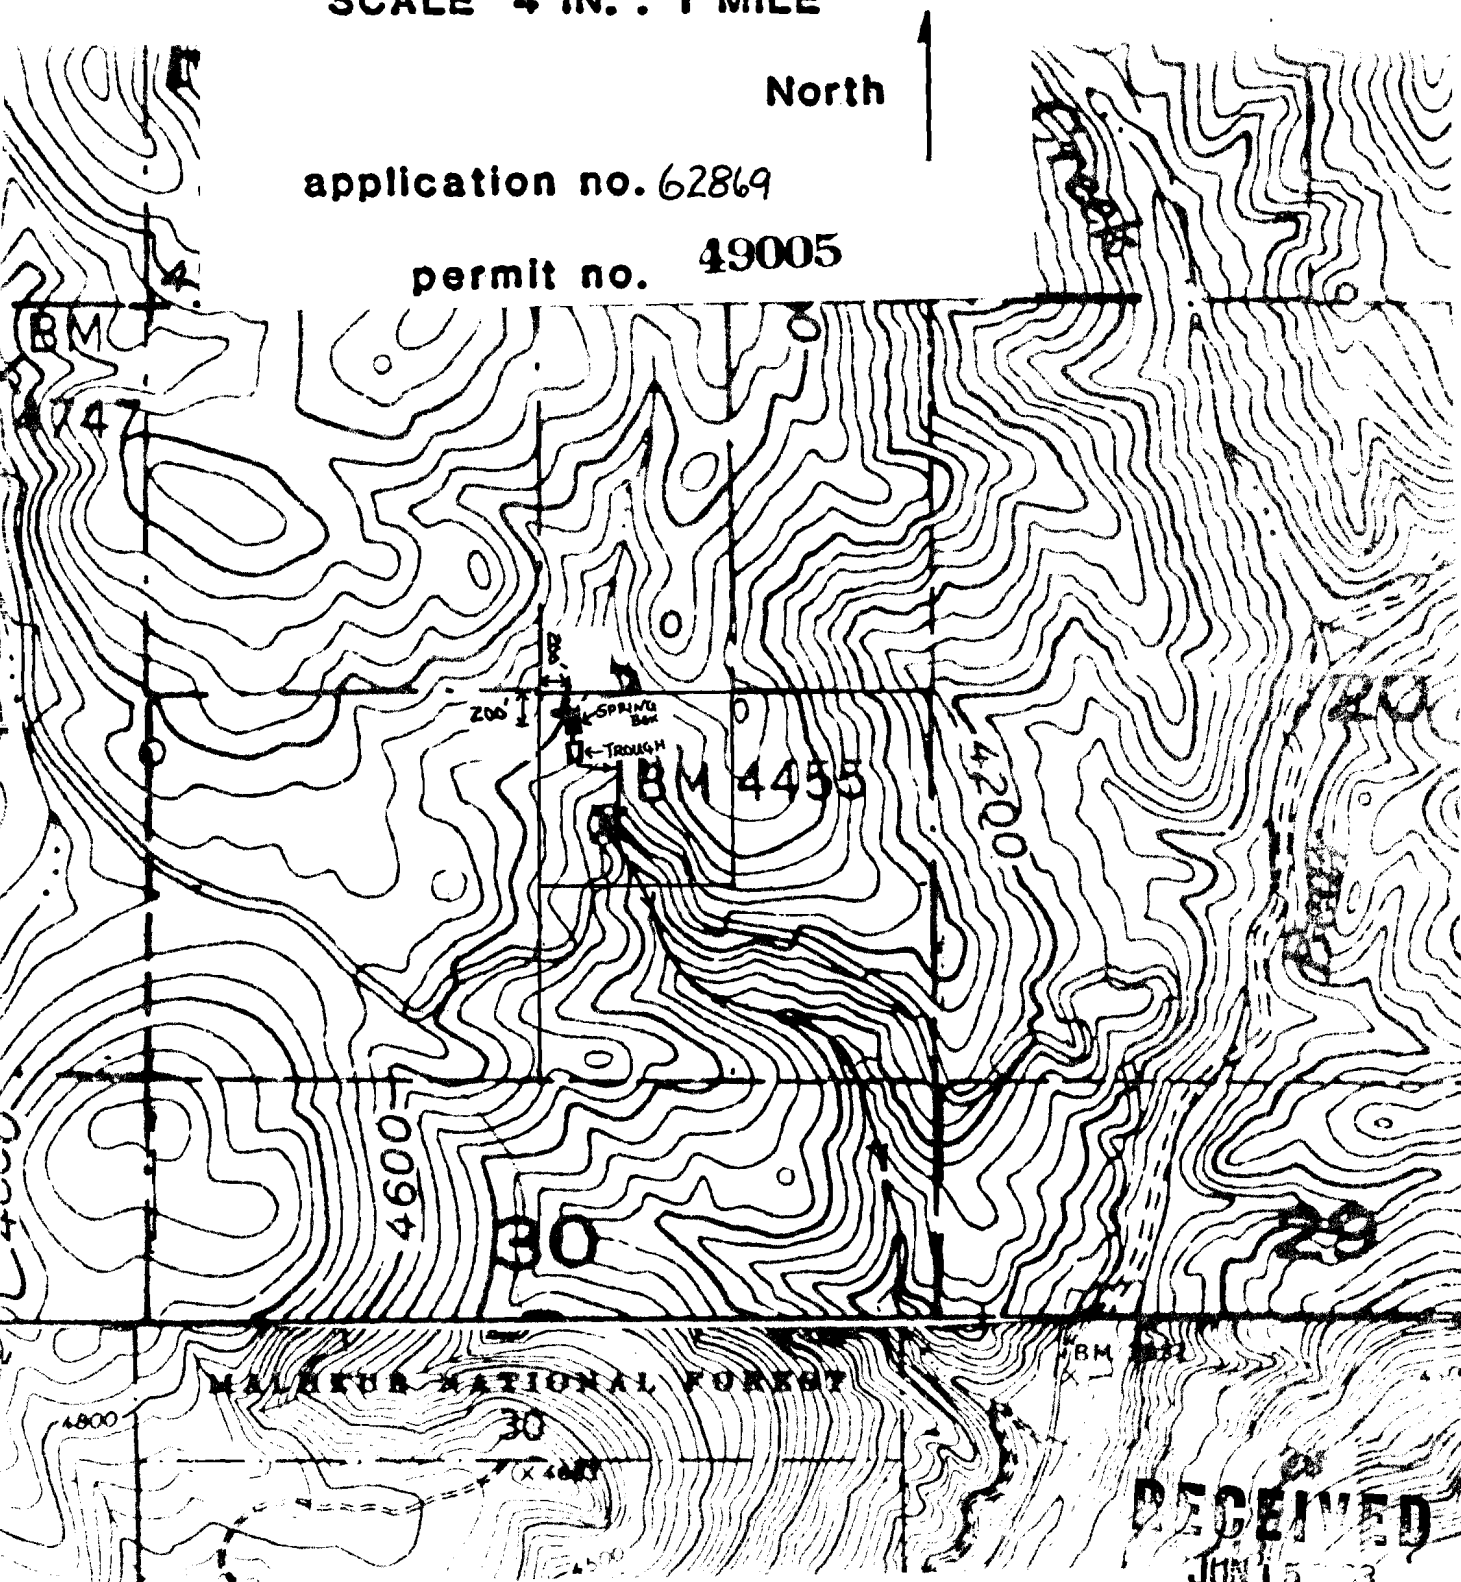

RECEIVED
JUN 15 1963

WATER RESOURCES DEPT.
SALEM, OREGON