

MALHEUR NATIONAL FOREST

STOCK WATER SW-32

Tp12S R32E

allotment


Roundtop

SCALE 4 IN. : 1 MILE

North

application no. 62871

permit no. 49007

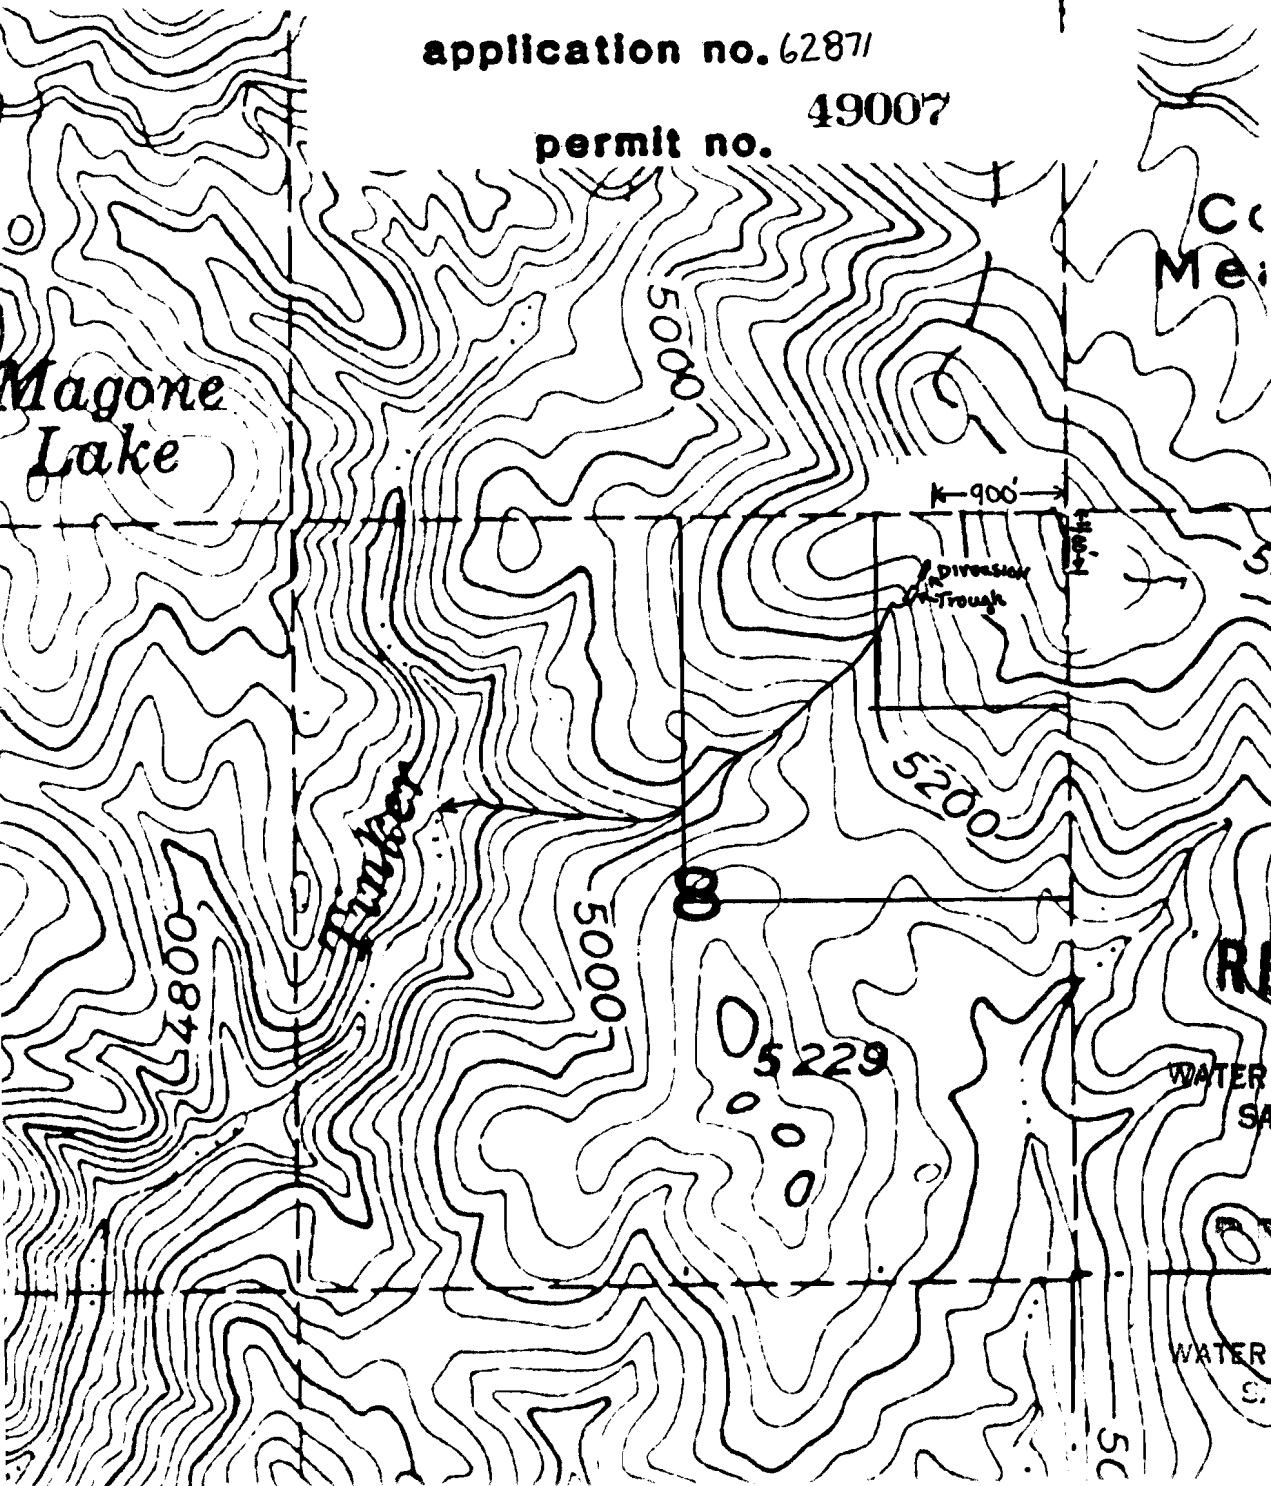

RECEIVED

JUL 13 1983

WATER RESOURCES DEPT.
SALEM, OREGON

RECEIVED

JUN 15 1983

WATER RESOURCES DEPT.
SALEM, OREGON