

MALHEUR NATIONAL FOREST

STOCK WATER SW-34

allotment


Tp 12S, R32E ROUNDTOP
SCALE 4 IN. : 1 MILE

North

application no. 62872

permit no. 49008

Copy

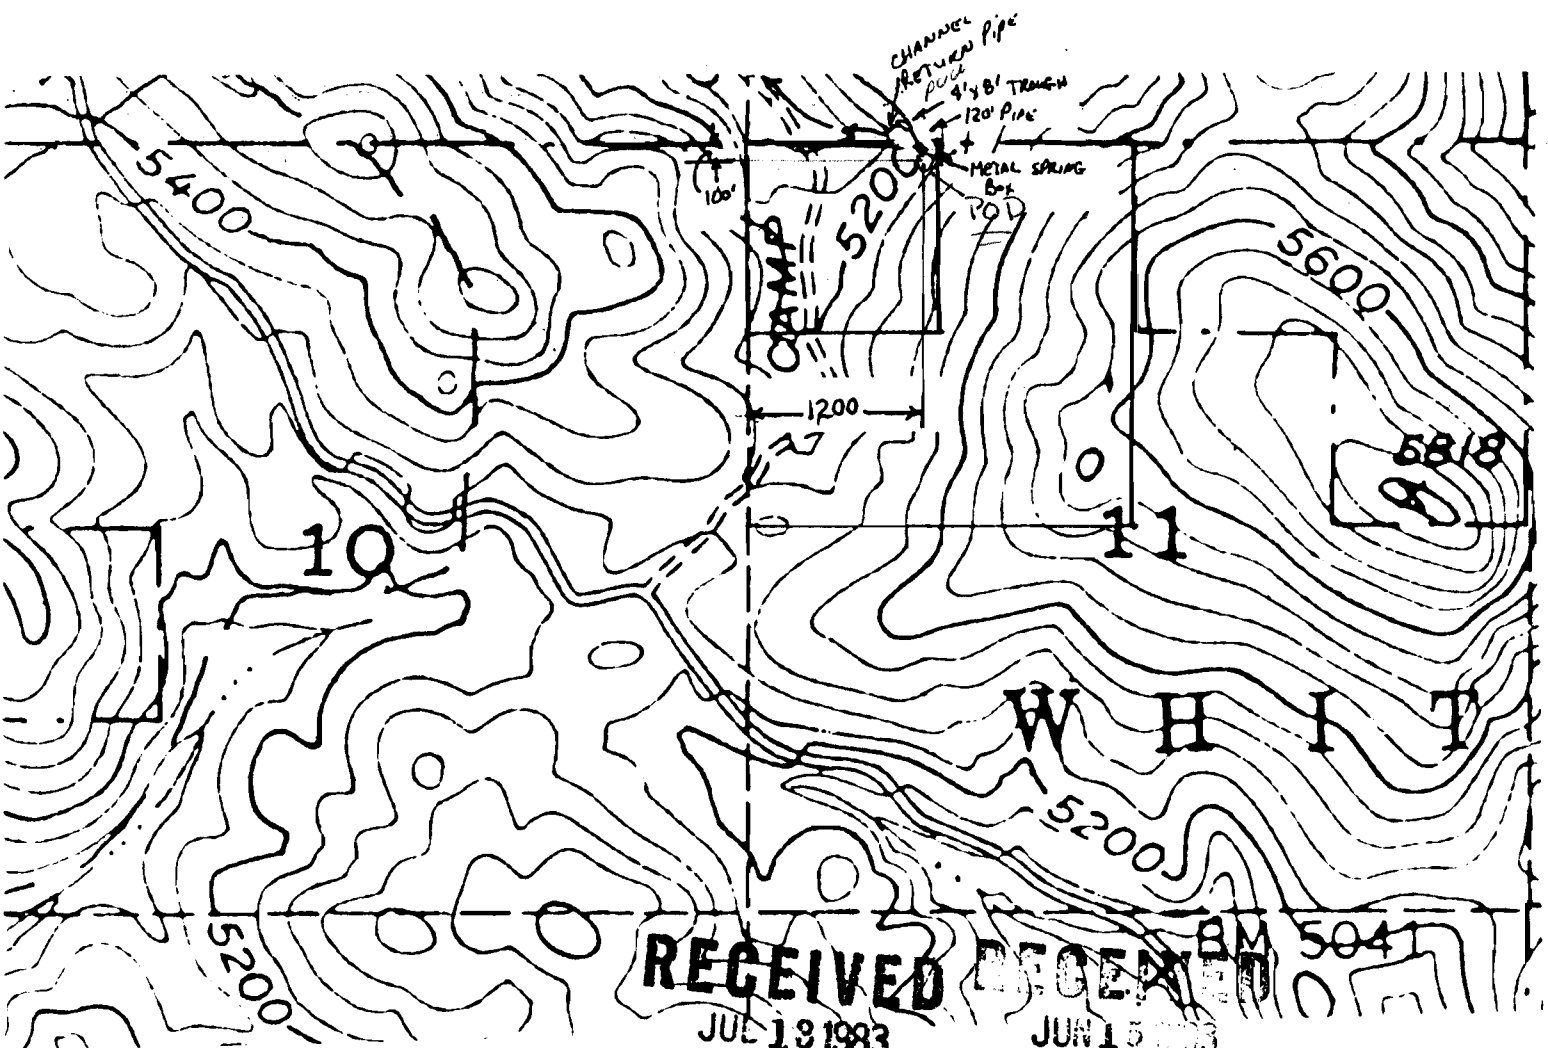

RECEIVED **DECEMBER** **BM 5041**
JUL 13 1983 JUN 15 1983
WATER RESOURCES DEPT. WATER RESOURCES DEPT.
SALEM, OREGON SALEM, OREGON