

875

MALHEUR NATIONAL FOREST

FOREST

STOCK WATER SW-7


TW 10S Rng 32E allotment
SLIDE CREEK

SCALE 4 IN. : 1 MILE

North

application no. ~~62002~~ 62893

permit no. 49010

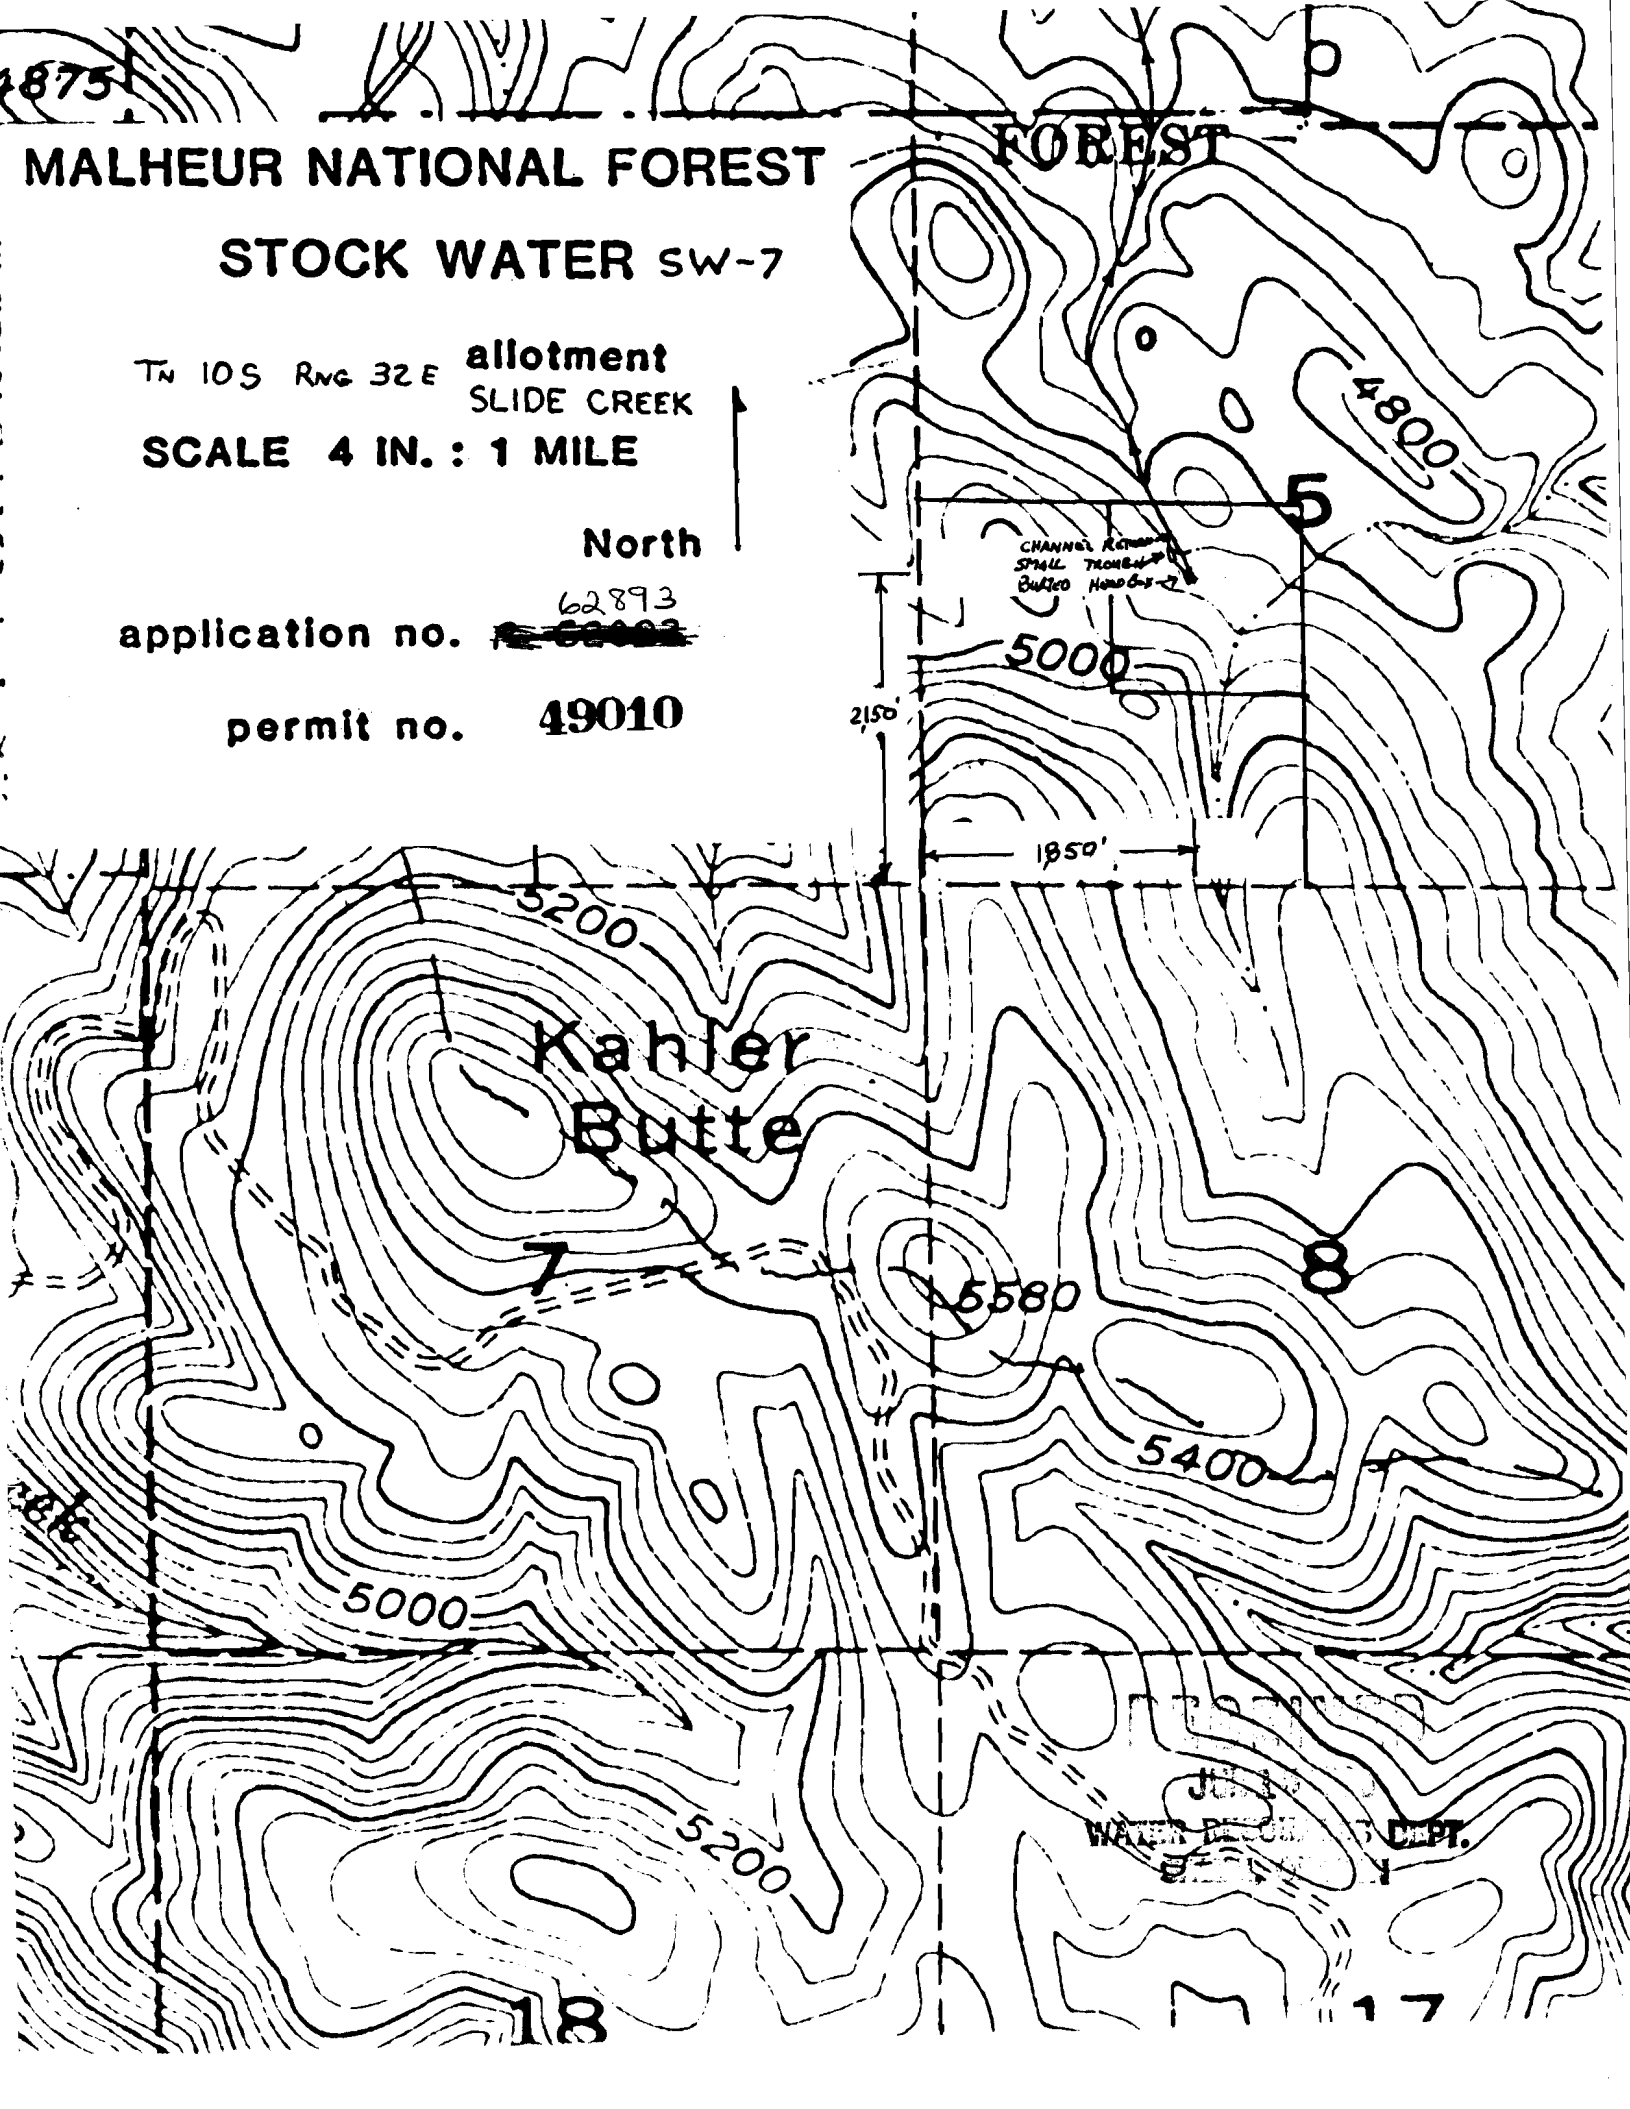

CHANNEL RECONSTRUCTION

Kahler Butte

WATER DEPT.