


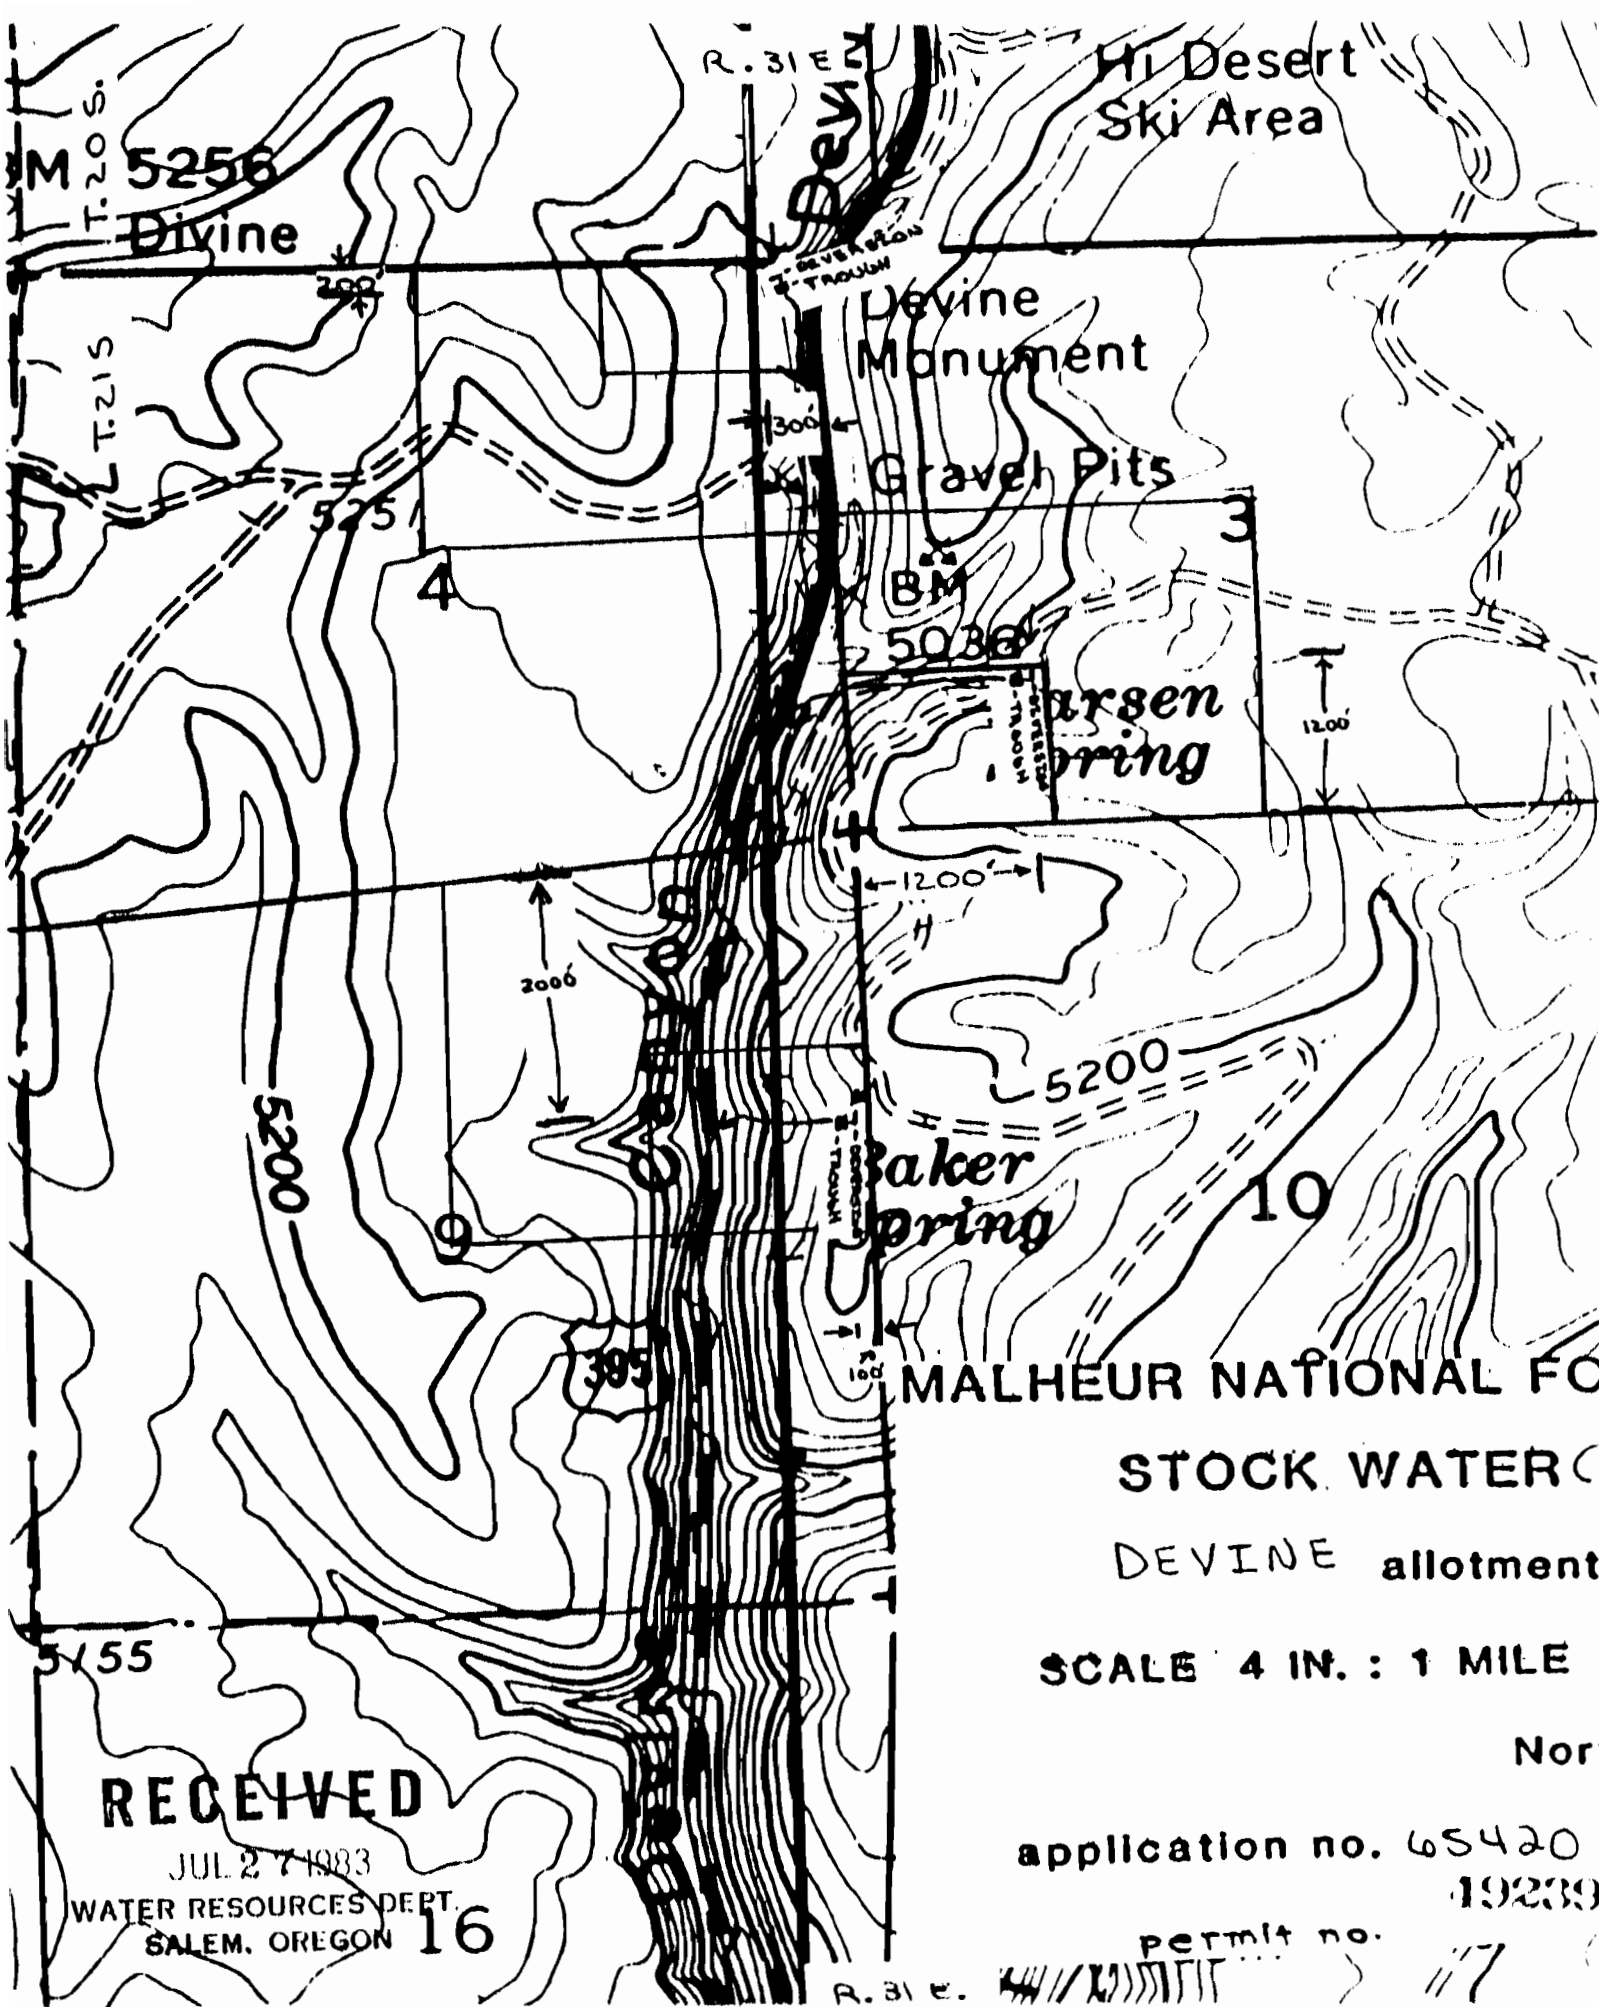

Hi Desert
Ski Area

M 5256
Divine

Devine
Monument

Gravel Pits

B.M.
50364

Arsen
Spring

Baker
Spring

MALHEUR NATIONAL FO

STOCK WATER C

DEVINE allotment

SCALE 4 IN. : 1 MILE

Nor

application no. 65420

19239

permit no.

R.31 E.

RECEIVED

JUL 27 1983

WATER RESOURCES DEPT.
SALEM, OREGON

16