


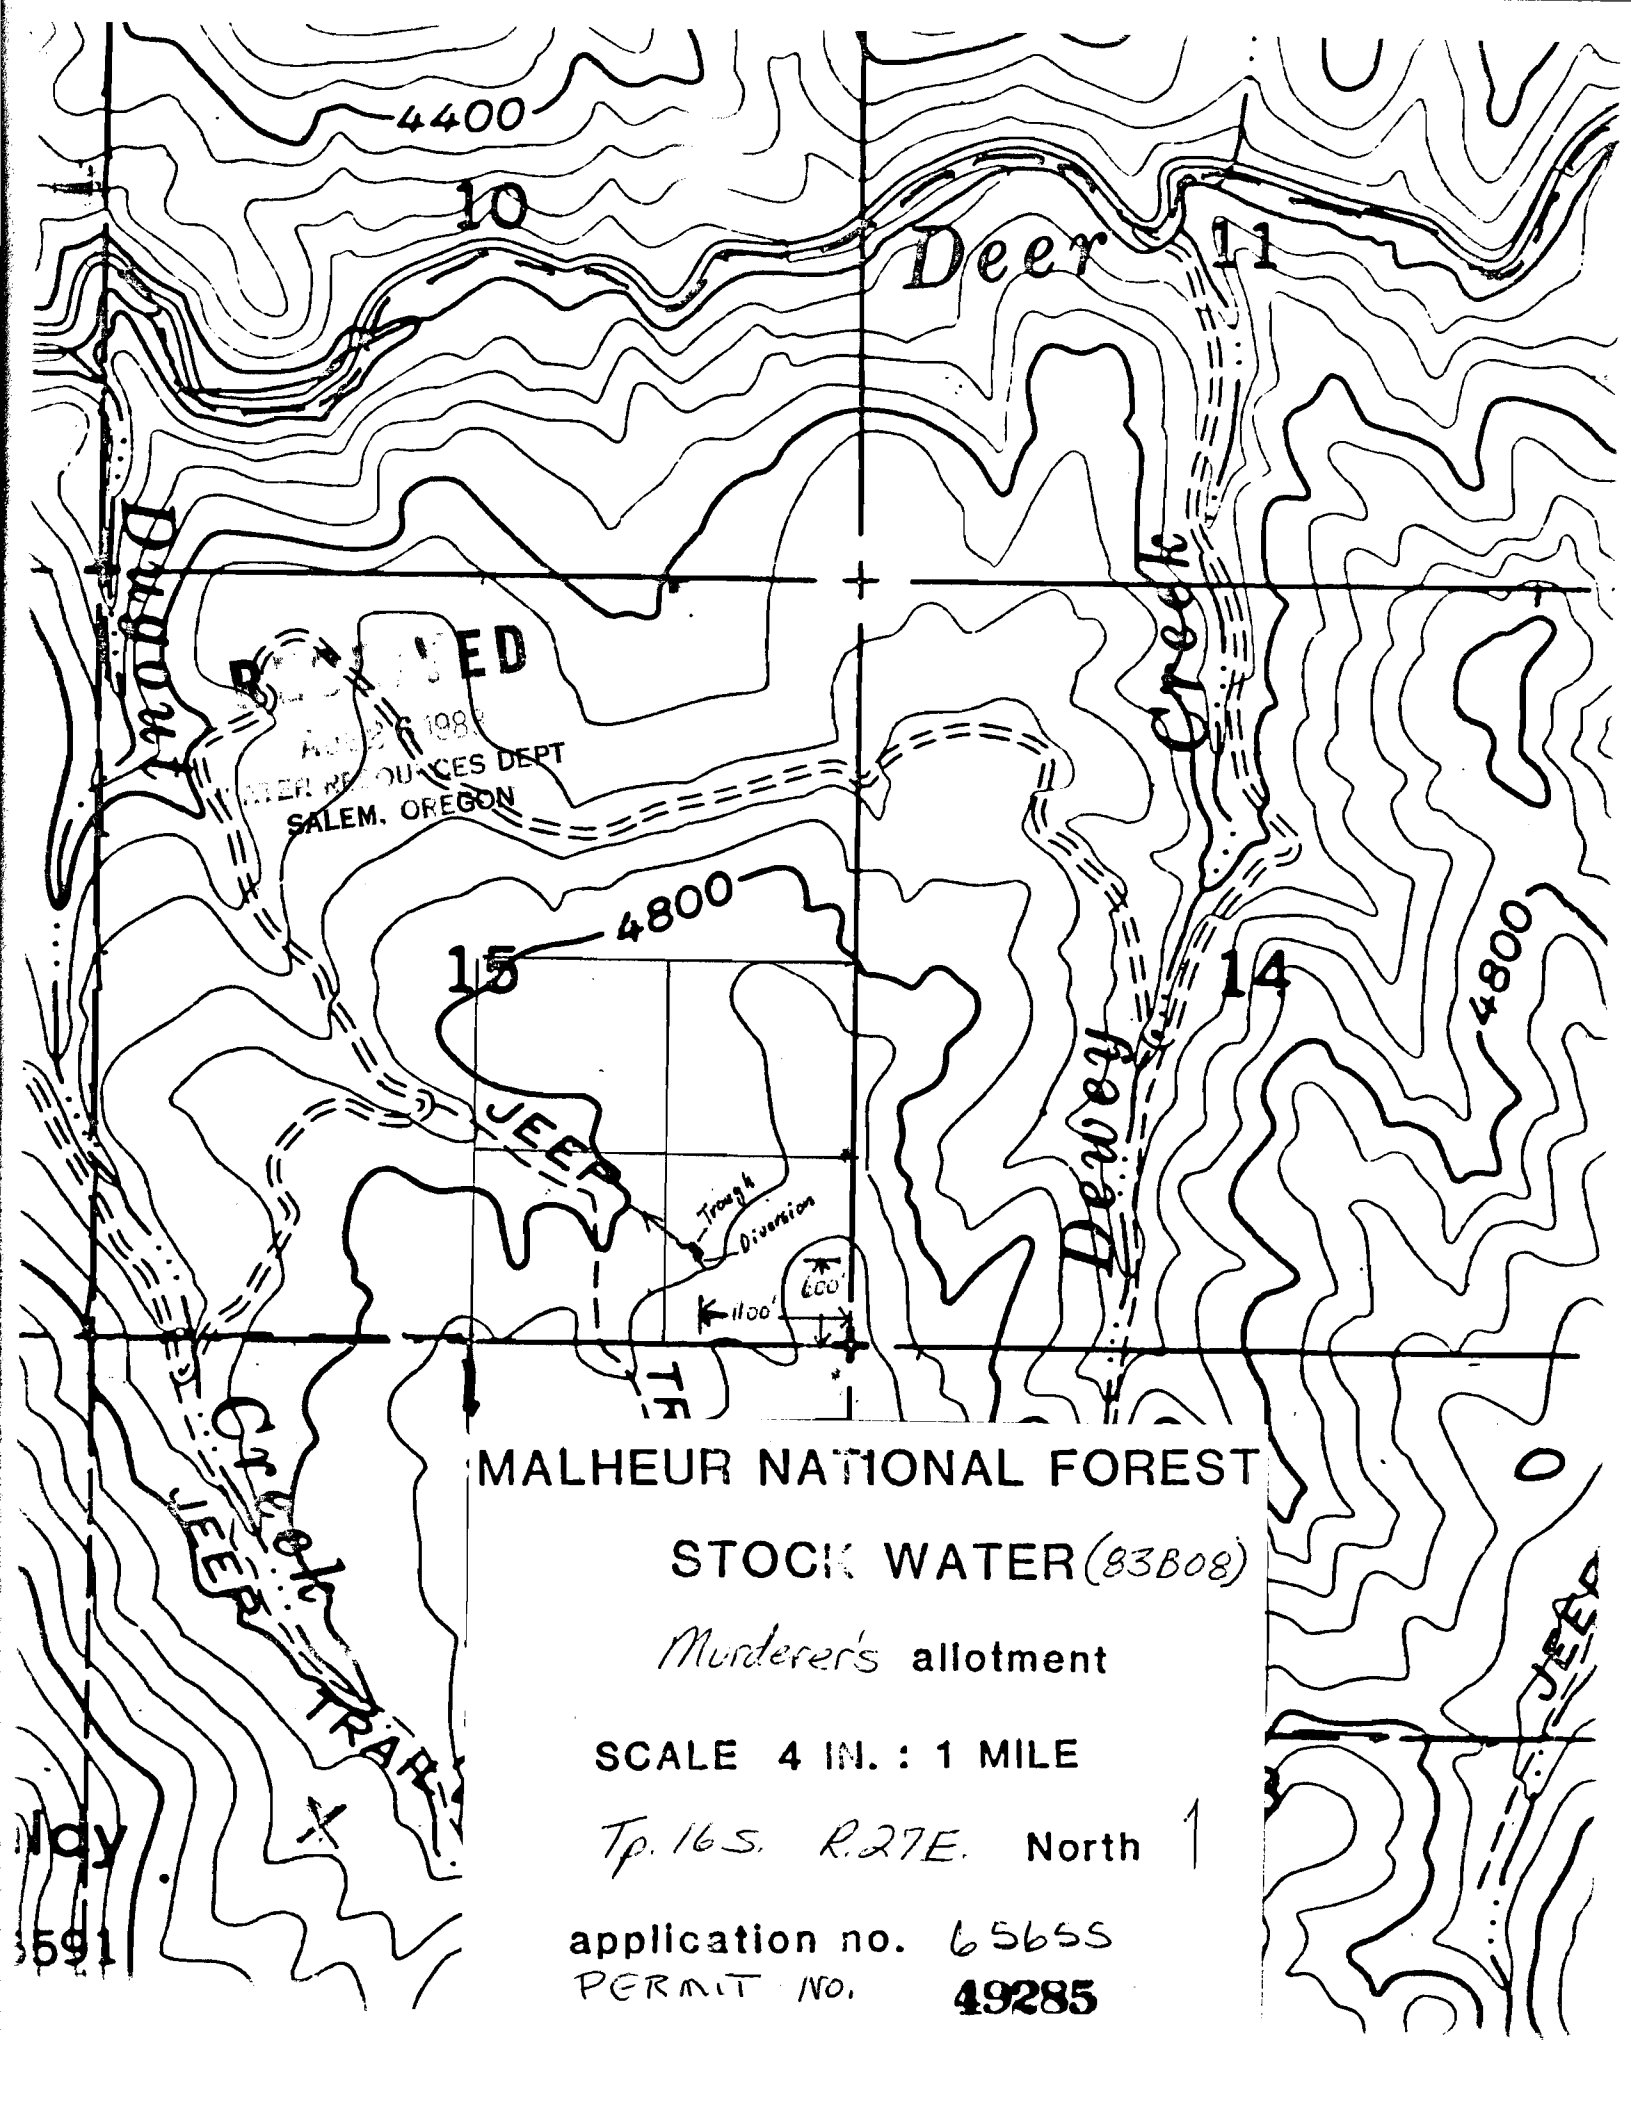

4400

10

Deer

11

Creek

RECEIVED

AUG 26 1980
WATER RESOURCES DEPT
SALEM, OREGON

4800

15

14

4800


Trough
Diversion

1100'

600'

MALHEUR NATIONAL FOREST

STOCK WATER (83B08)

Murderer's allotment

SCALE 4 IN. : 1 MILE

Tp. 16S. R. 27E. North

application no. 65655

PERMIT NO. 49285