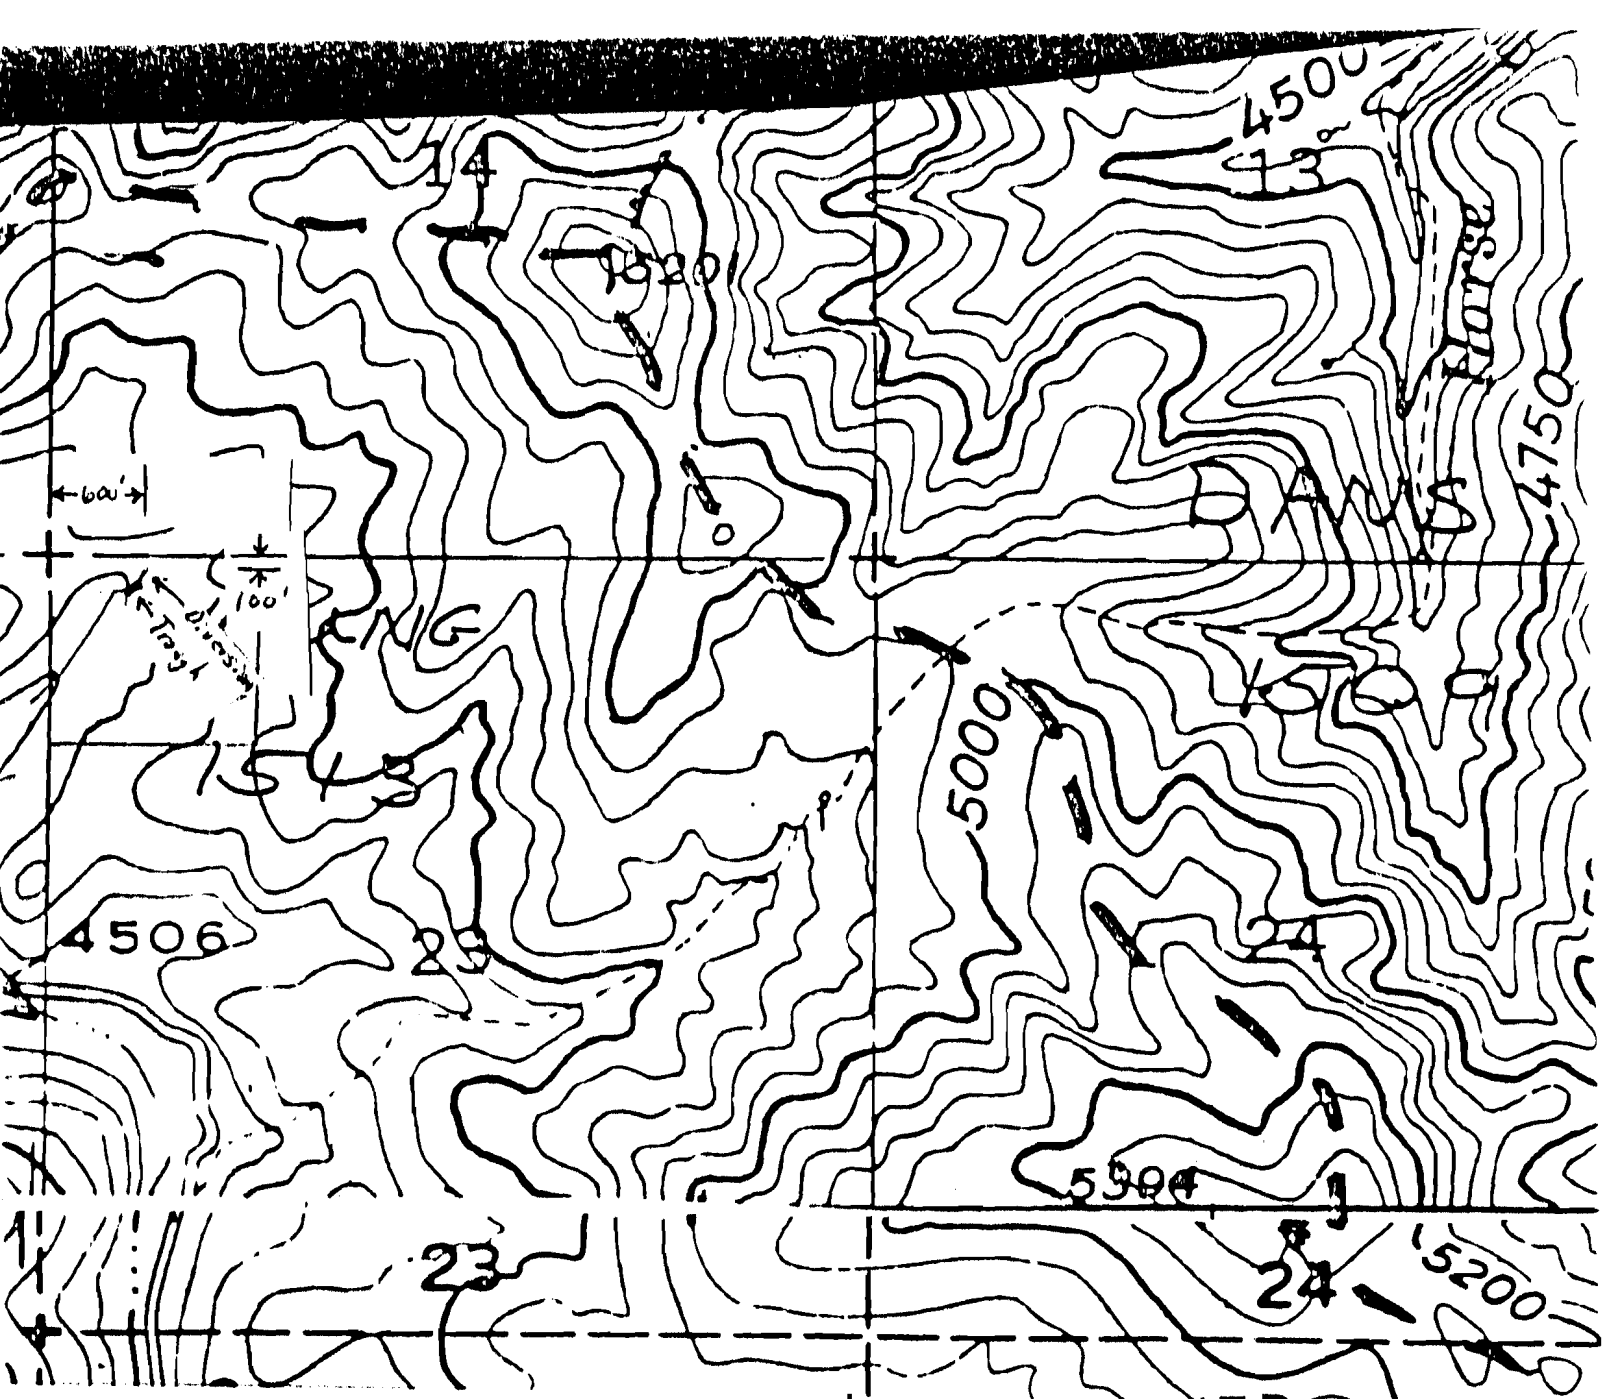



MALHEUR NATIONAL FOREST

STOCK WATER

Murderer's allotment (83810)

SCALE 4 IN. : 1 MILE

T. 15S. R. 28E. North

application no. 65657

permit no. 49287

RECEIVED
WATER RESOURCES DEPT
SALEM, OREGON