


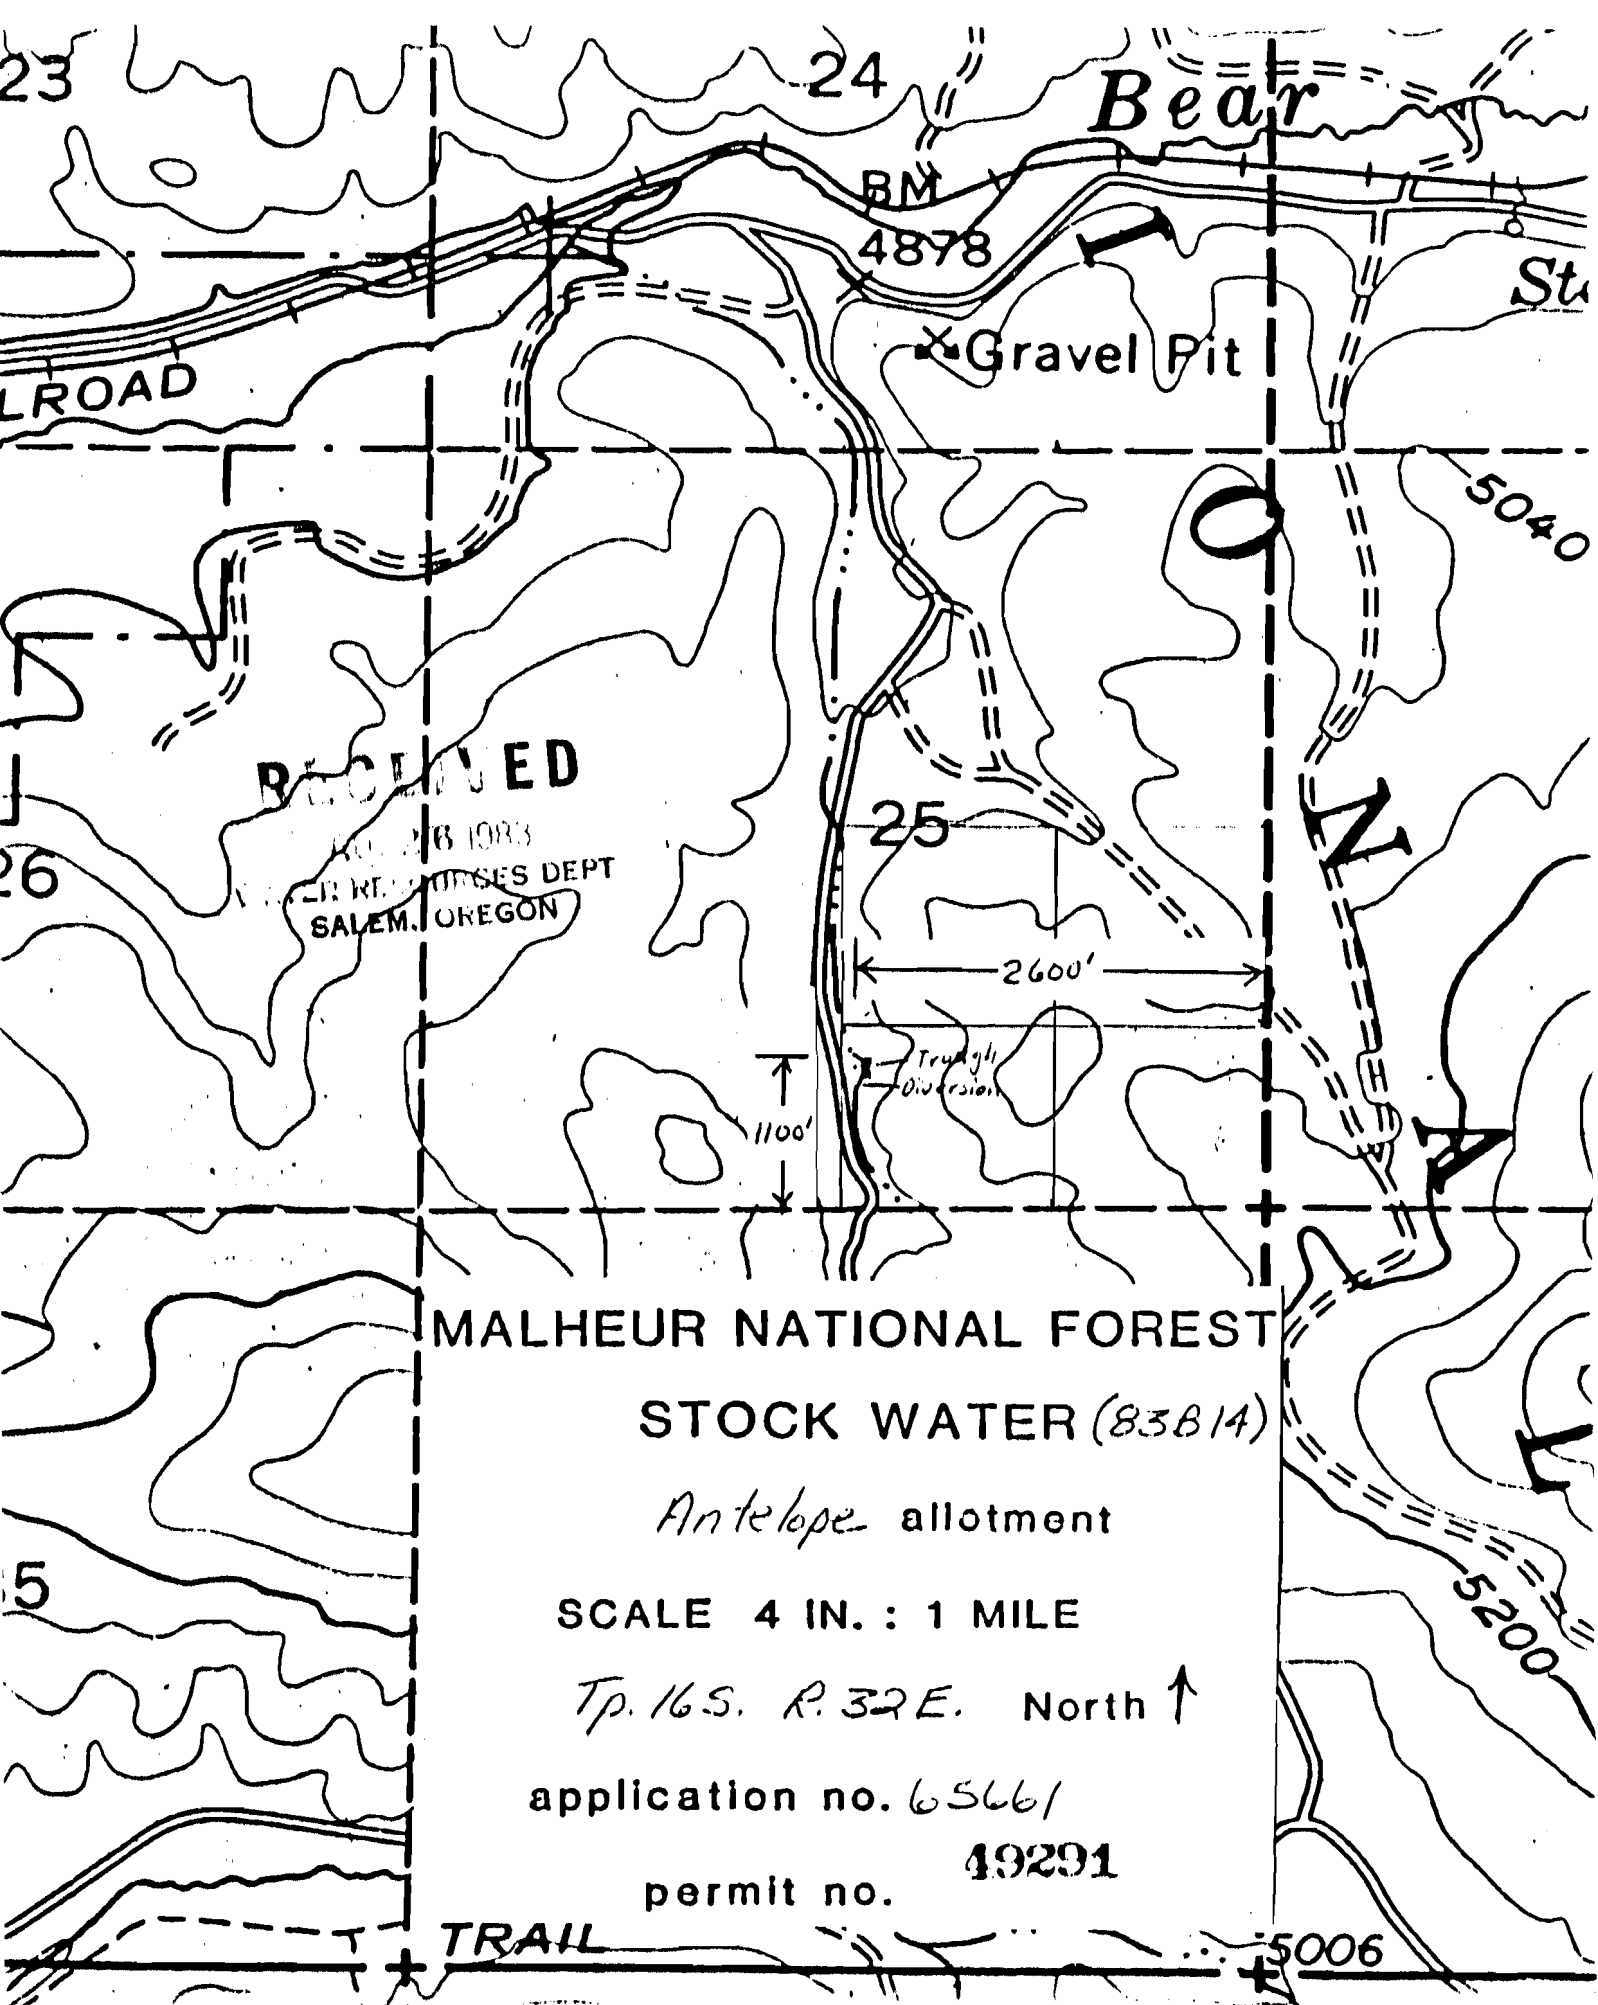

RECEIVED

NOV 28 1983
SALEM, OREGON

MALHEUR NATIONAL FOREST

STOCK WATER (83B14)

Antelope allotment

SCALE 4 IN. : 1 MILE

Tp. 16 S. R. 32 E. North ↑

application no. 65661

permit no. 49291

TRAIL

5006