


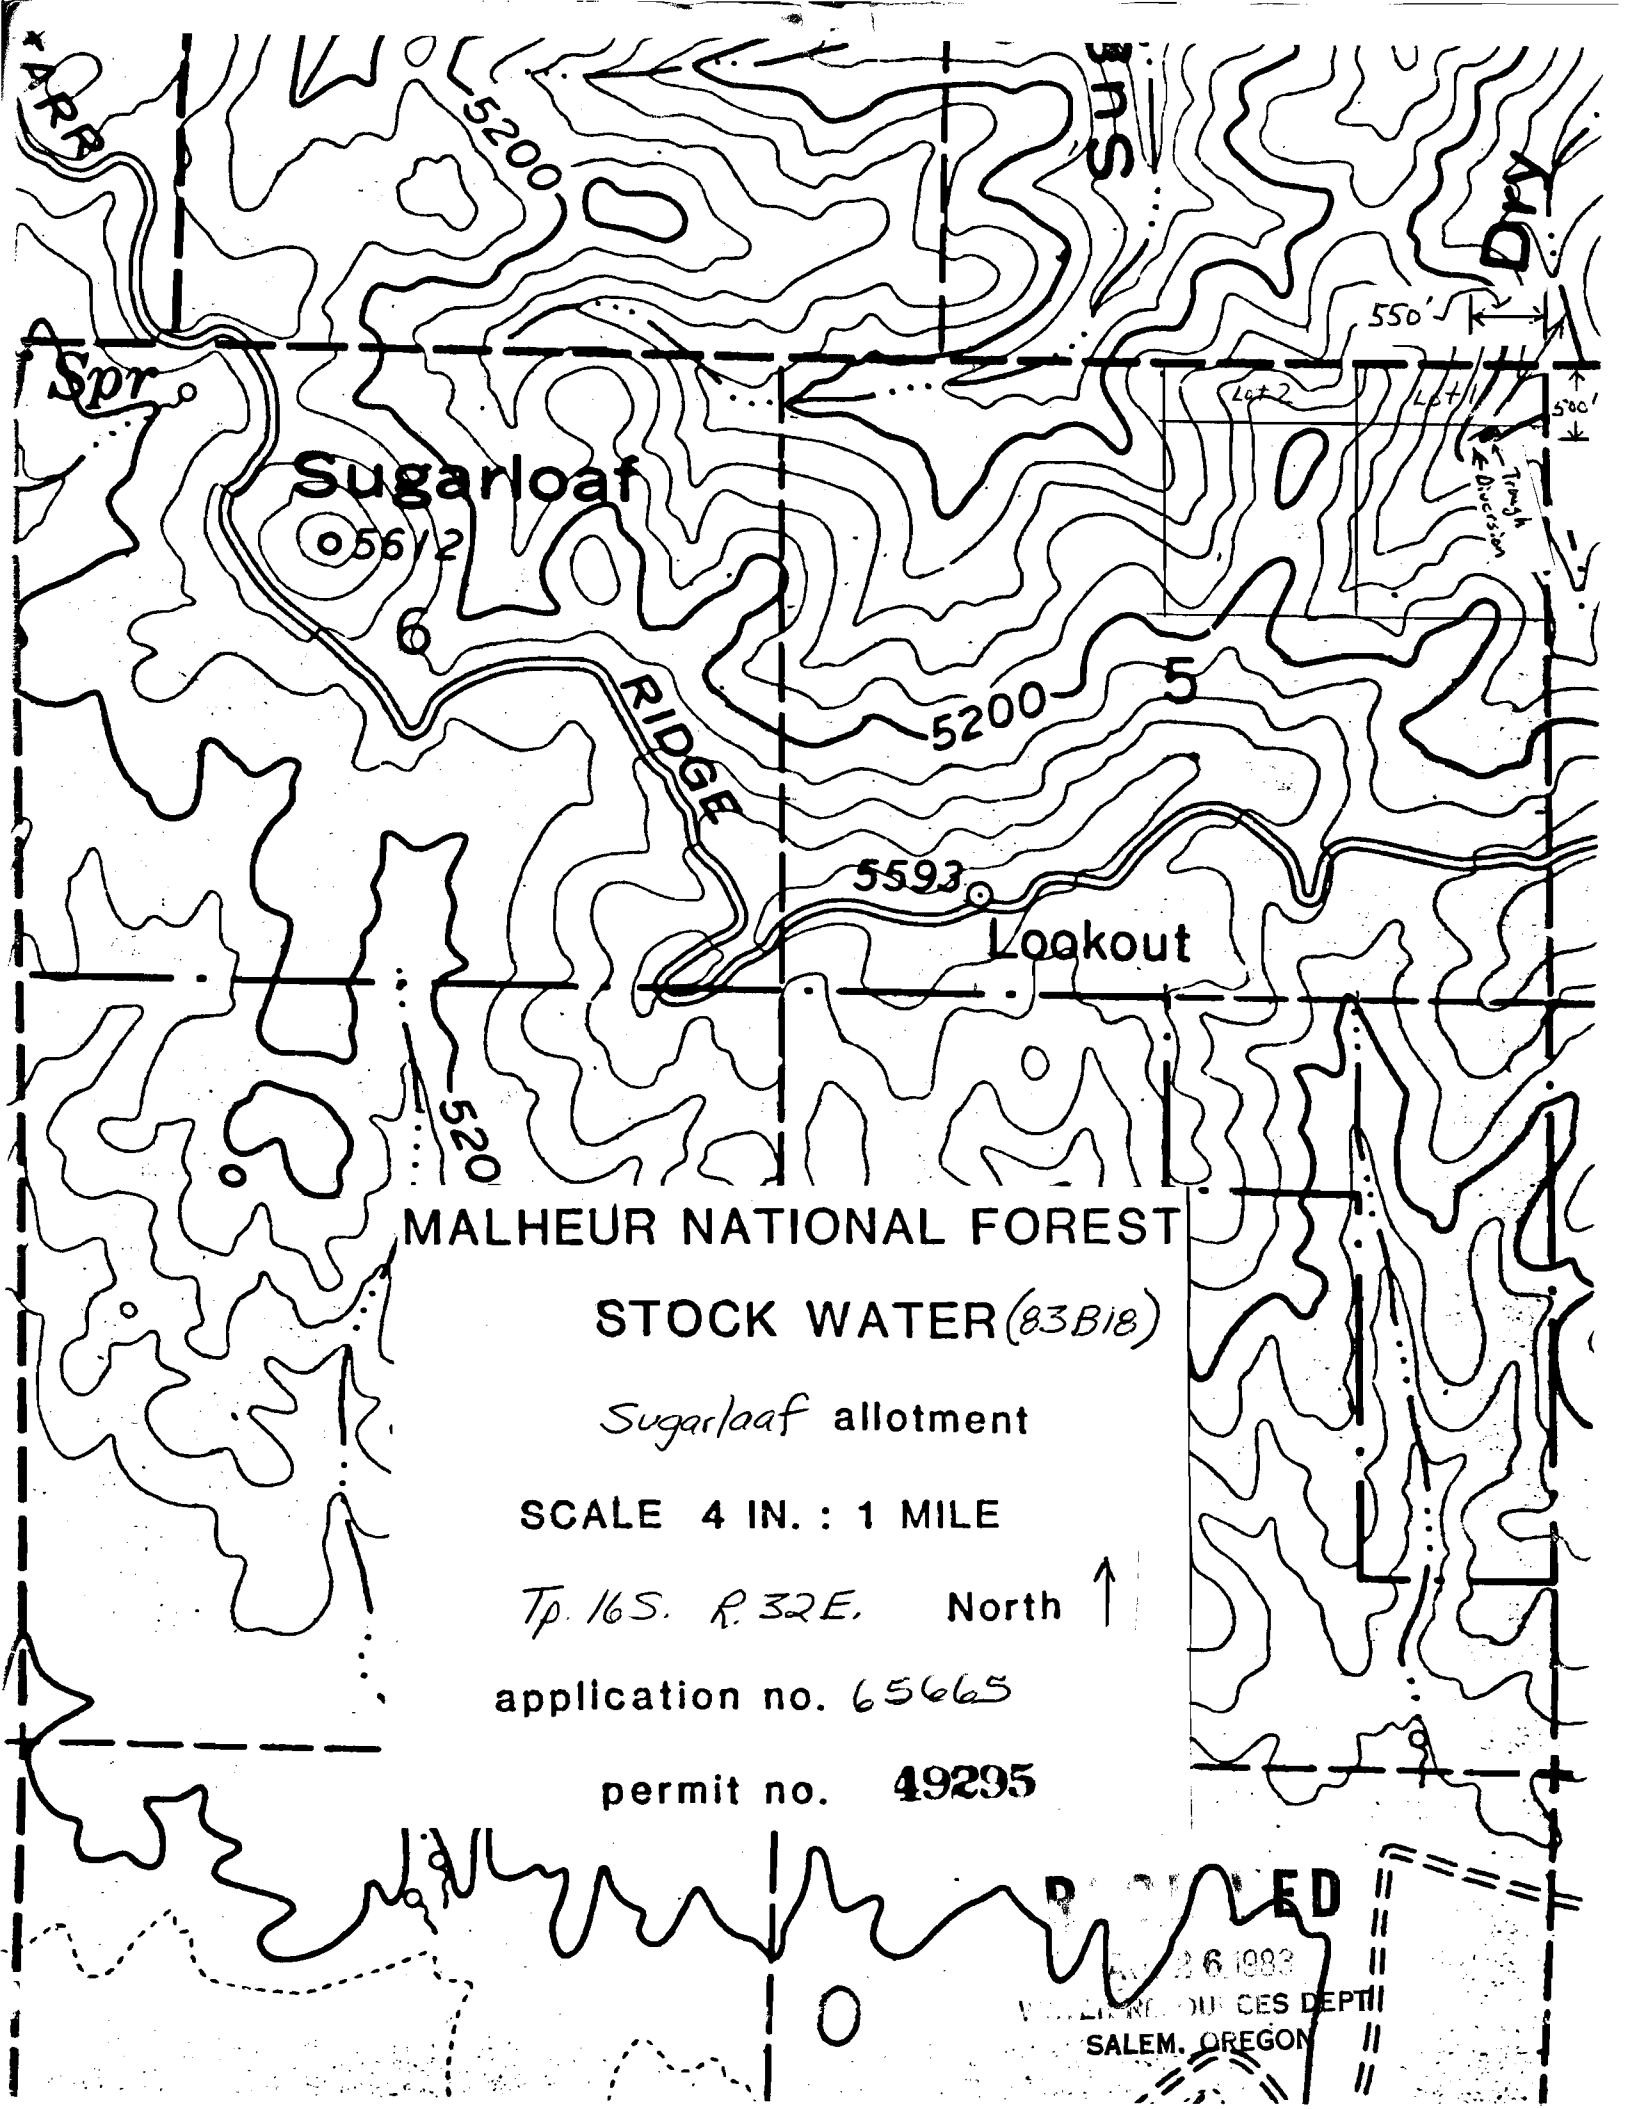

Sugarloaf

5561

6

RIDGE

5200

5

5593

Lookout

520

MALHEUR NATIONAL FOREST

STOCK WATER (83B18)

Sugarloaf allotment

SCALE 4 IN. : 1 MILE

Tp. 16S. R. 32E. North ↑

application no. 65665

permit no. 49295

REVISED

26 1983
VOLUME OF CES DEPT
SALEM, OREGON