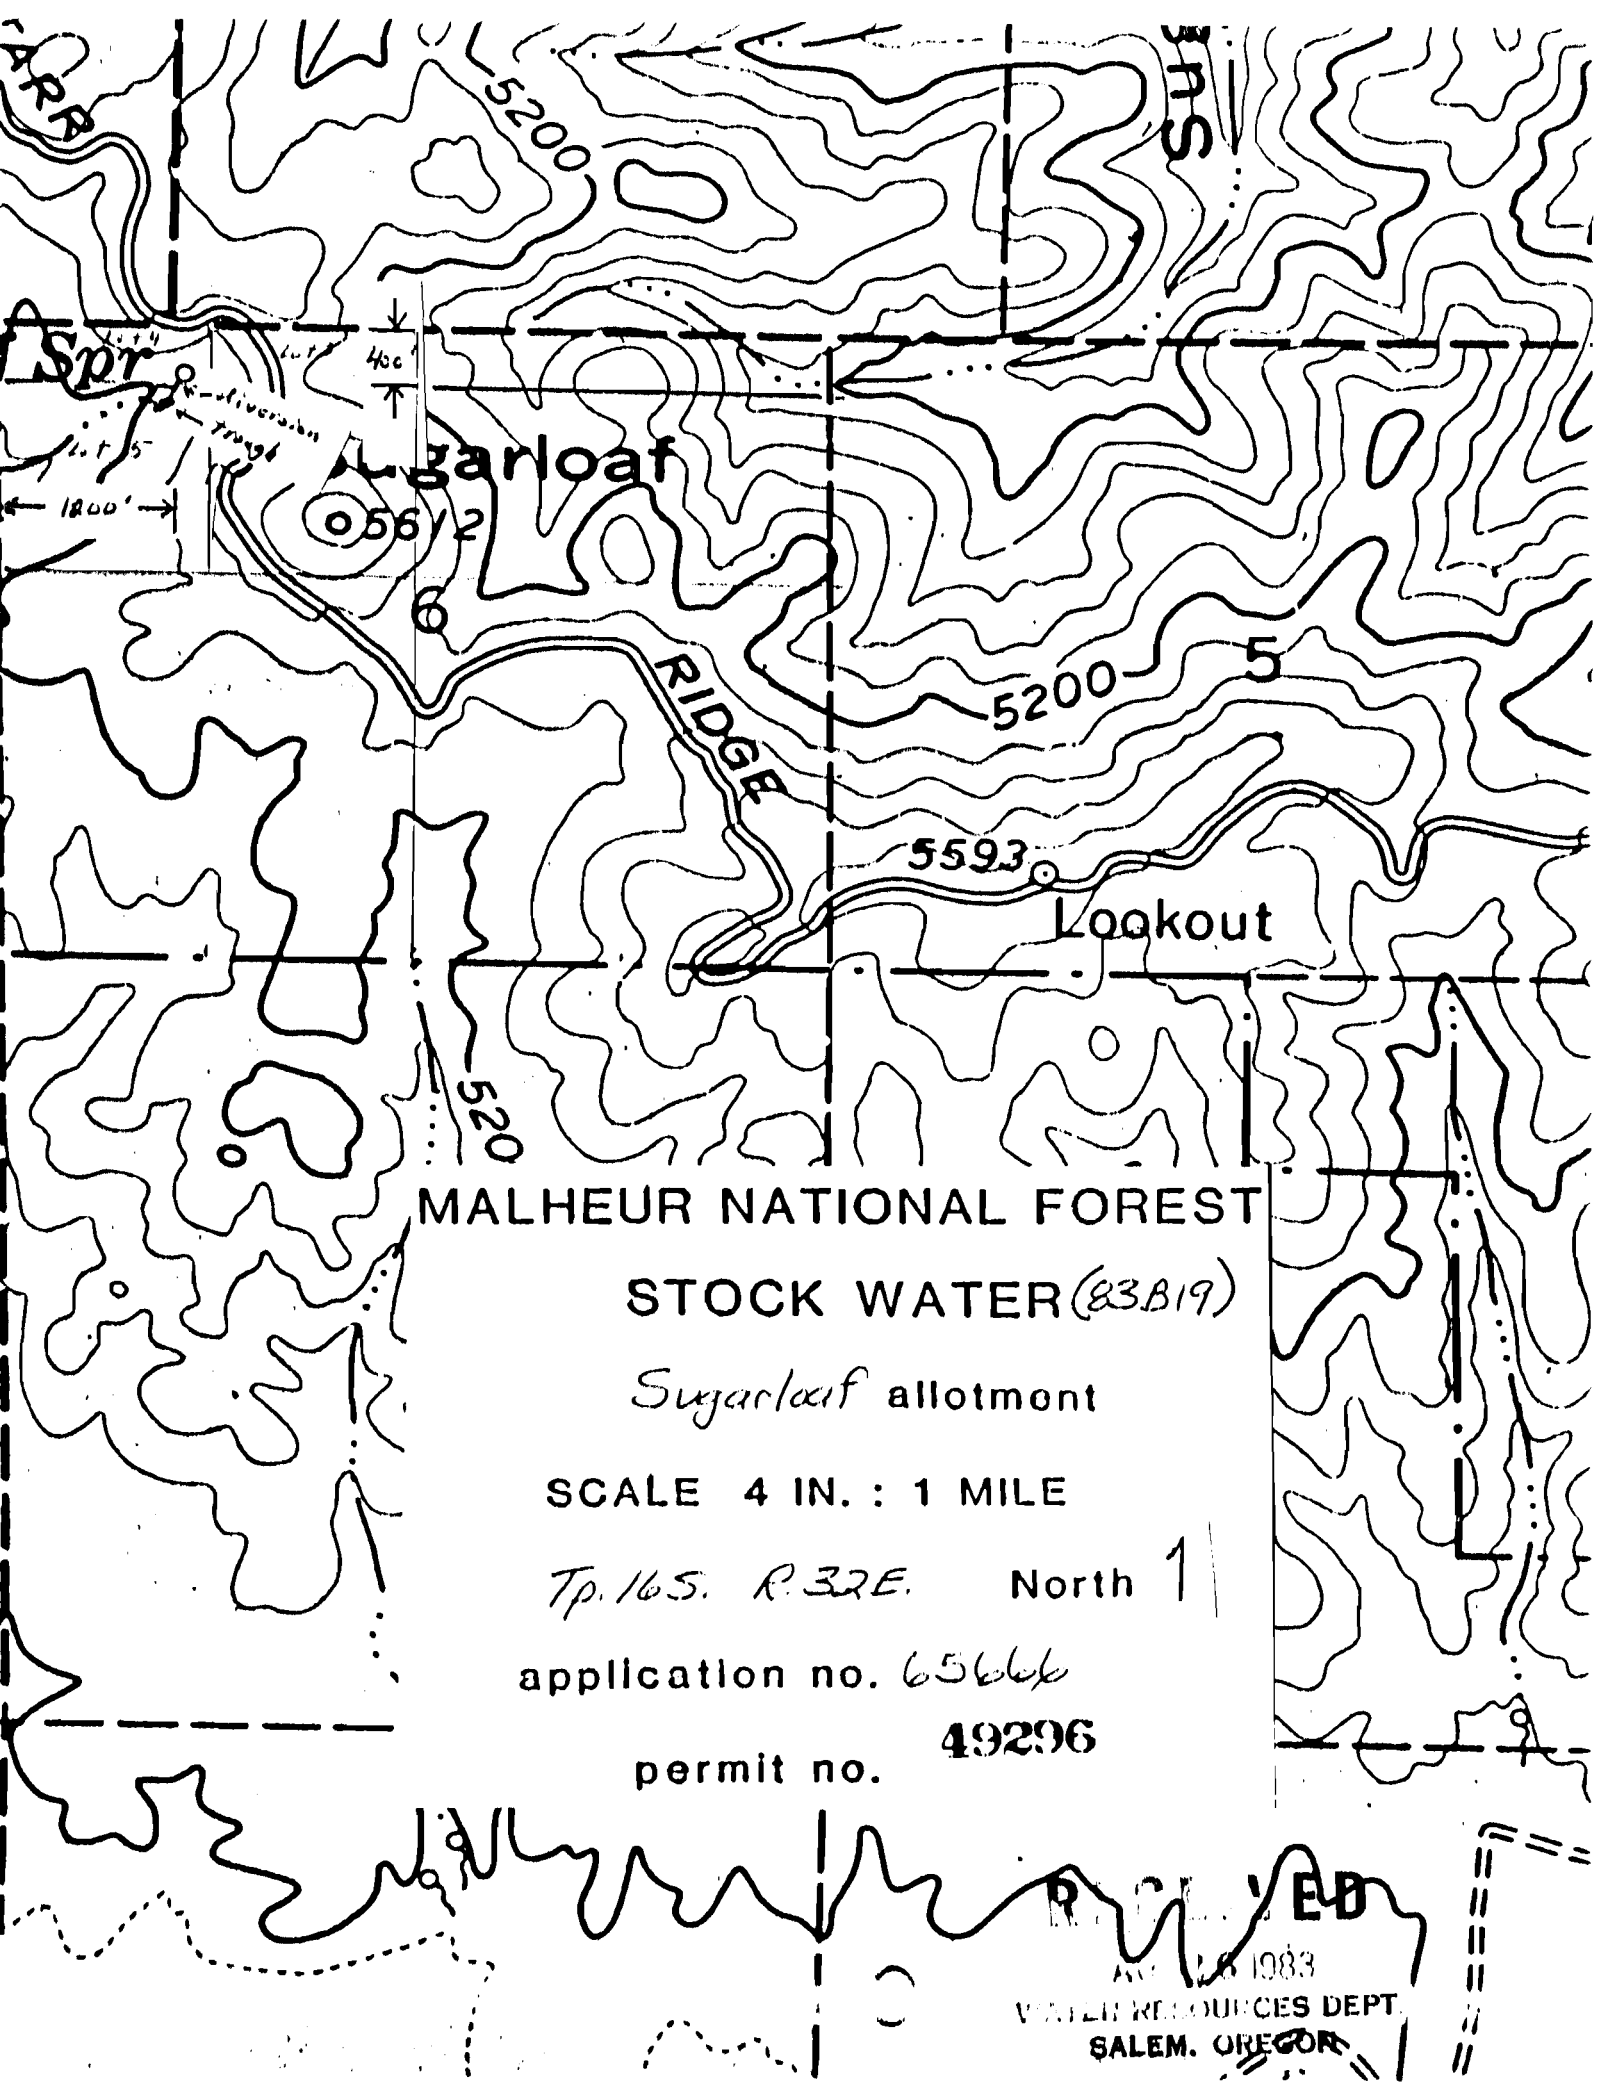


MALHEUR NATIONAL FOREST

STOCK WATER (83B19)

Sugarloaf allotment

SCALE 4 IN. : 1 MILE

Tp. 16S. R. 32E. North

application no. 65666

permit no. 49296

RECEIVED
AUG 26 1983
WATER RESOURCES DEPT.
SALEM, OREGON