


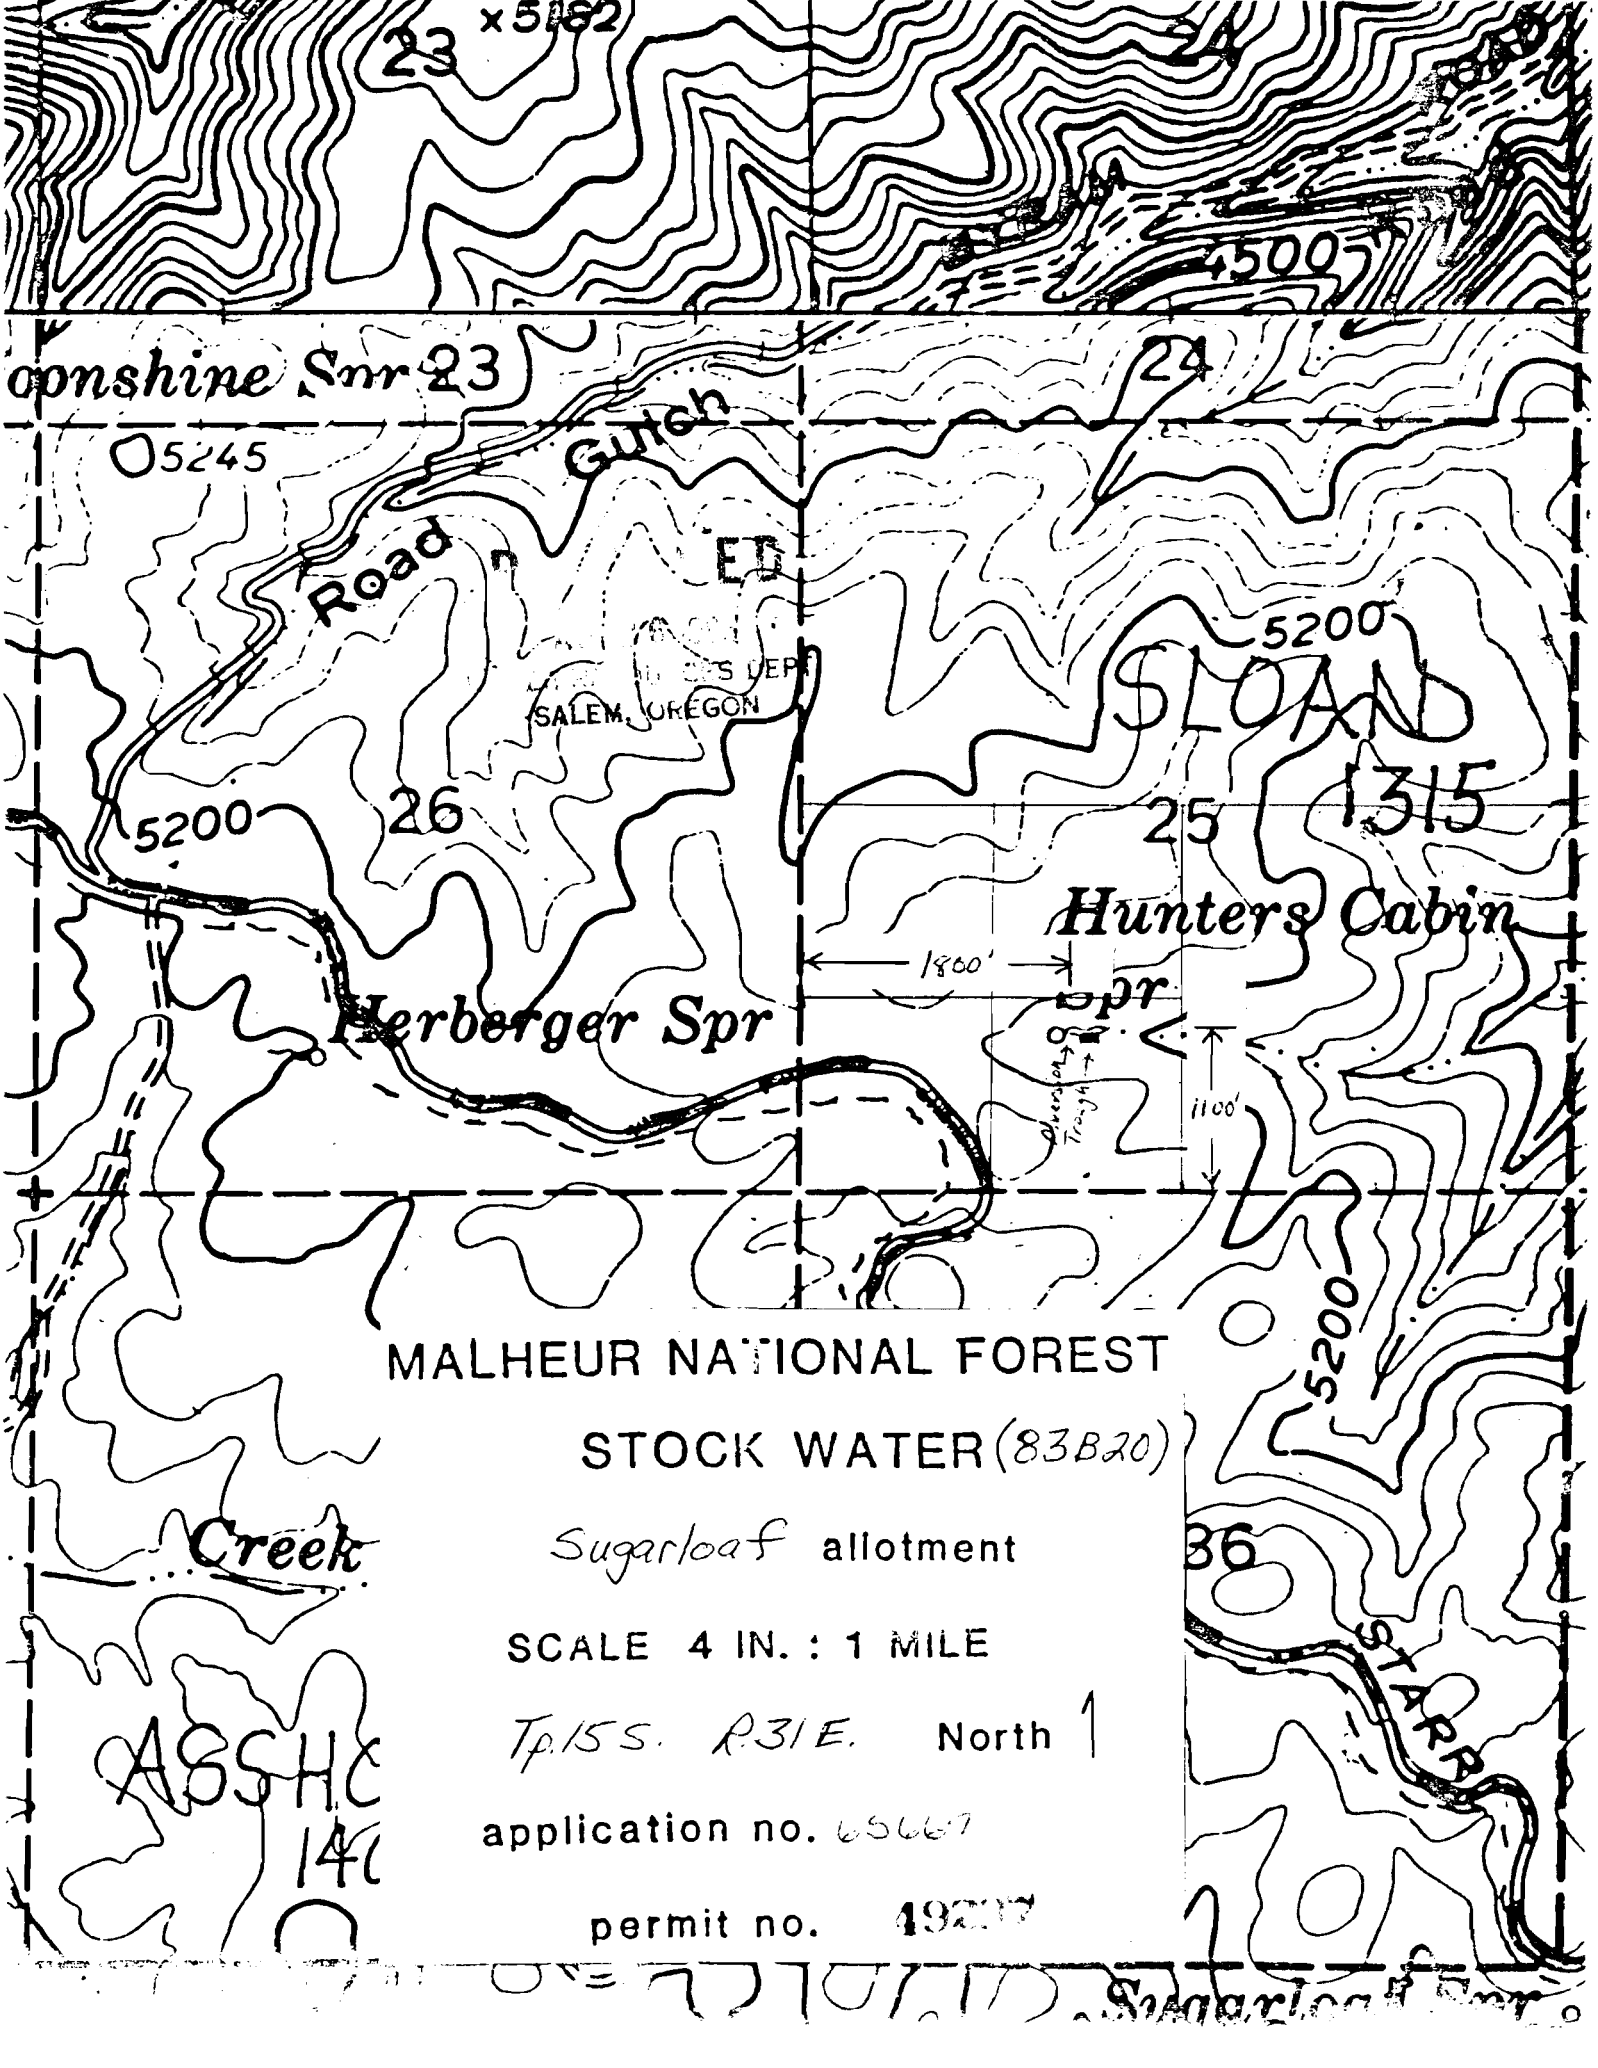

MALHEUR NATIONAL FOREST

STOCK WATER (83B20)

Sugarloaf allotment

SCALE 4 IN. : 1 MILE

Tp. 15 S. R. 31 E. North 1

application no. 65667

permit no. 49207

Creek

ASSHC
146

Sugarloaf Spr.