


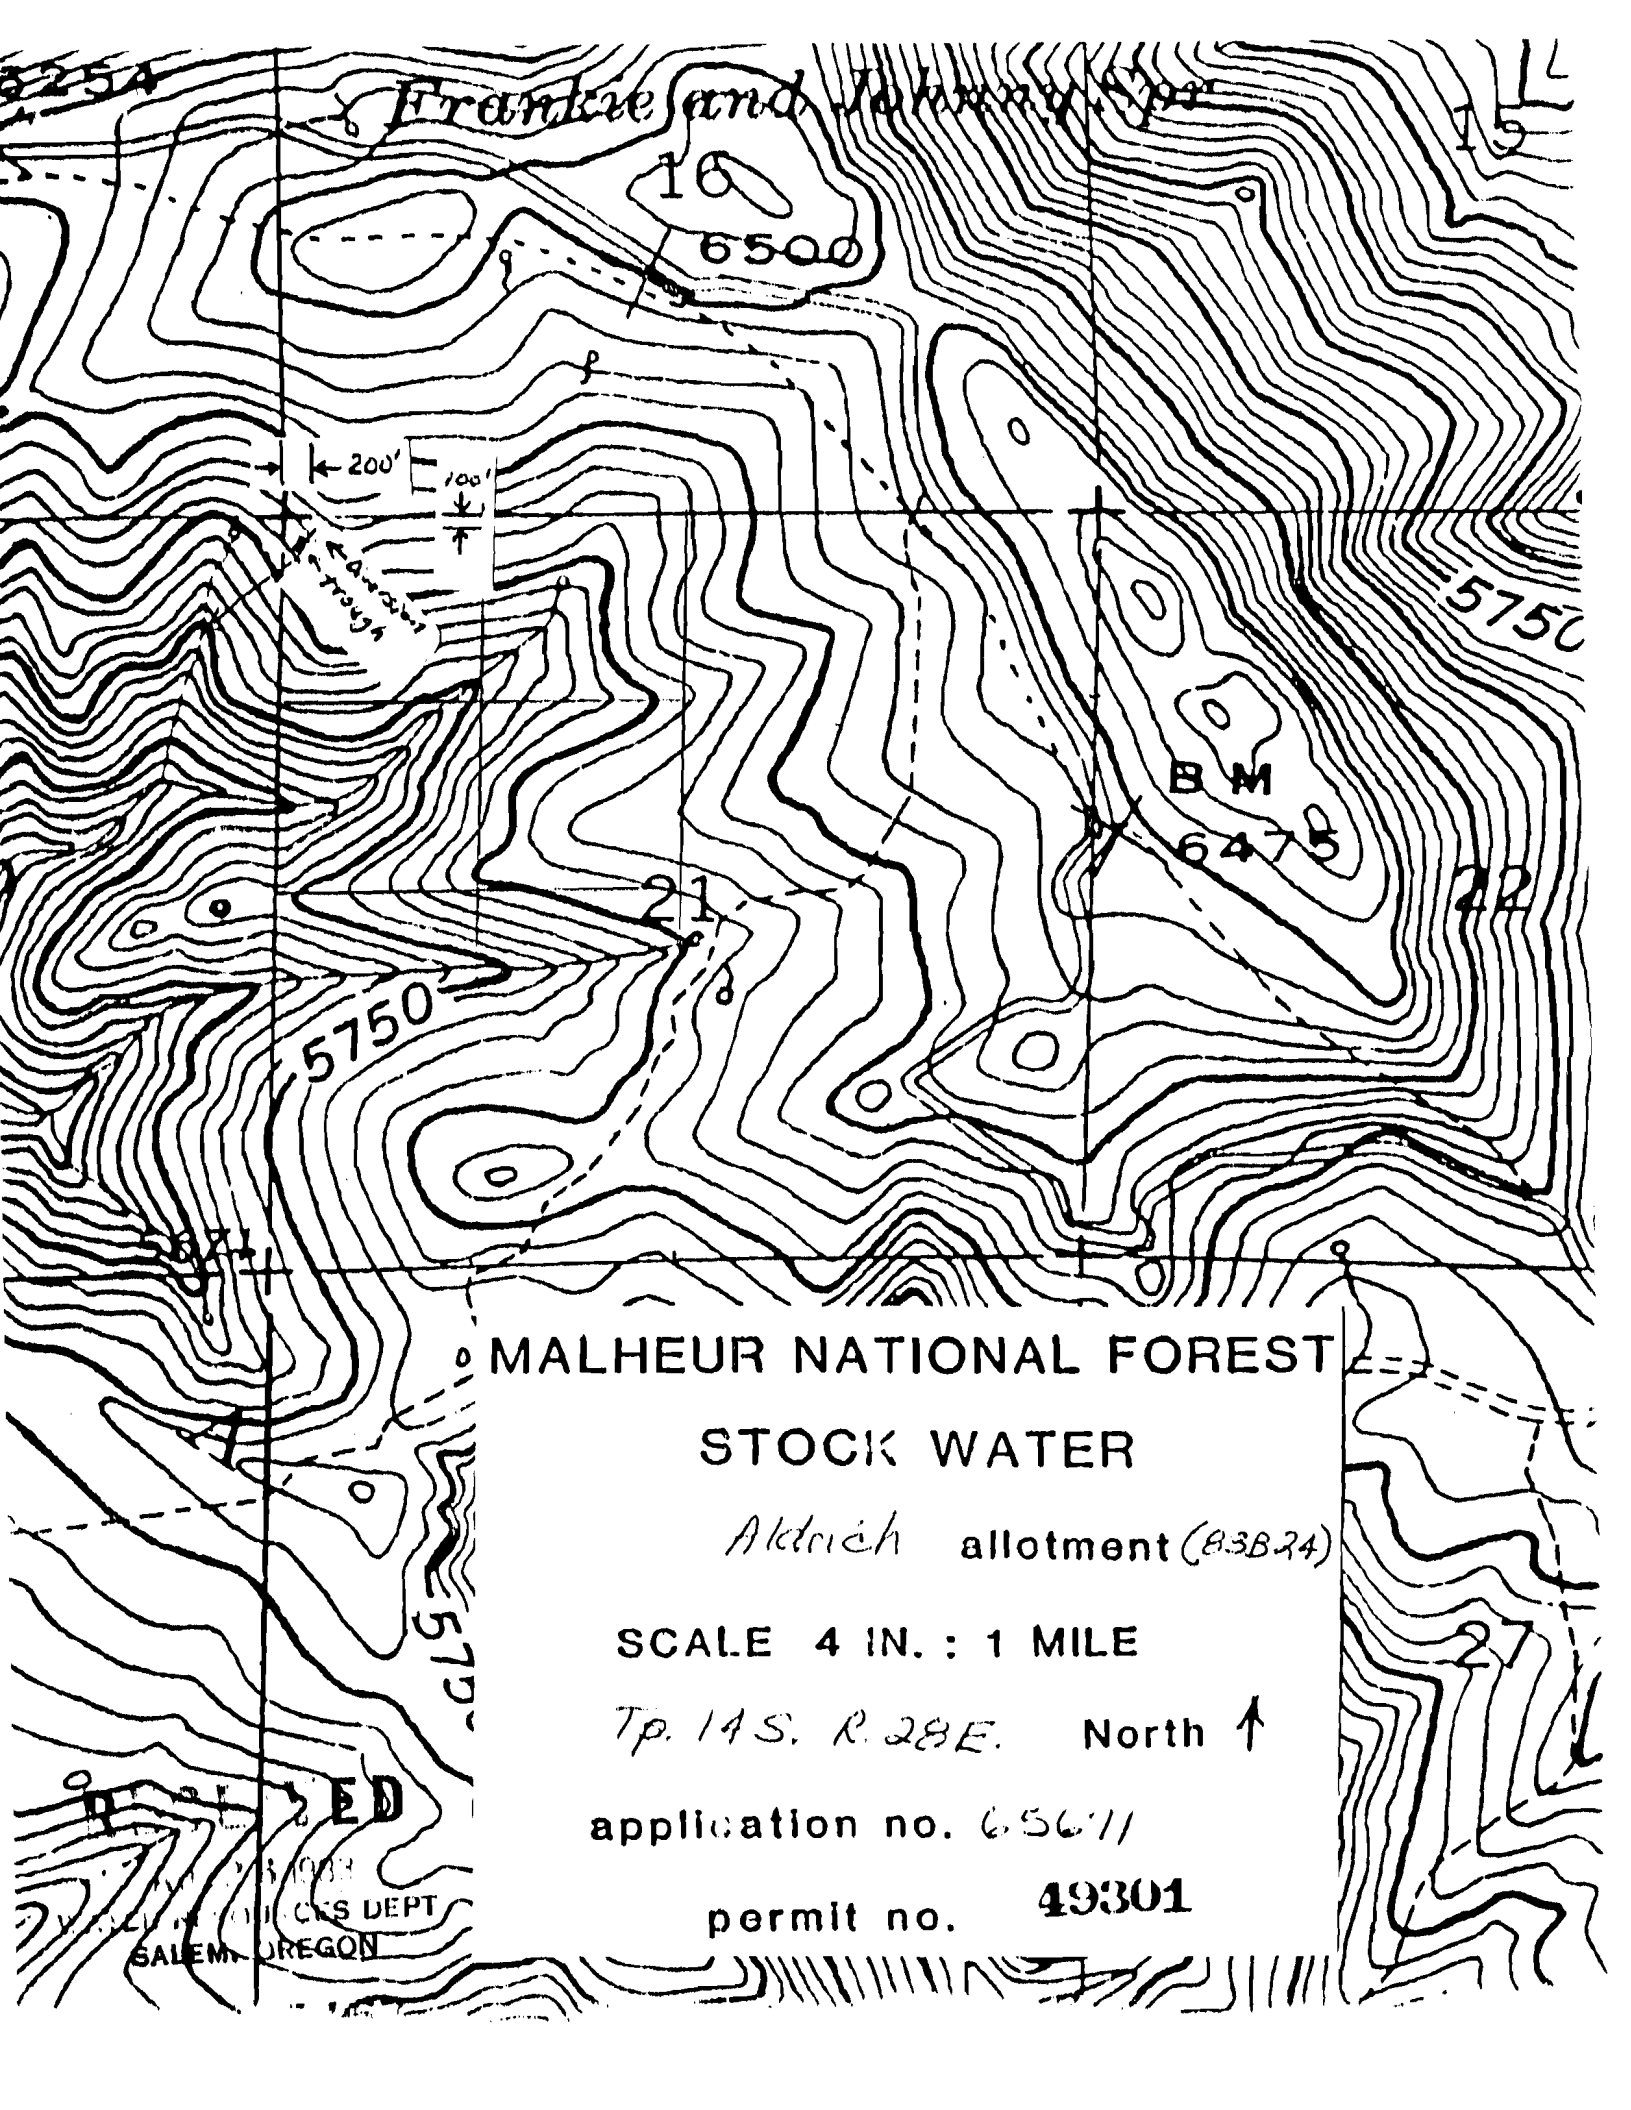

Frankie and Johnny

16
6500

200'
100'

5750

B.M.
6475

5750

MALHEUR NATIONAL FOREST

STOCK WATER

Aldrich allotment (B3B24)

SCALE 4 IN. : 1 MILE

Tp. 14S. R. 28E. North ↑

application no. 65677

permit no. 49301

RECEIVED

JAN 1938
FOREST SERVICE DEPT.
SALEM, OREGON