


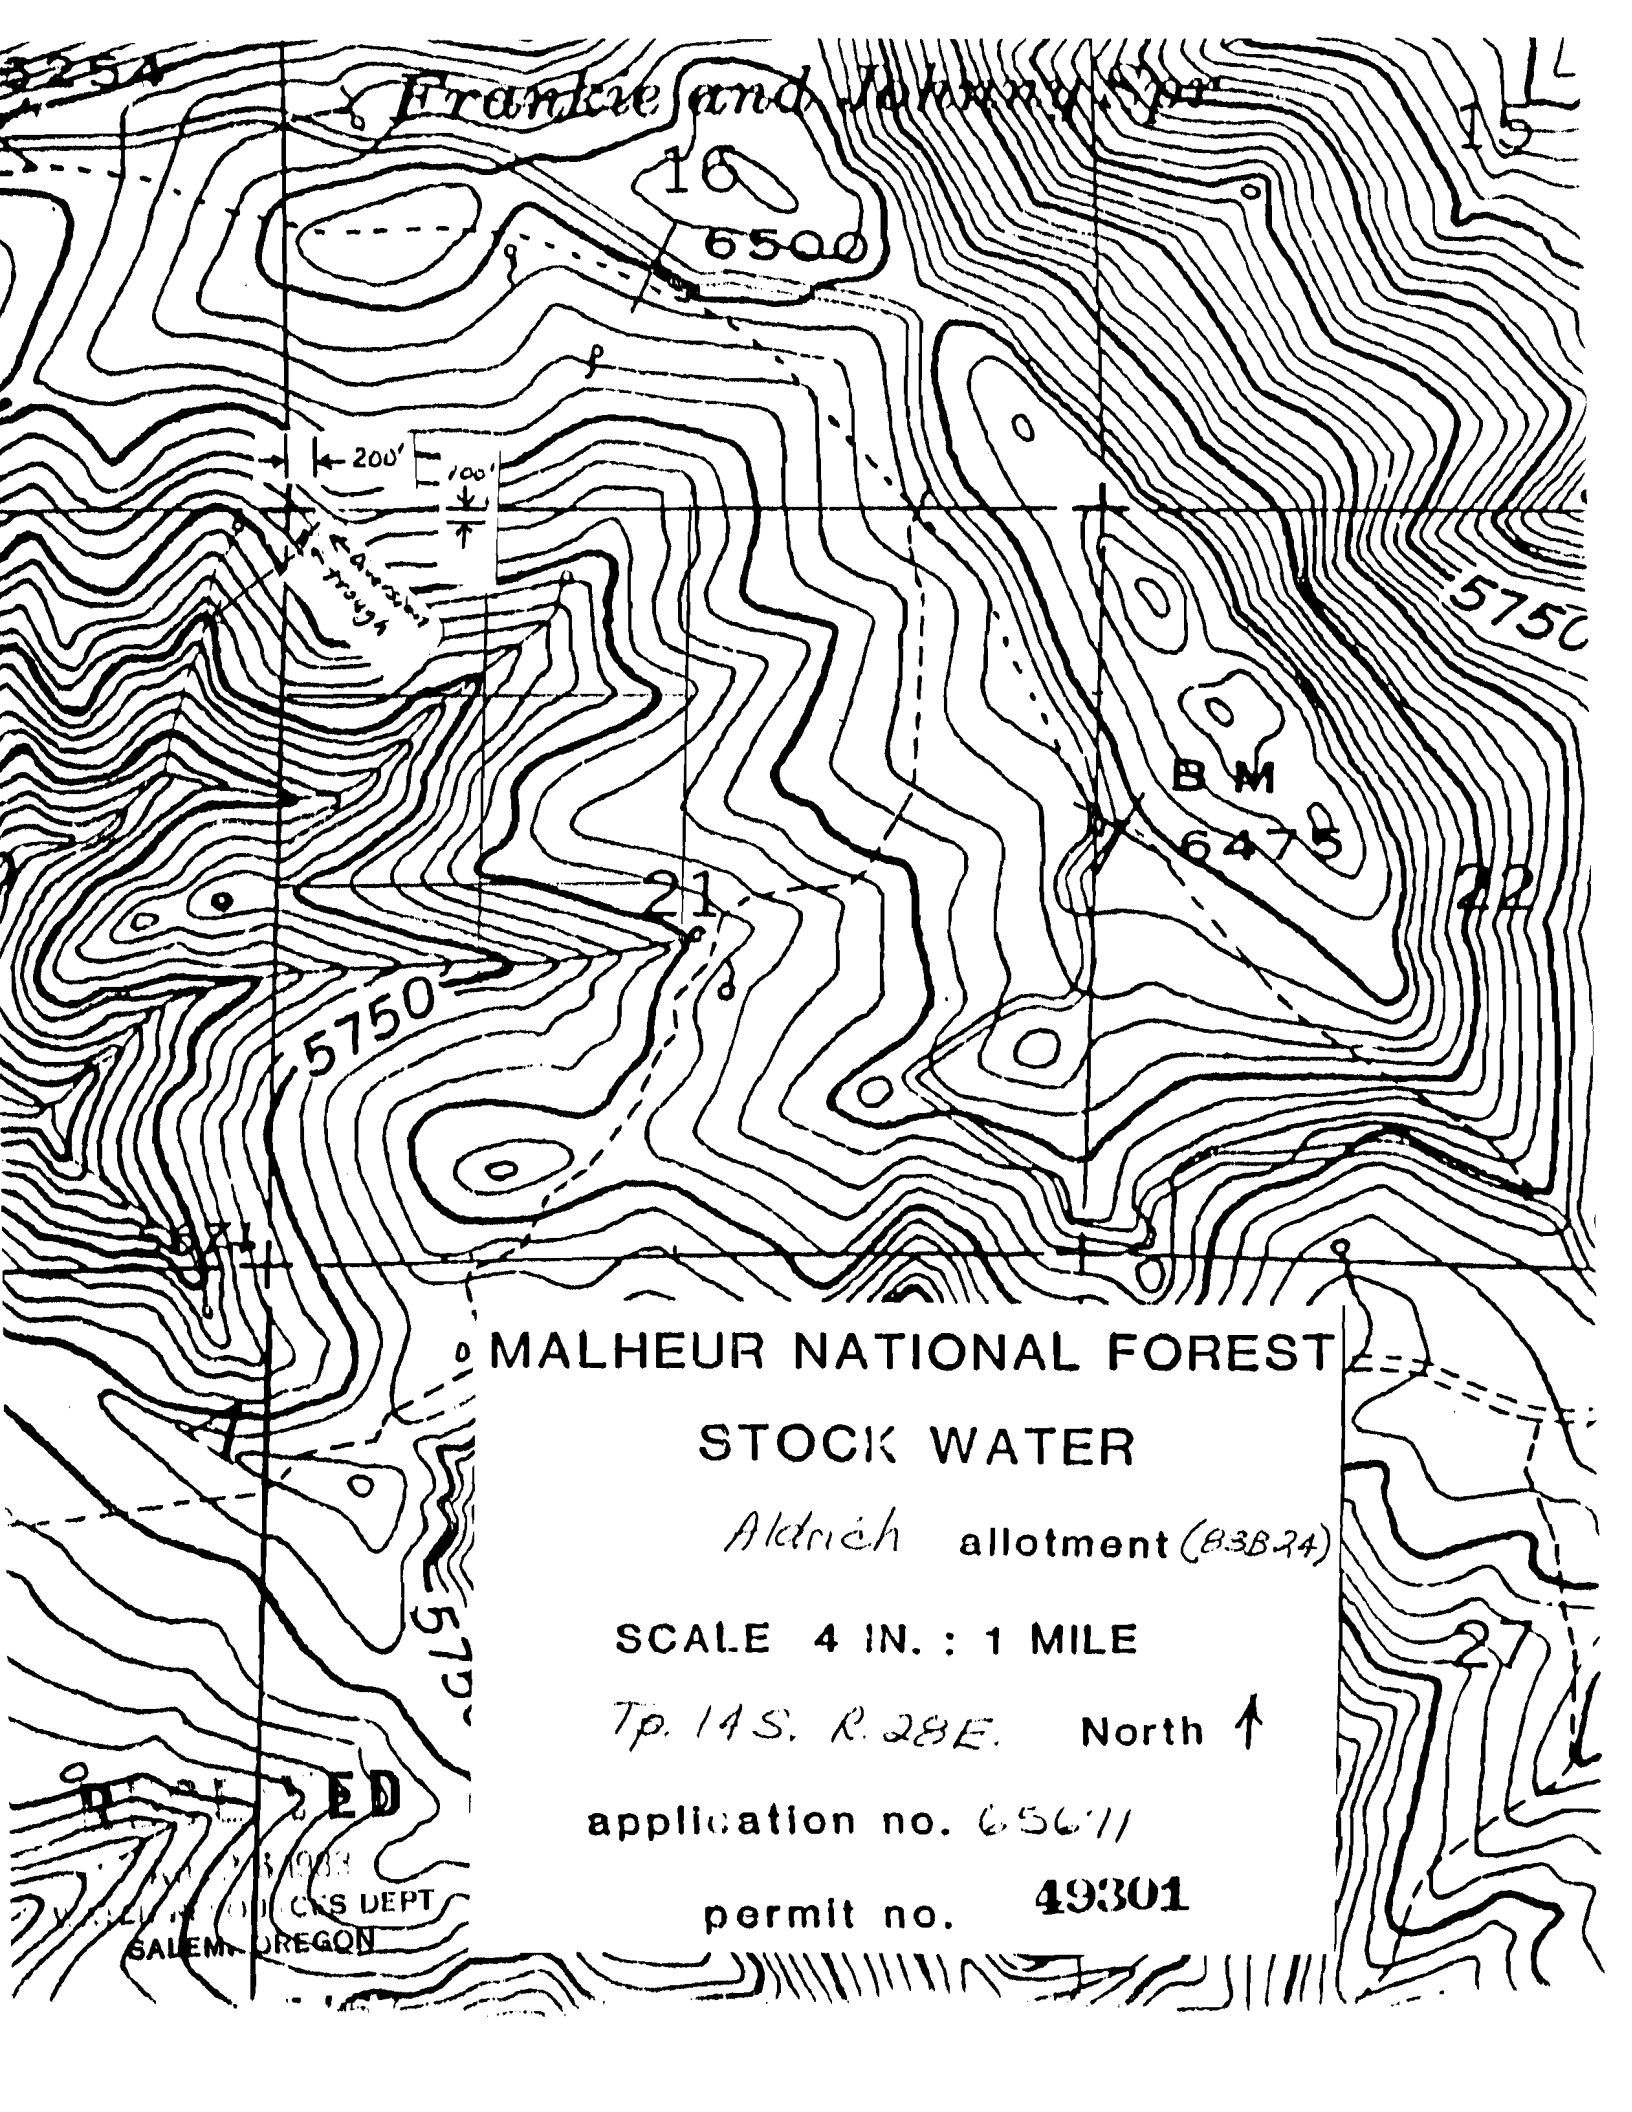

Frankie and Johnny Spr

16
6500

200'
100'

BM
6475

5750

5750

MALHEUR NATIONAL FOREST

STOCK WATER

Aldrich allotment (B3B24)

SCALE 4 IN. : 1 MILE

Tp. 14S. R. 28E. North ↑

application no. 65677

permit no. 49301

RECEIVED
SALEM, OREGON