


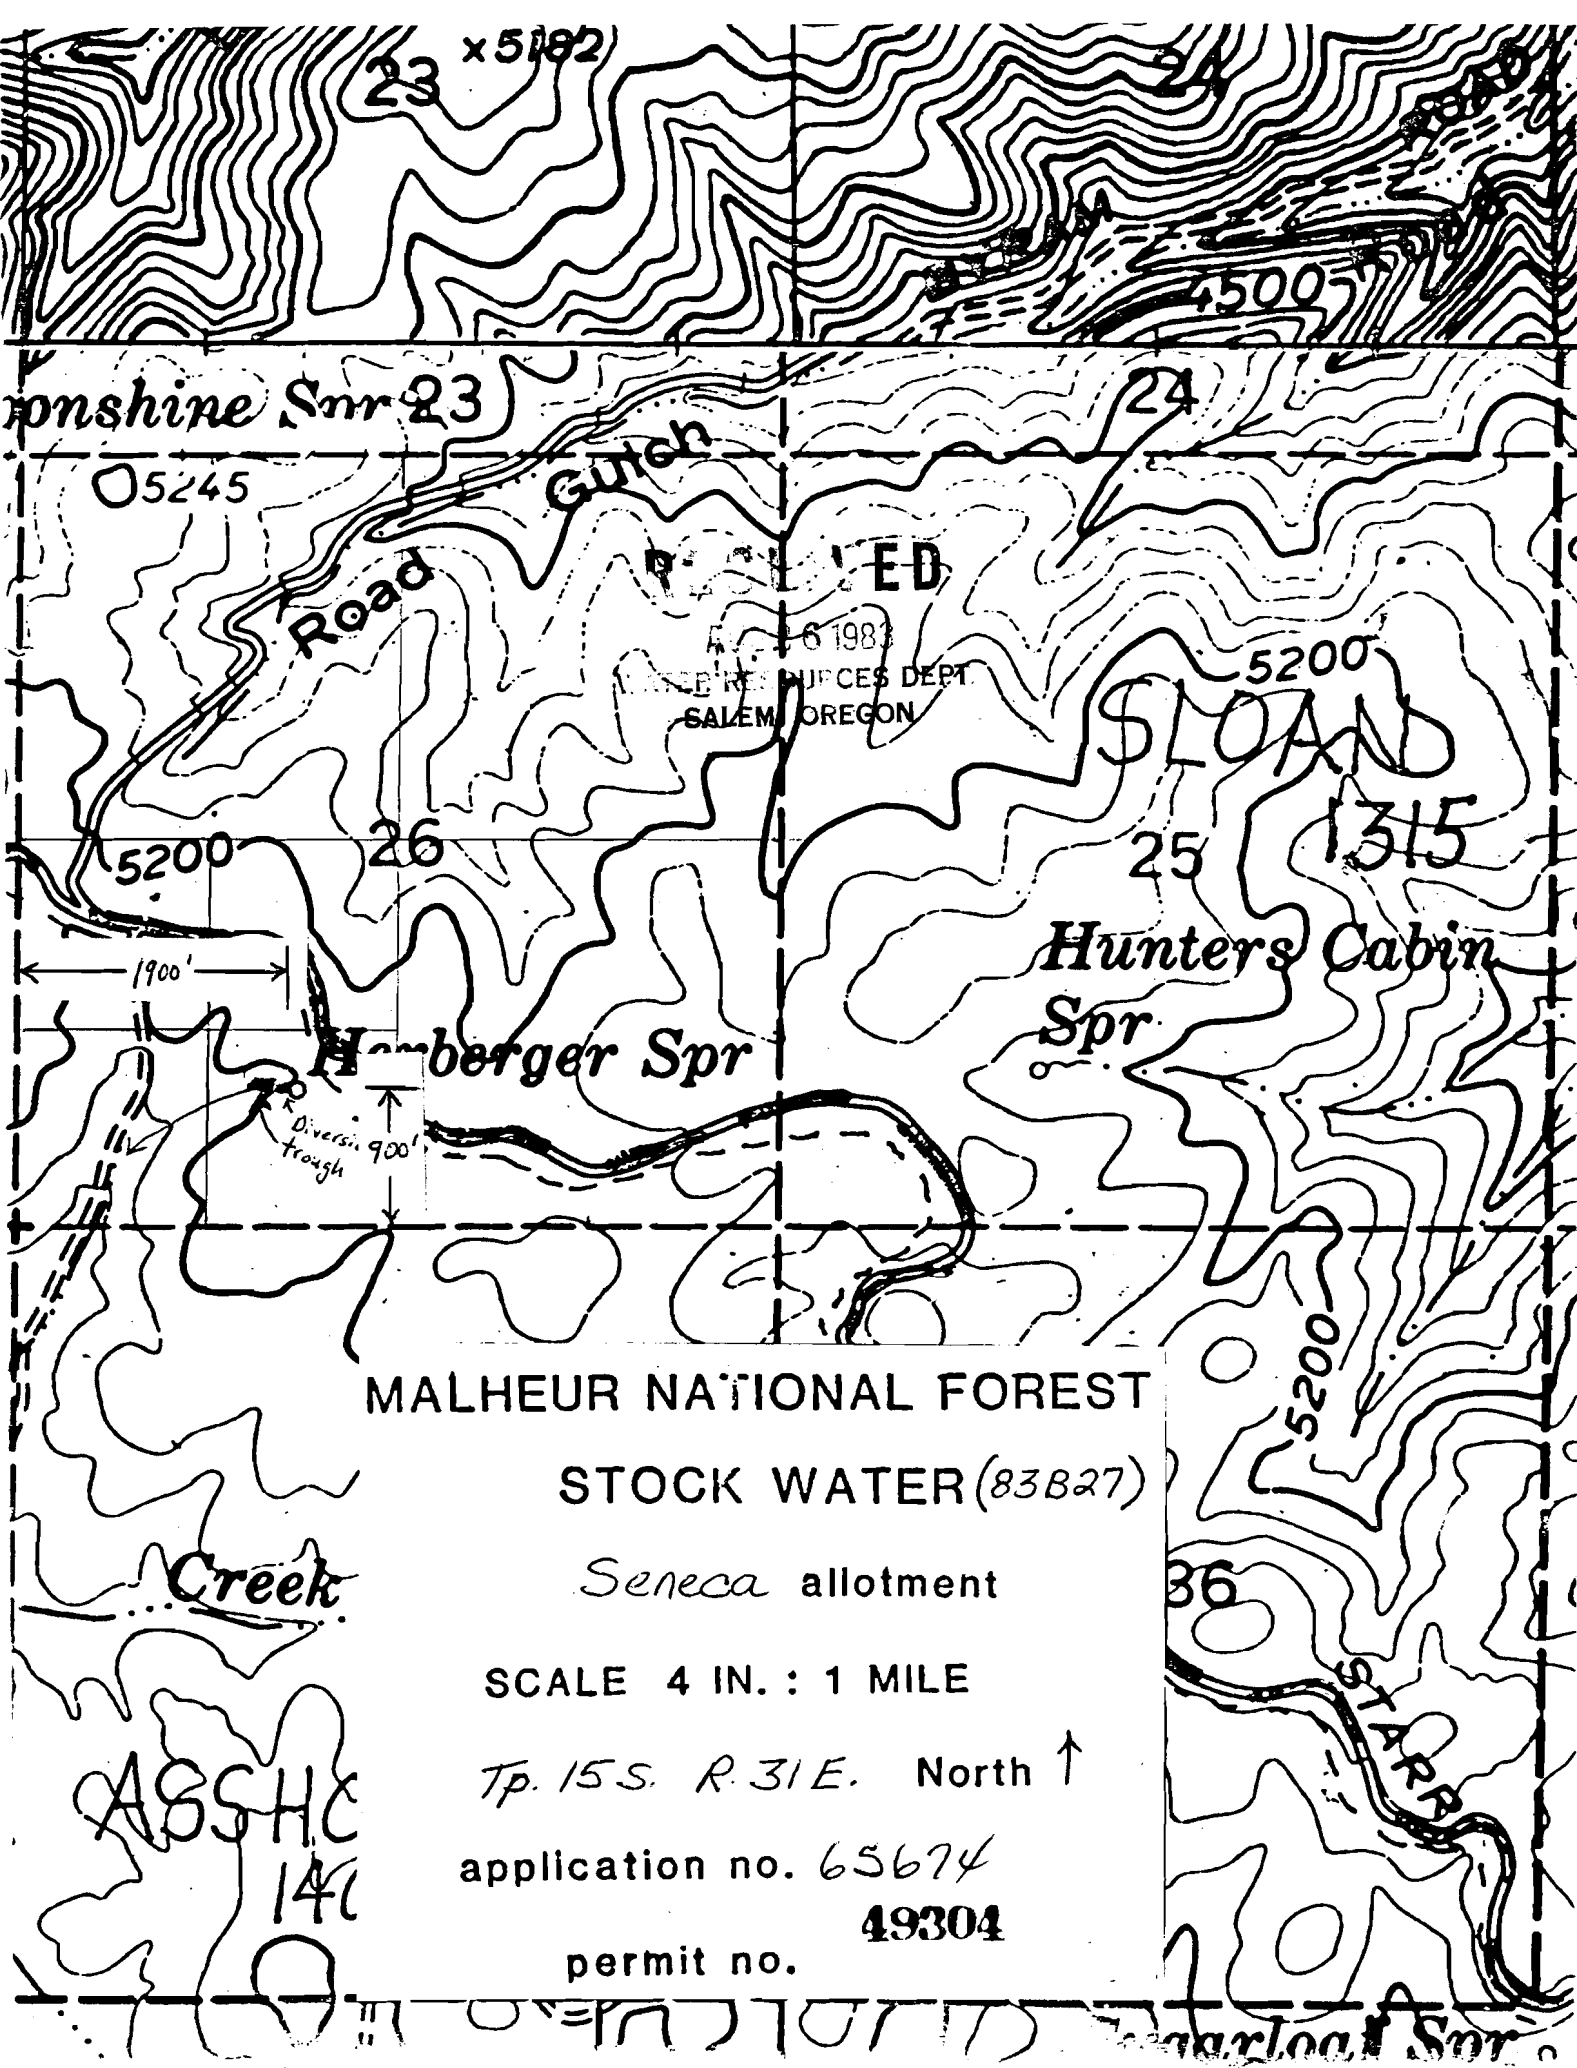

MALHEUR NATIONAL FOREST

STOCK WATER (83B27)


Seneca allotment

SCALE 4 IN. : 1 MILE

Tp. 15 S. R. 31 E. North ↑

application no. 65674

permit no. 49304

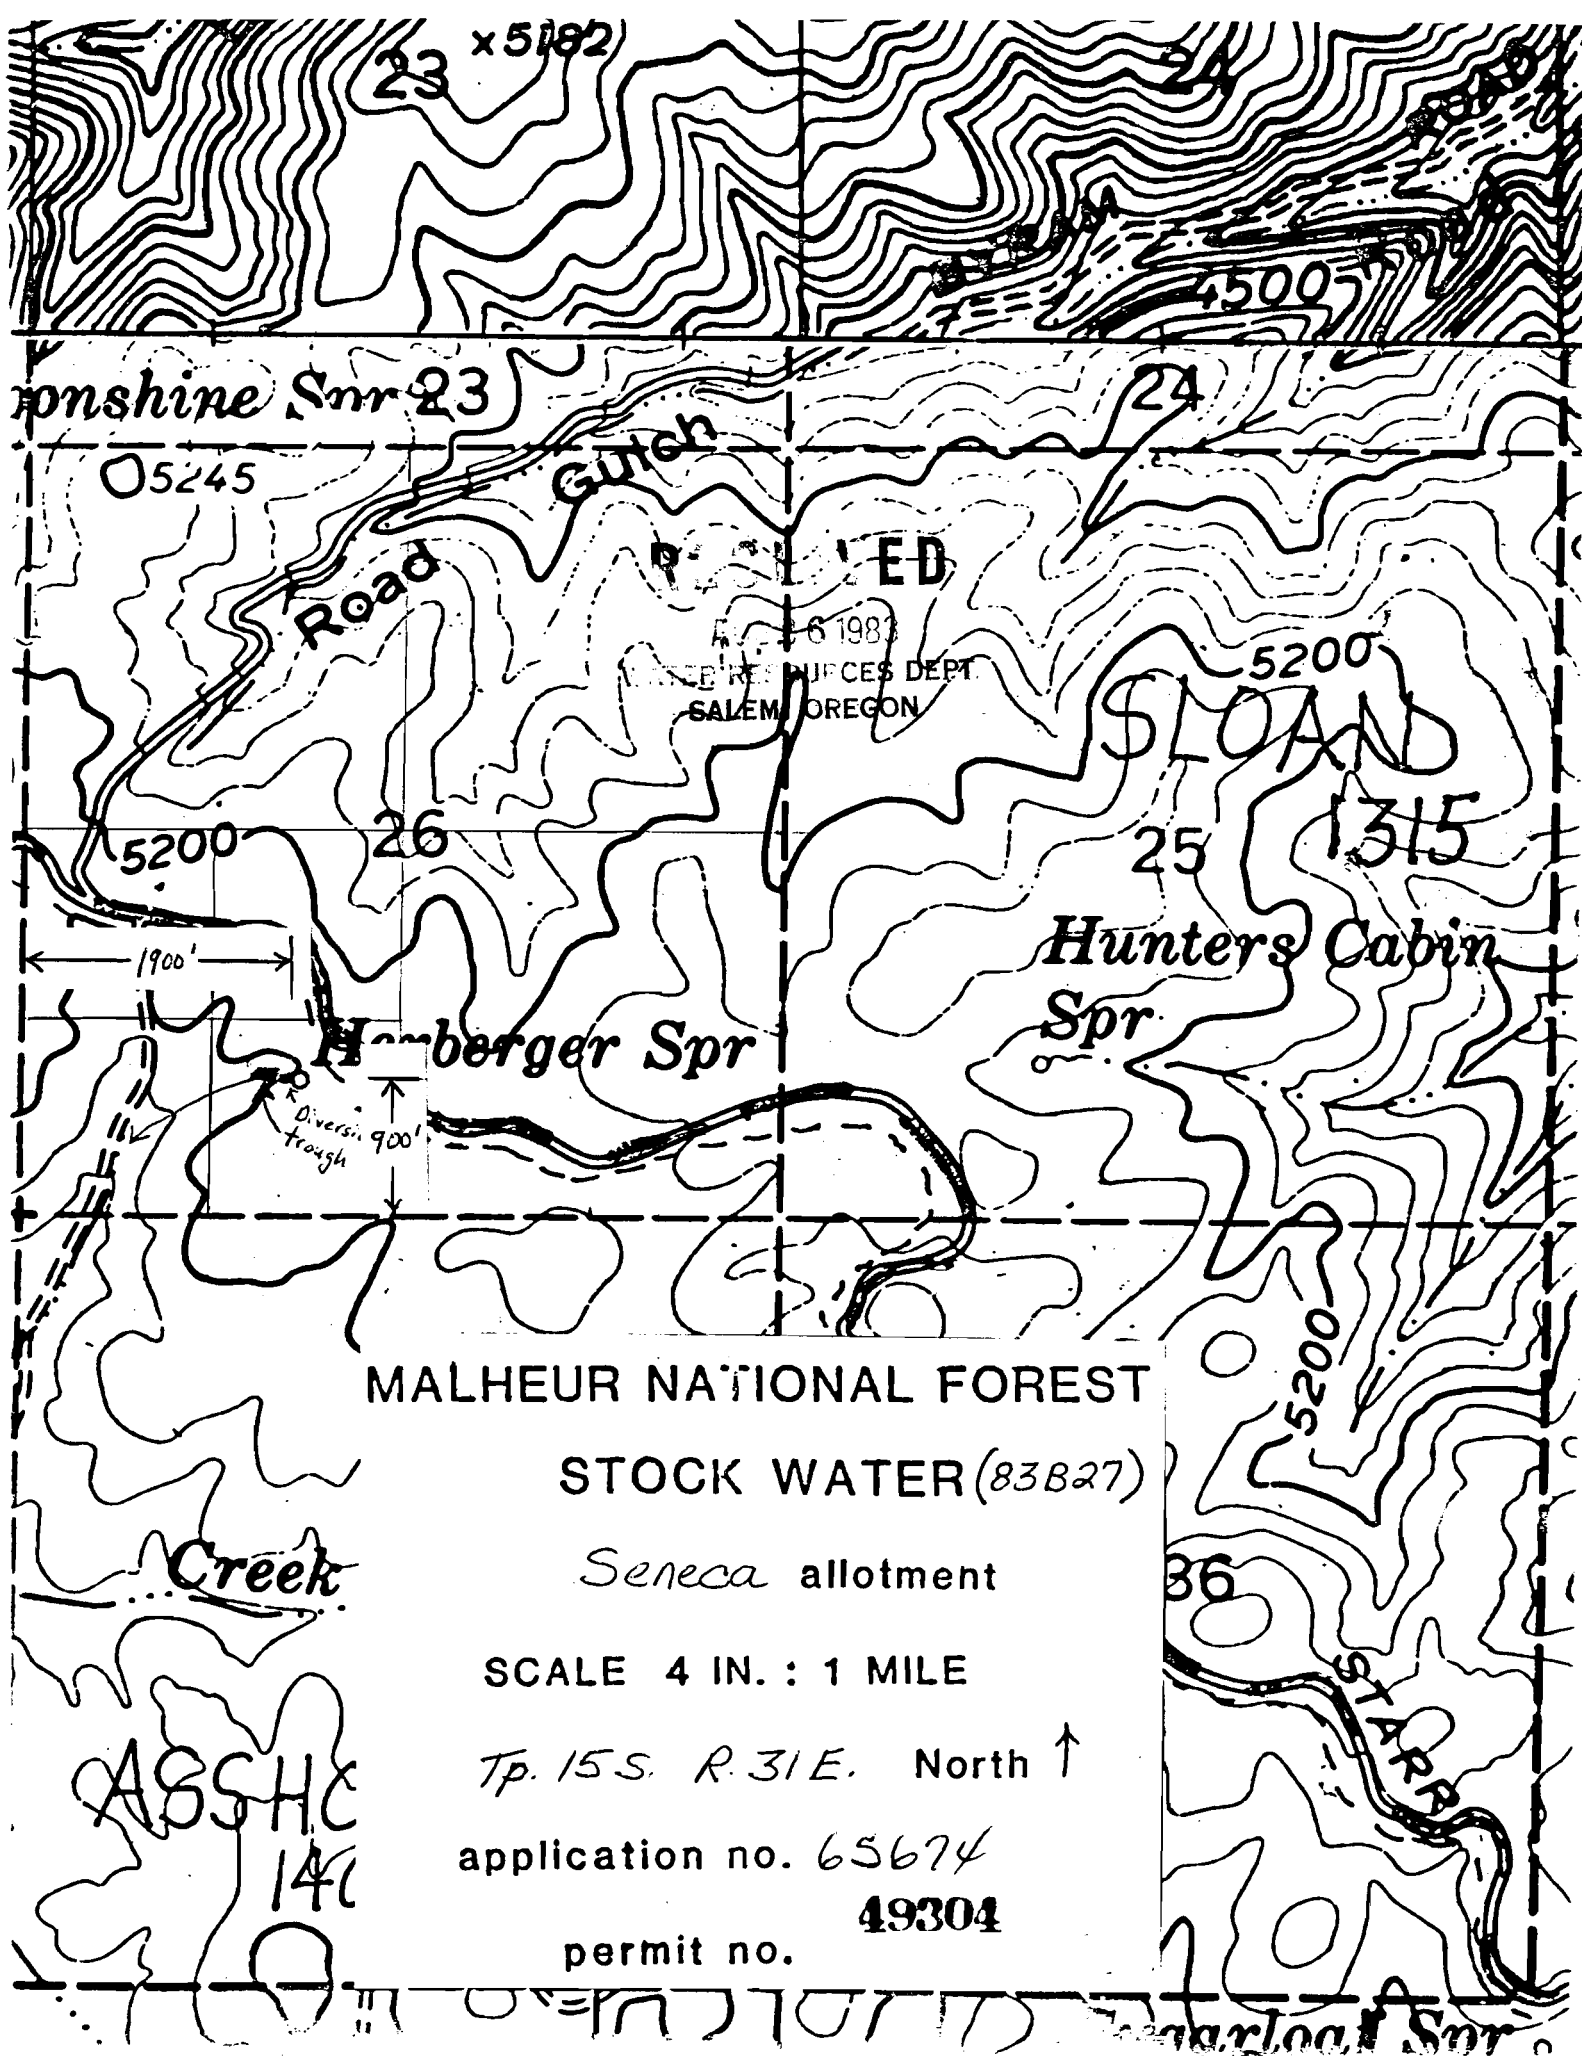

MALHEUR NATIONAL FOREST

STOCK WATER (83B27)

Seneca allotment

SCALE 4 IN. : 1 MILE

Tp. 15 S. R. 31 E. North ↑

application no. 65674

permit no. 49304

ASSHC
146

