


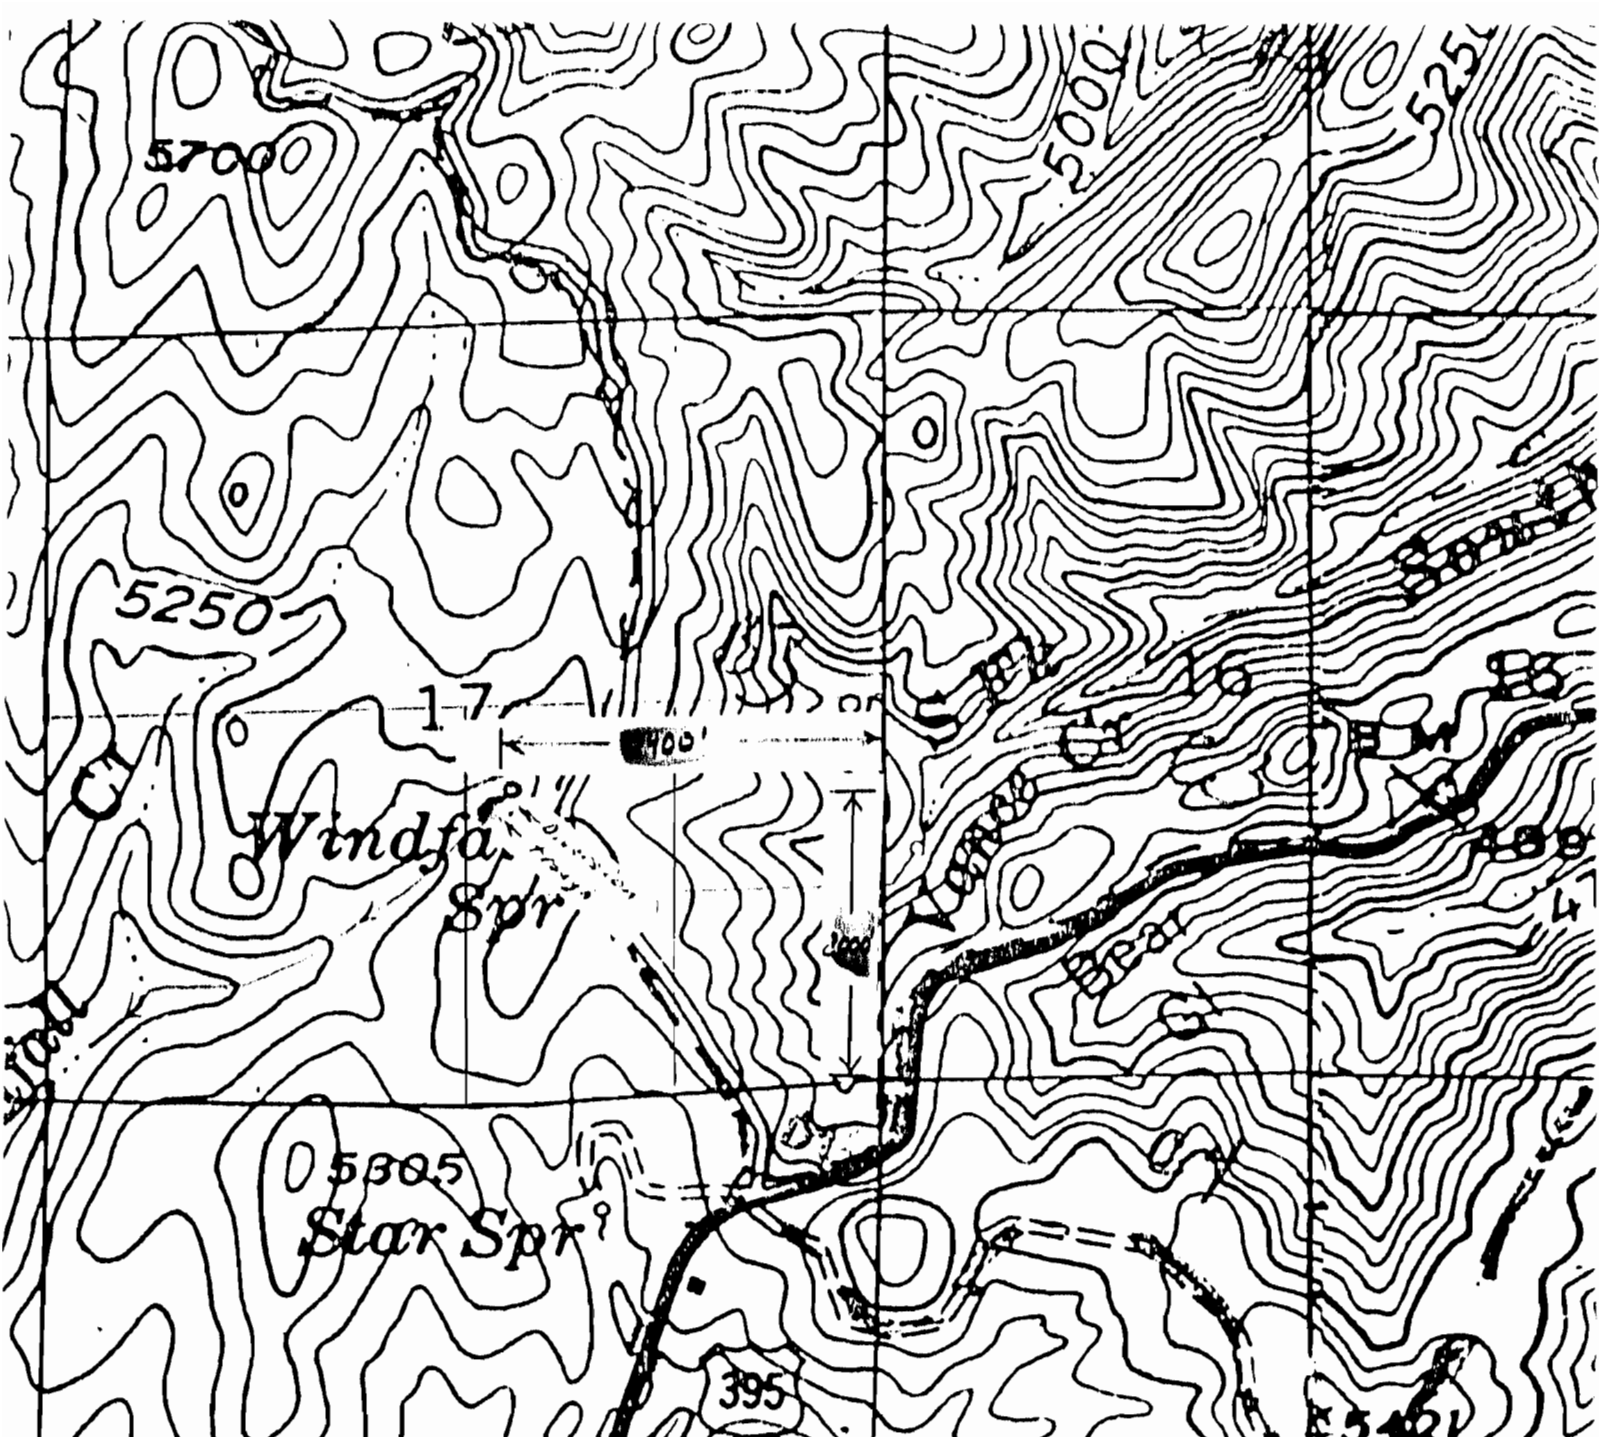

2 MALHEUR NATIONAL FOREST

STOCK WATER (85321)

Seneca allotment

SCALE 4 IN. : 1 MILE

Tp 15S. R31E. North

application no. 15076

FILED IN 49305

21
E

SALEM, OREGON