


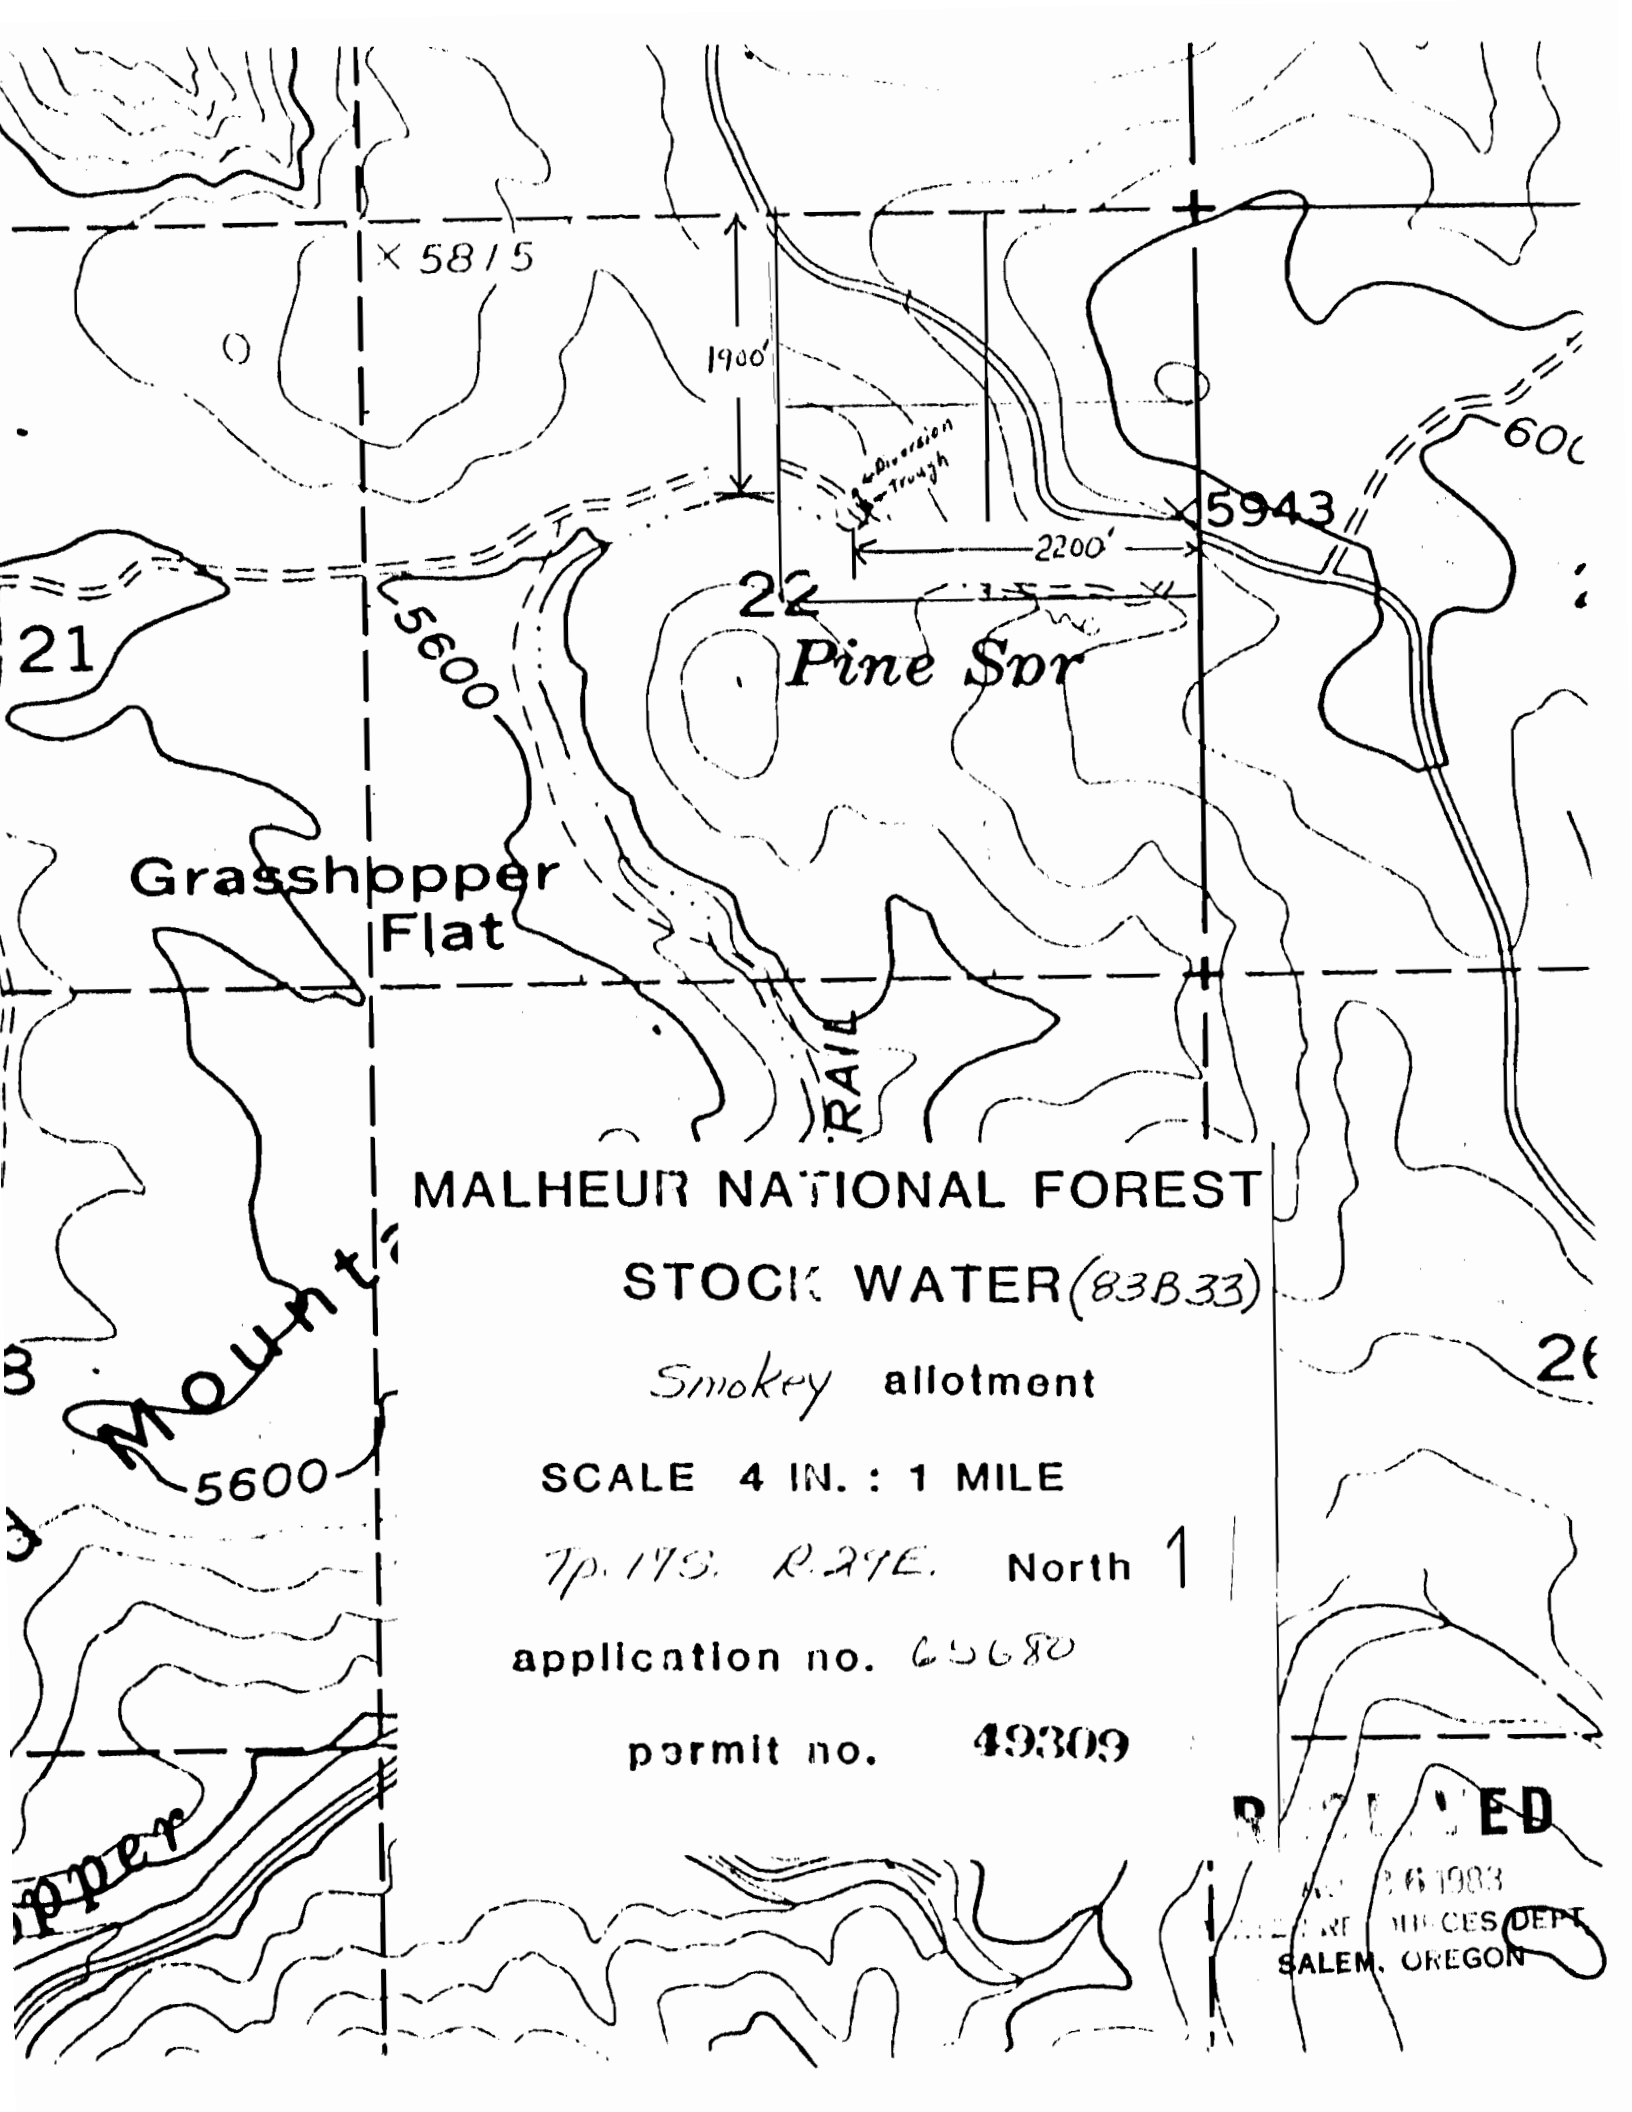

X 5815

1900'

Diversion
Trough

2200'

X 5943

600'

21

5600

22

Pine Spr

Grasshopper
Flat

RAIL

MALHEUR NATIONAL FOREST

STOCK WATER (83B33)

Smokey allotment

SCALE 4 IN. : 1 MILE

Tp. 17S. R. 27E. North 1

application no. 65680

permit no. 49309

RECEIVED

26 1983

SALEM, OREGON