


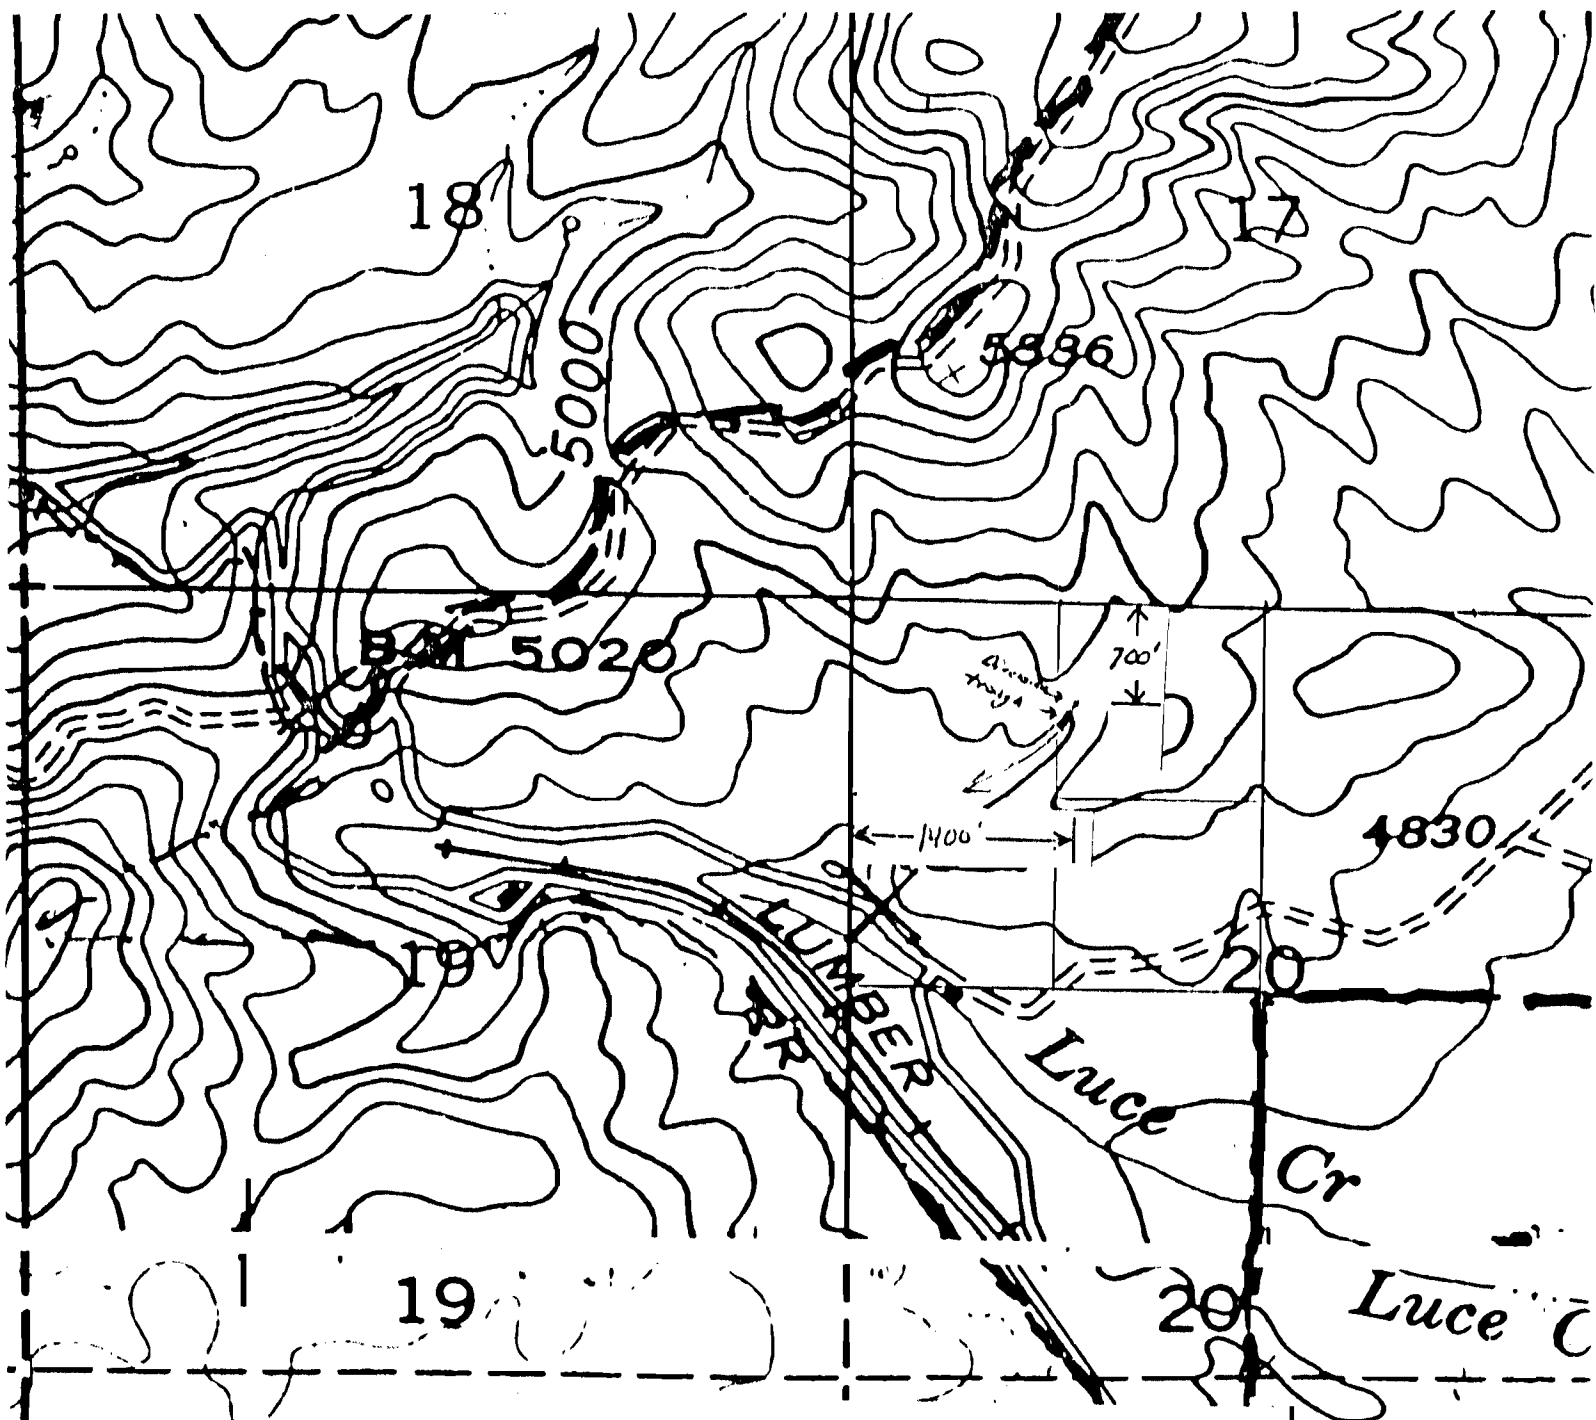

MALHEUR NATIONAL FOREST

STOCK WATER (83B34)

Dead Horse allotment

SCALE 4 IN. : 1 MILE

Tp. 15 S. R. 30 E. North 1

application no. 65681
 permit no. 49310

RECEIVED
 APR 26 1988
 WILDERNESS DIVISION
 SALEM, OREG.