


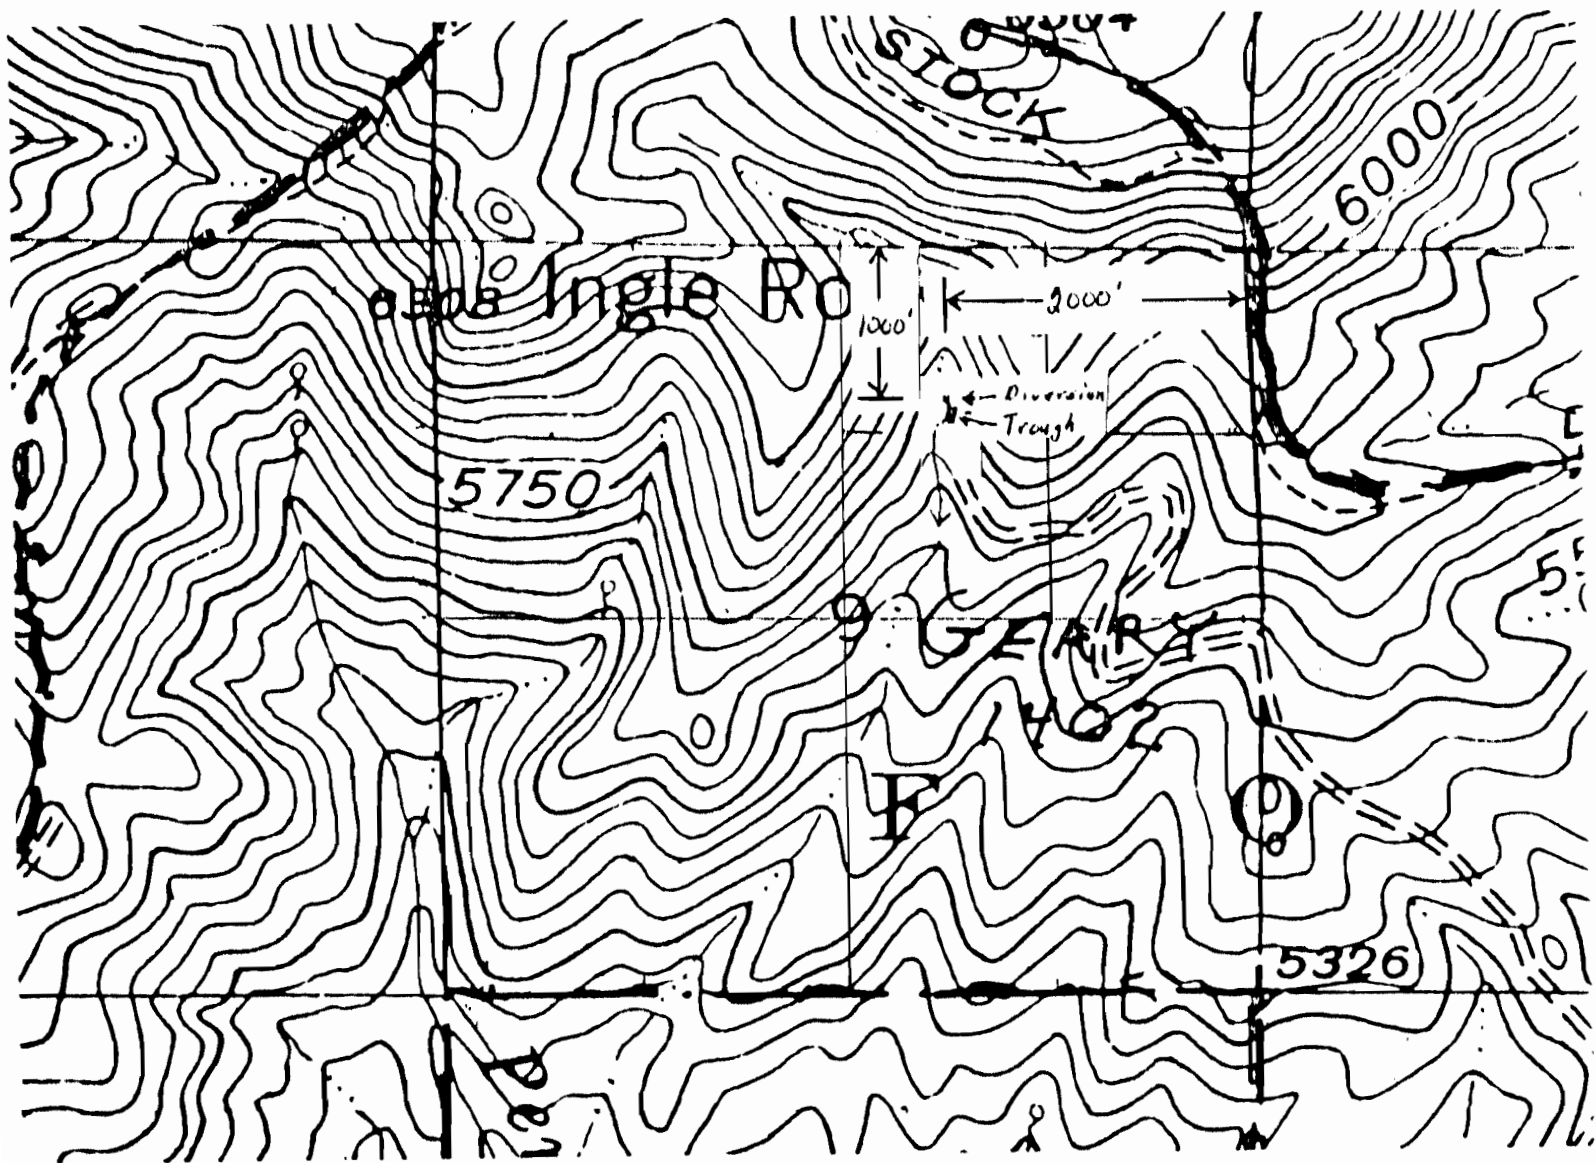

MALHEUR NATIONAL FOREST

STOCK WATER (83B35)

Hanscombe allotment

SCALE 4 IN. : 1 MILE

Tp. 15 S. R 30 E. . North

application no. 65682

permit no. **49311**

RECEIVED

APR 26 1983

UNITED STATES DEPT OF AGRICULTURE
SALEM, OREGON