


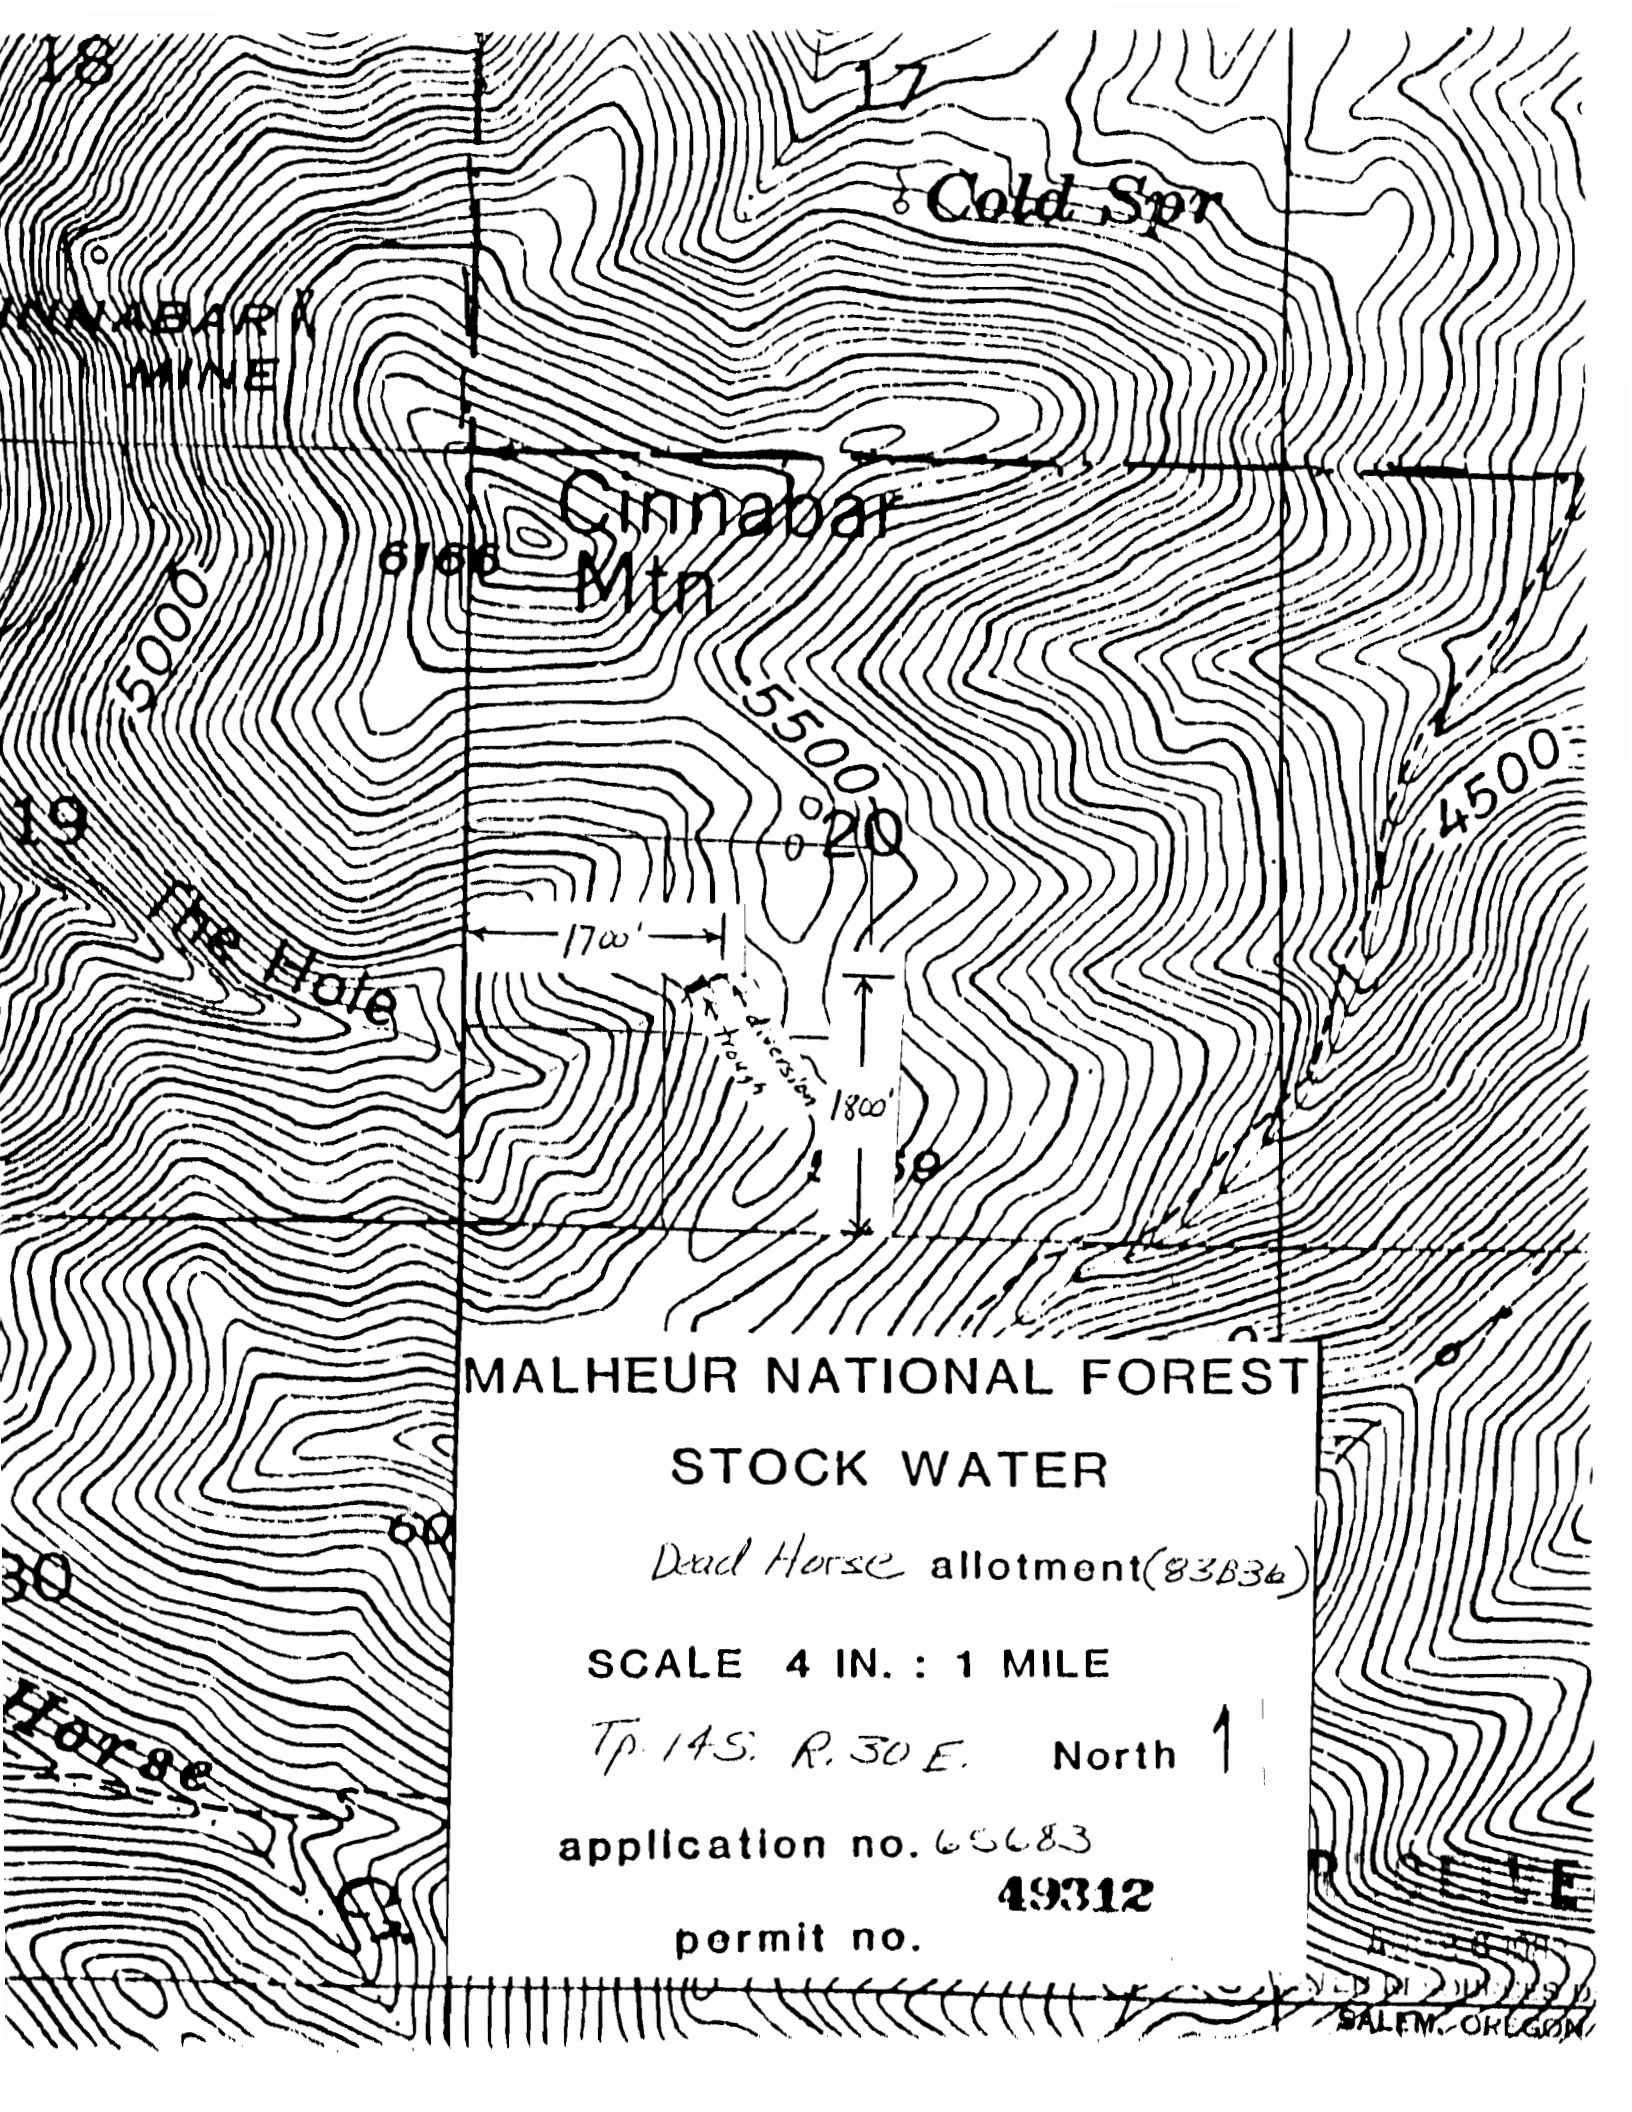

Cold Spr

CINNABAR MINE

Cinnabar Mtn

6166

5500

4500

Dead Horse

1700'

1800'

MALHEUR NATIONAL FOREST

STOCK WATER

Dead Horse allotment(83836)

SCALE 4 IN. : 1 MILE

Tp. 14S. R. 30 E. North 1

application no. 65683

49312

permit no.

SALEM, OREGON