


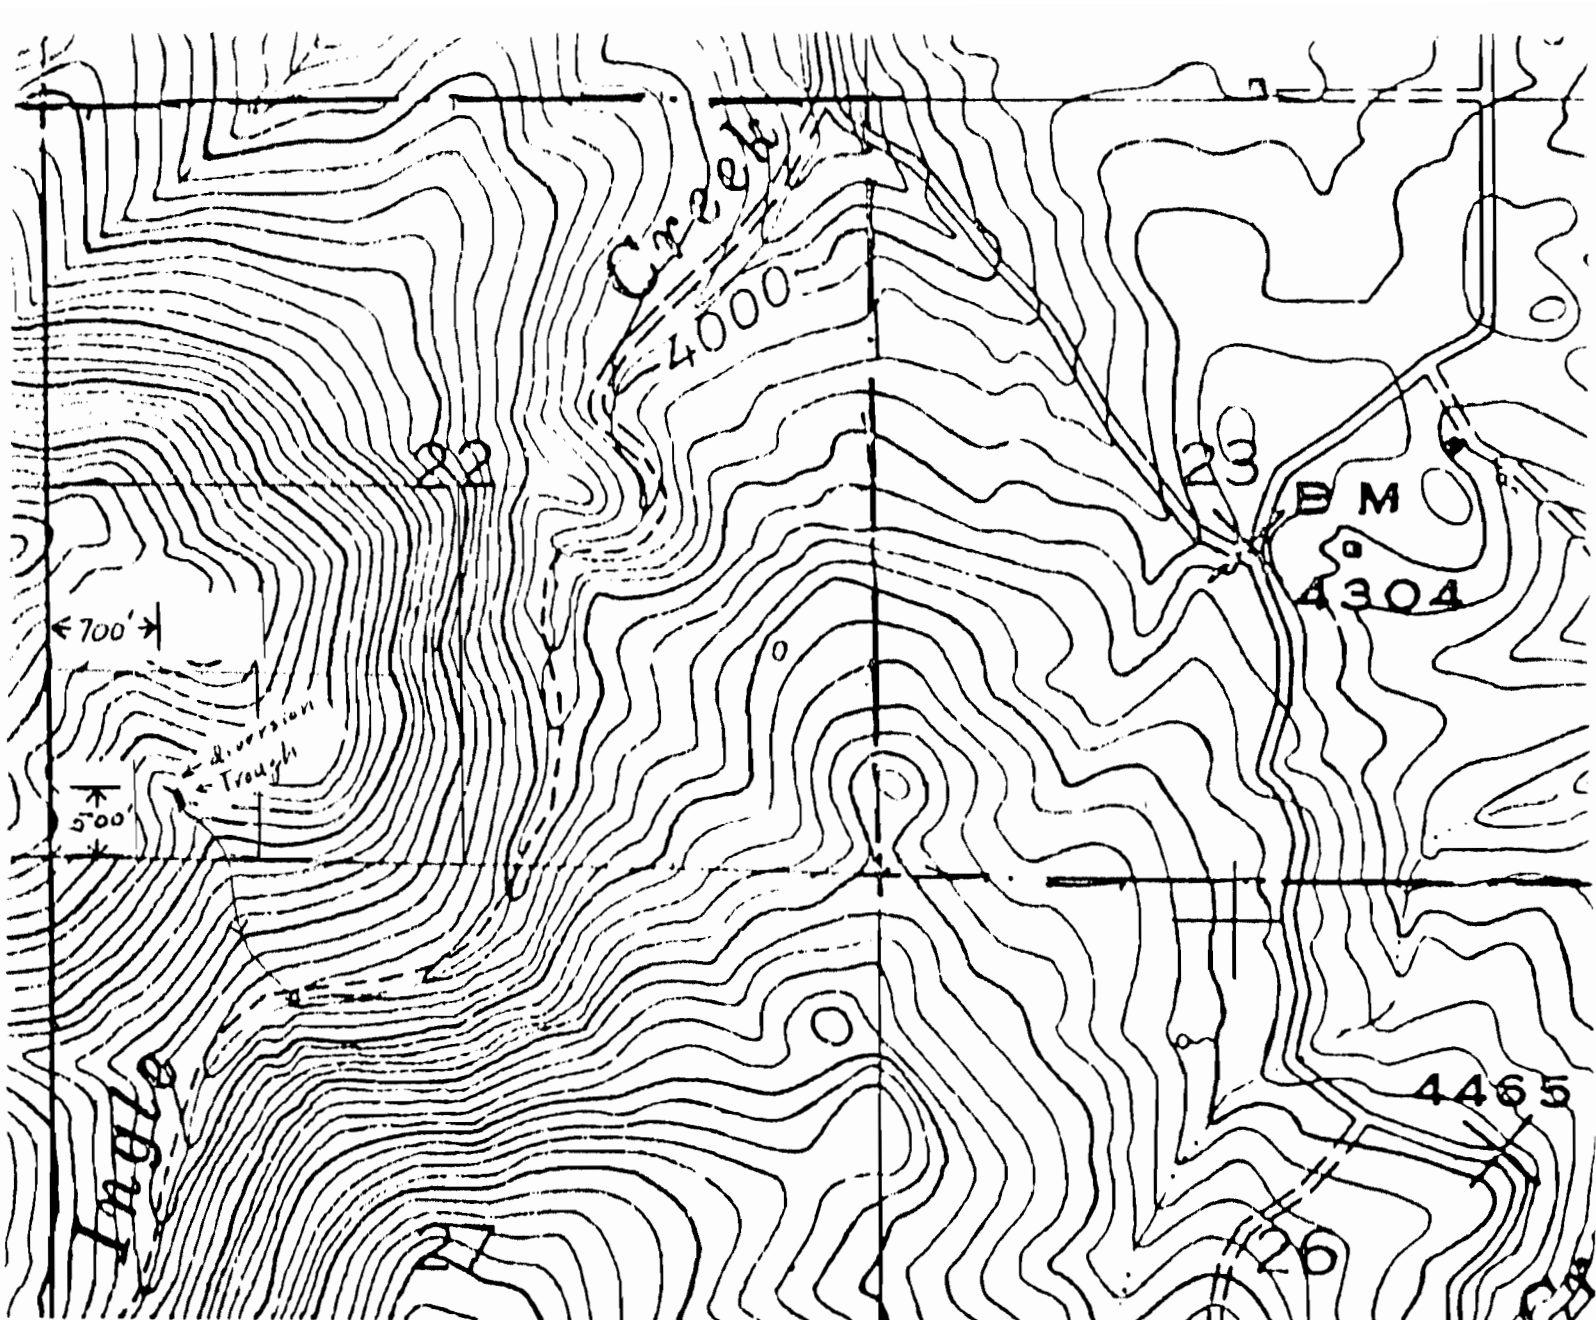

MALHEUR NATIONAL FOREST

STOCK WATER

Dead Horse allotment (83B37)

SCALE 4 IN. : 1 MILE

Tp. 14 S. R. 30 E. North ↑

application no. 65484

permit no. **49313**

SALEM, OREGON