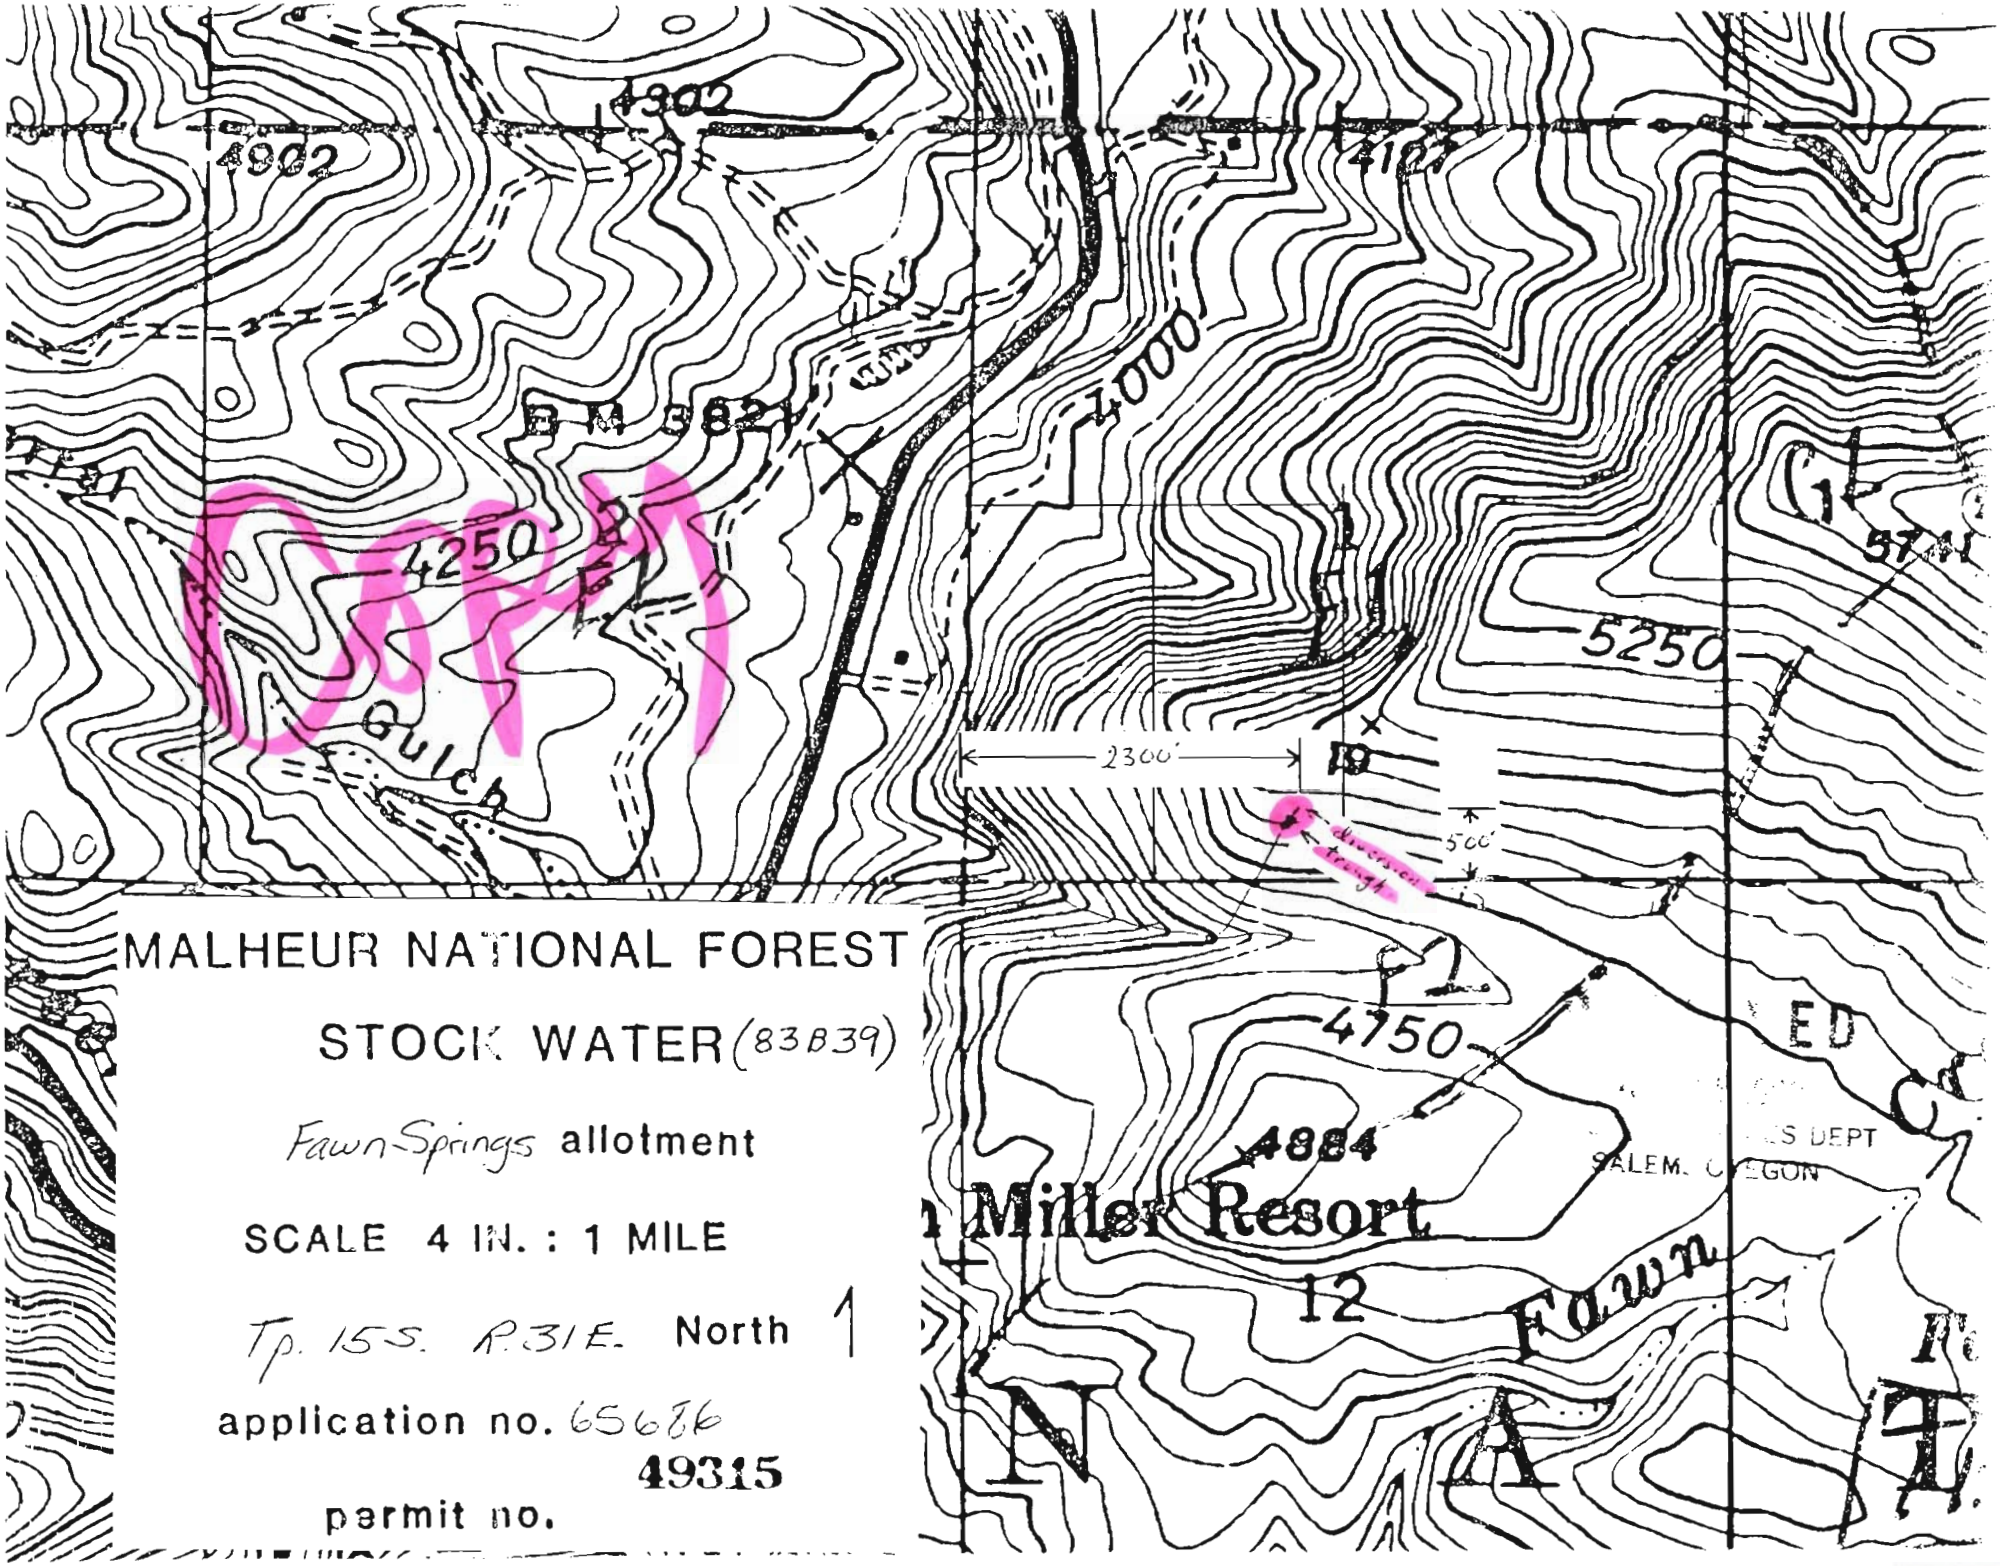

MALHEUR NATIONAL FOREST

STOCK WATER (83839)

Fawn Springs allotment

SCALE 4 IN. : 1 MILE

Tp. 15S. R.31E. North

application no. 65686

permit no. 49315