


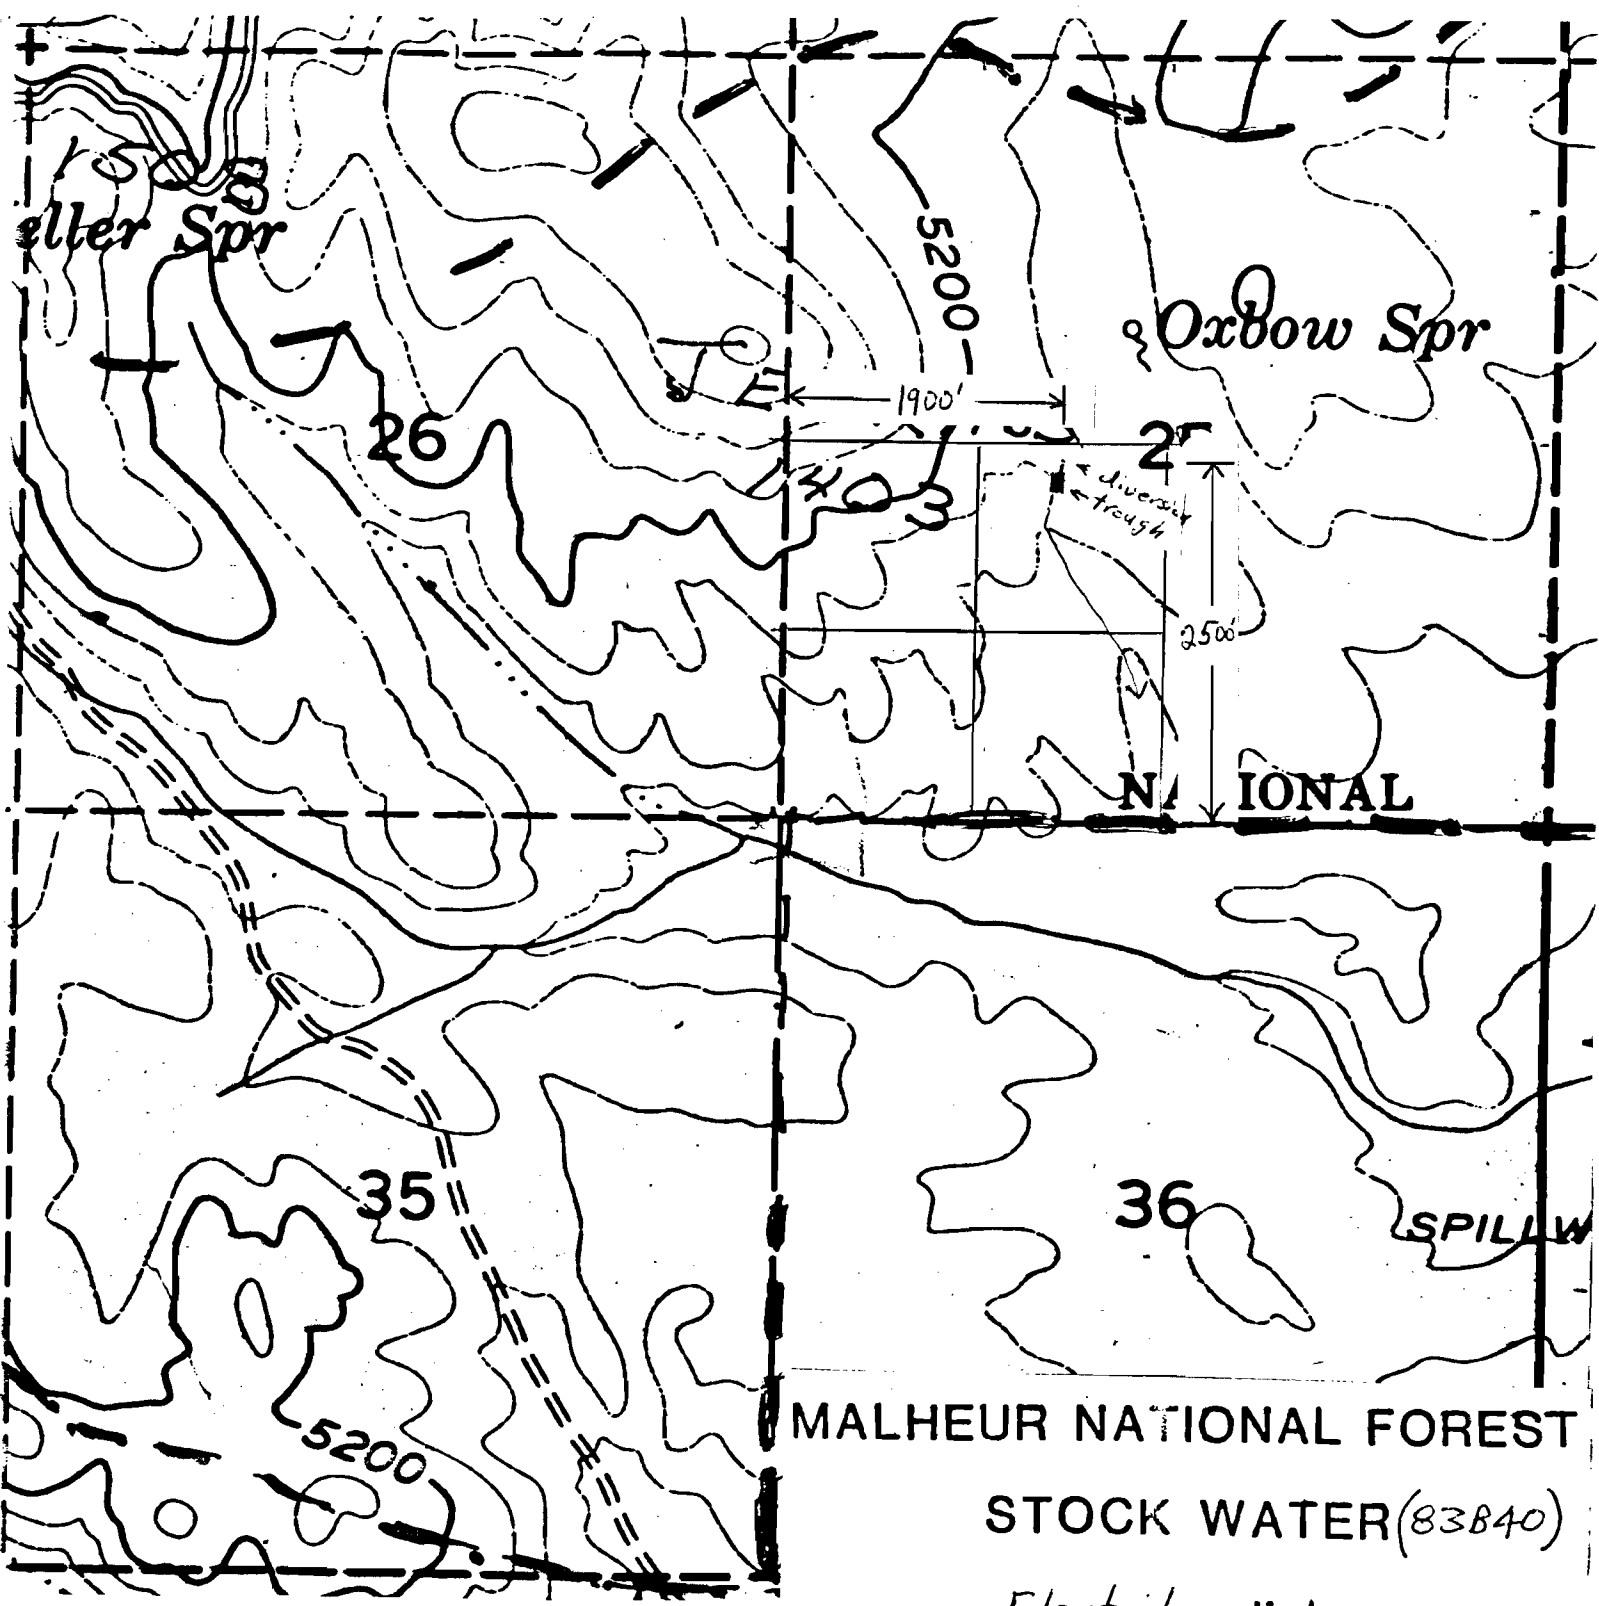

RECEIVED
APR 26 1989
U.S. DEPT. OF AGRICULTURE
SALEM, OREGON

MALHEUR NATIONAL FOREST
STOCK WATER (83840)

Flagtail allotment

SCALE 4 IN. : 1 MILE

Tp. 15-S. R. 29-E. North ↑

application no. 65687
Permit no. 49316