


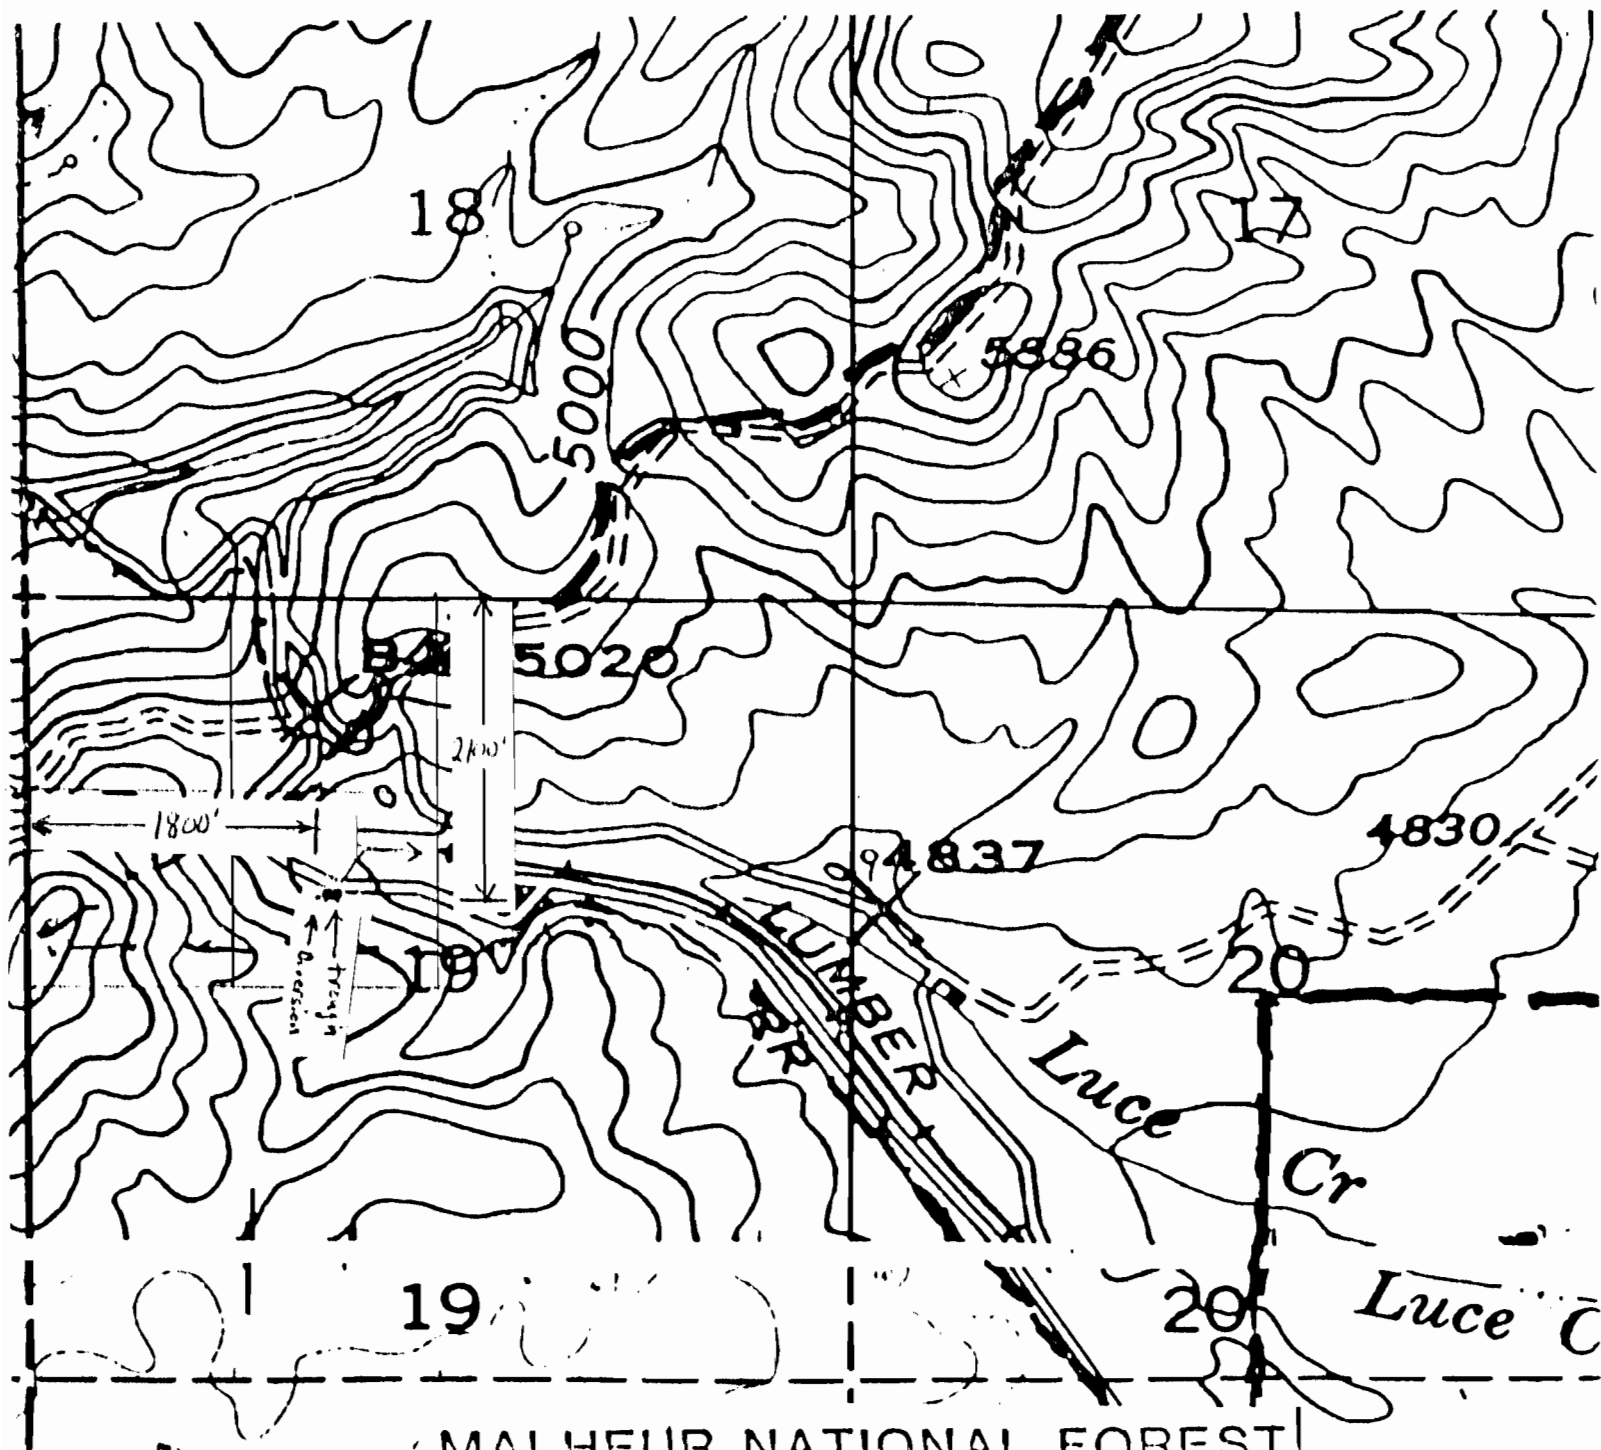

MALHEUR NATIONAL FOREST

STOCK WATER (83B41)

Flagtail allotment

SCALE 4 IN. : 1 MILE

Tp. 15S. R. 30E. North

application no. 65688
Permit no. 49317

RECEIVED

APR 16 1983
SALEM, OREGON