

LOGAN  
Steagall Spr

SALEM, OREGON

5040

30

2300

2100'

Trough  
diversion

X 5542

MALHEUR NATIONAL FOREST

STOCK WATER (83845)  
Map #1 of 2 (Bull Spring)

Antelope allotment

SCALE 4 IN. : 1 MILE


Tp. 16 S. R. 33 E. North ↑

application no. 65692

permit no. 49321

5200

31

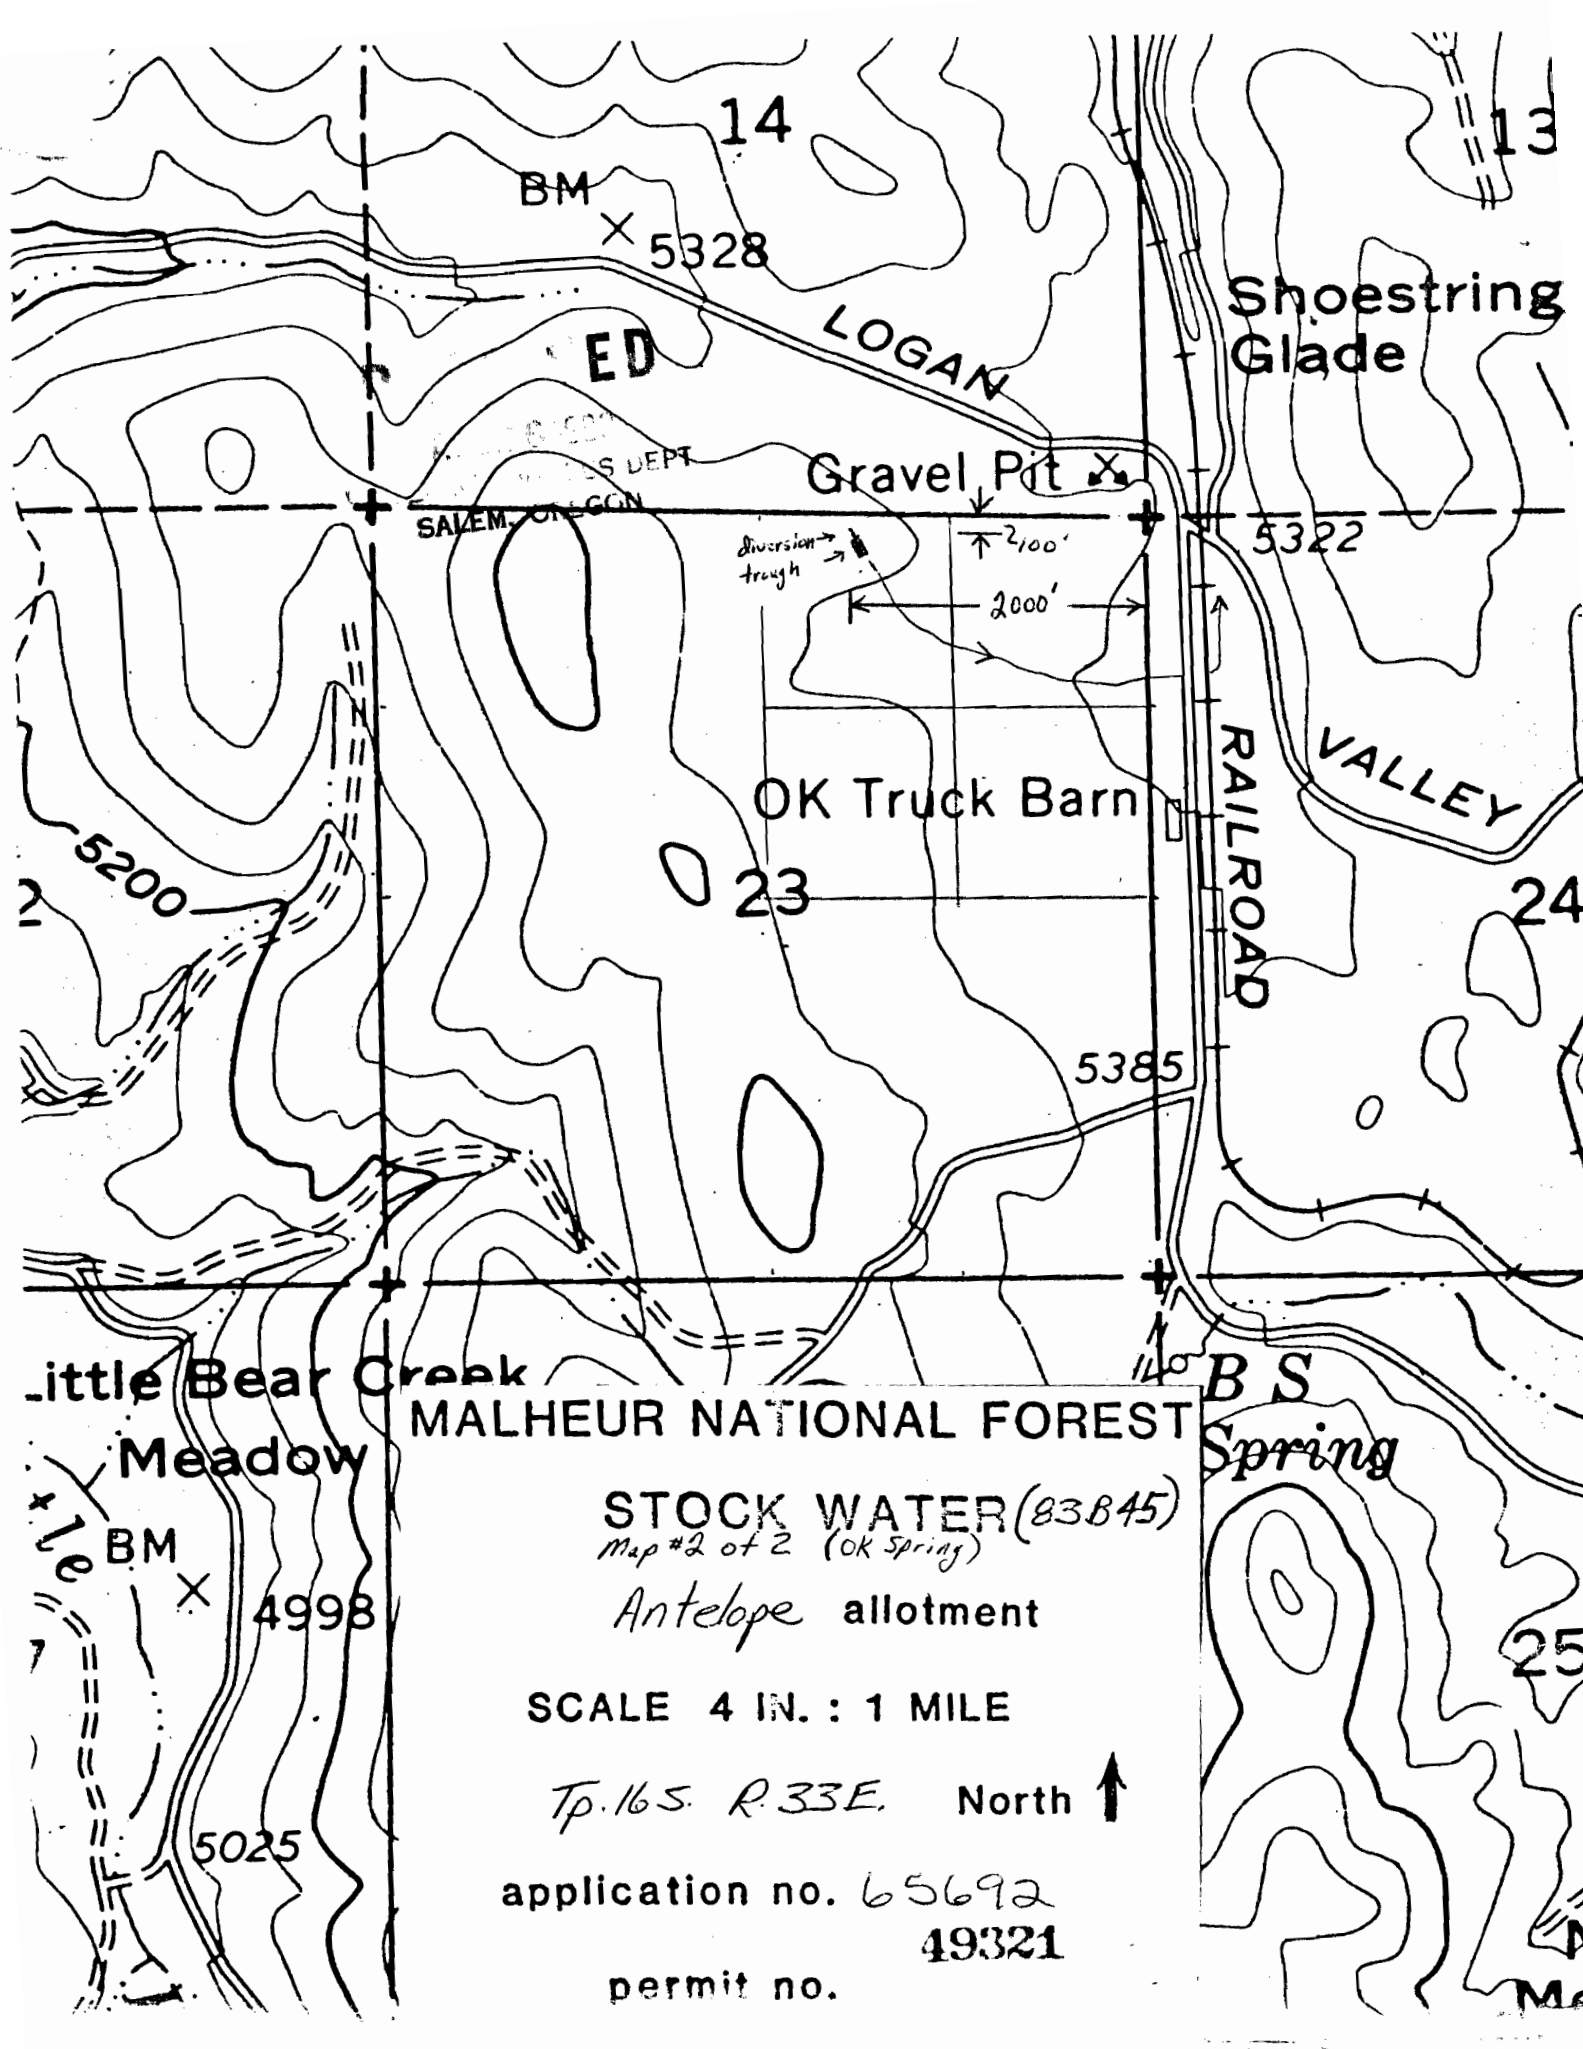

14

13

BM X 5328

ED

LOGAN

Shoestring Glade

Gravel Pit X

SALEM, OREGON

diversion trough

2100'

2000'

5322

OK Truck Barn

RAILROAD VALLEY

23

24

5200

5385

Little Bear Creek Meadow

MALHEUR NATIONAL FOREST

BS Spring

STOCK WATER (83B45)  
Map #2 of 2 (OK Spring)

Antelope allotment

SCALE 4 IN. : 1 MILE

Tp. 16S. R. 33E. North ↑

application no. 65692

49321

permit no.

BM X 4998

5025

25

M  
Ma