


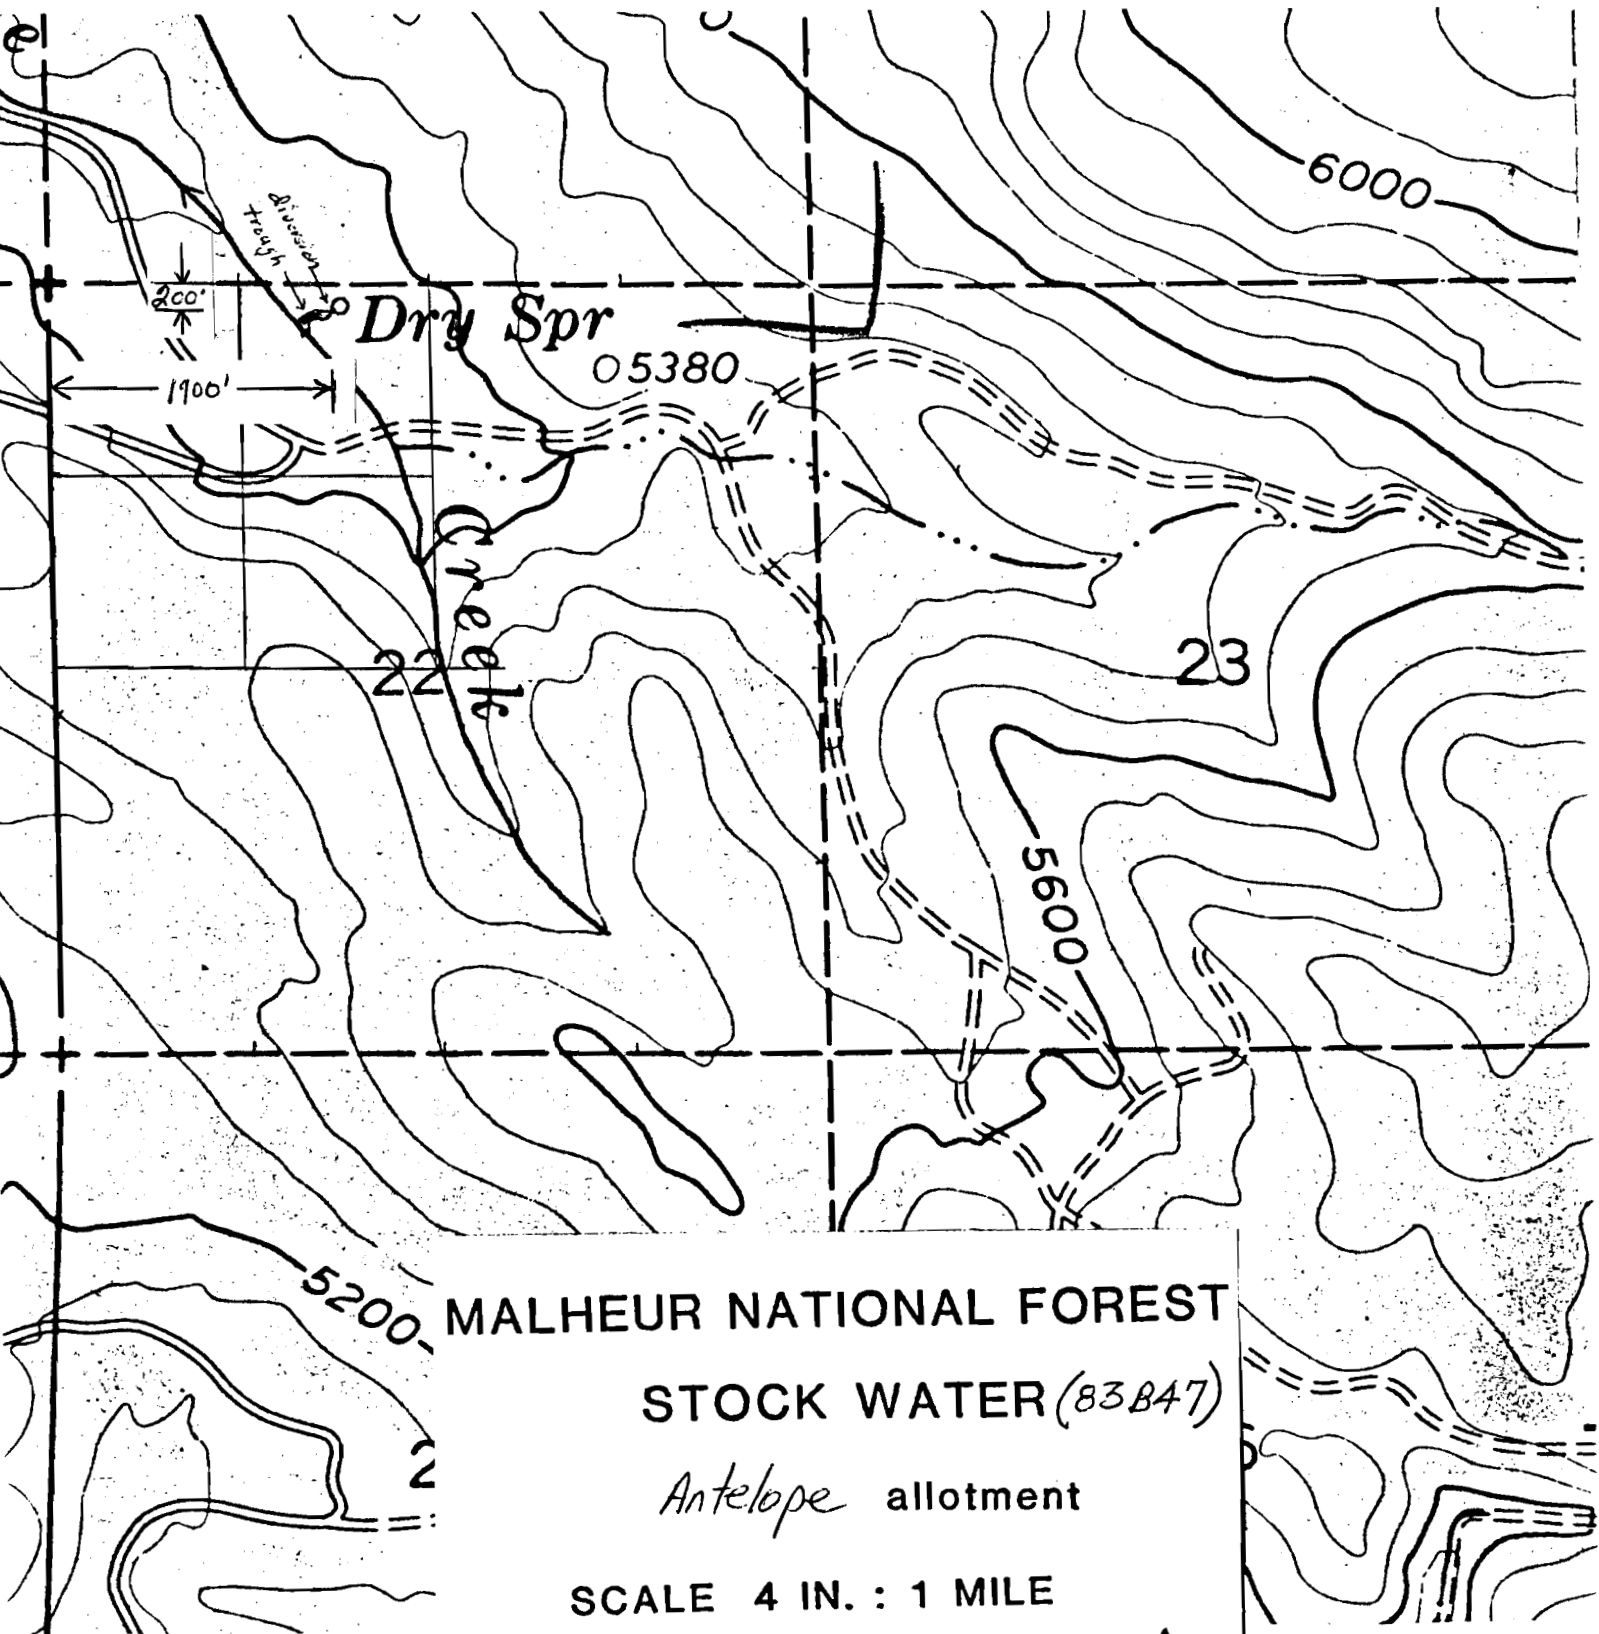

MALHEUR NATIONAL FOREST

STOCK WATER (83B47)

Antelope allotment

SCALE 4 IN. : 1 MILE

Tp. 17S. R. 32E. North ↑

application no. 65694

permit no. 49322

ED
APR 26 1983
WILDERNESS DEPT
SALEM, OREGON