


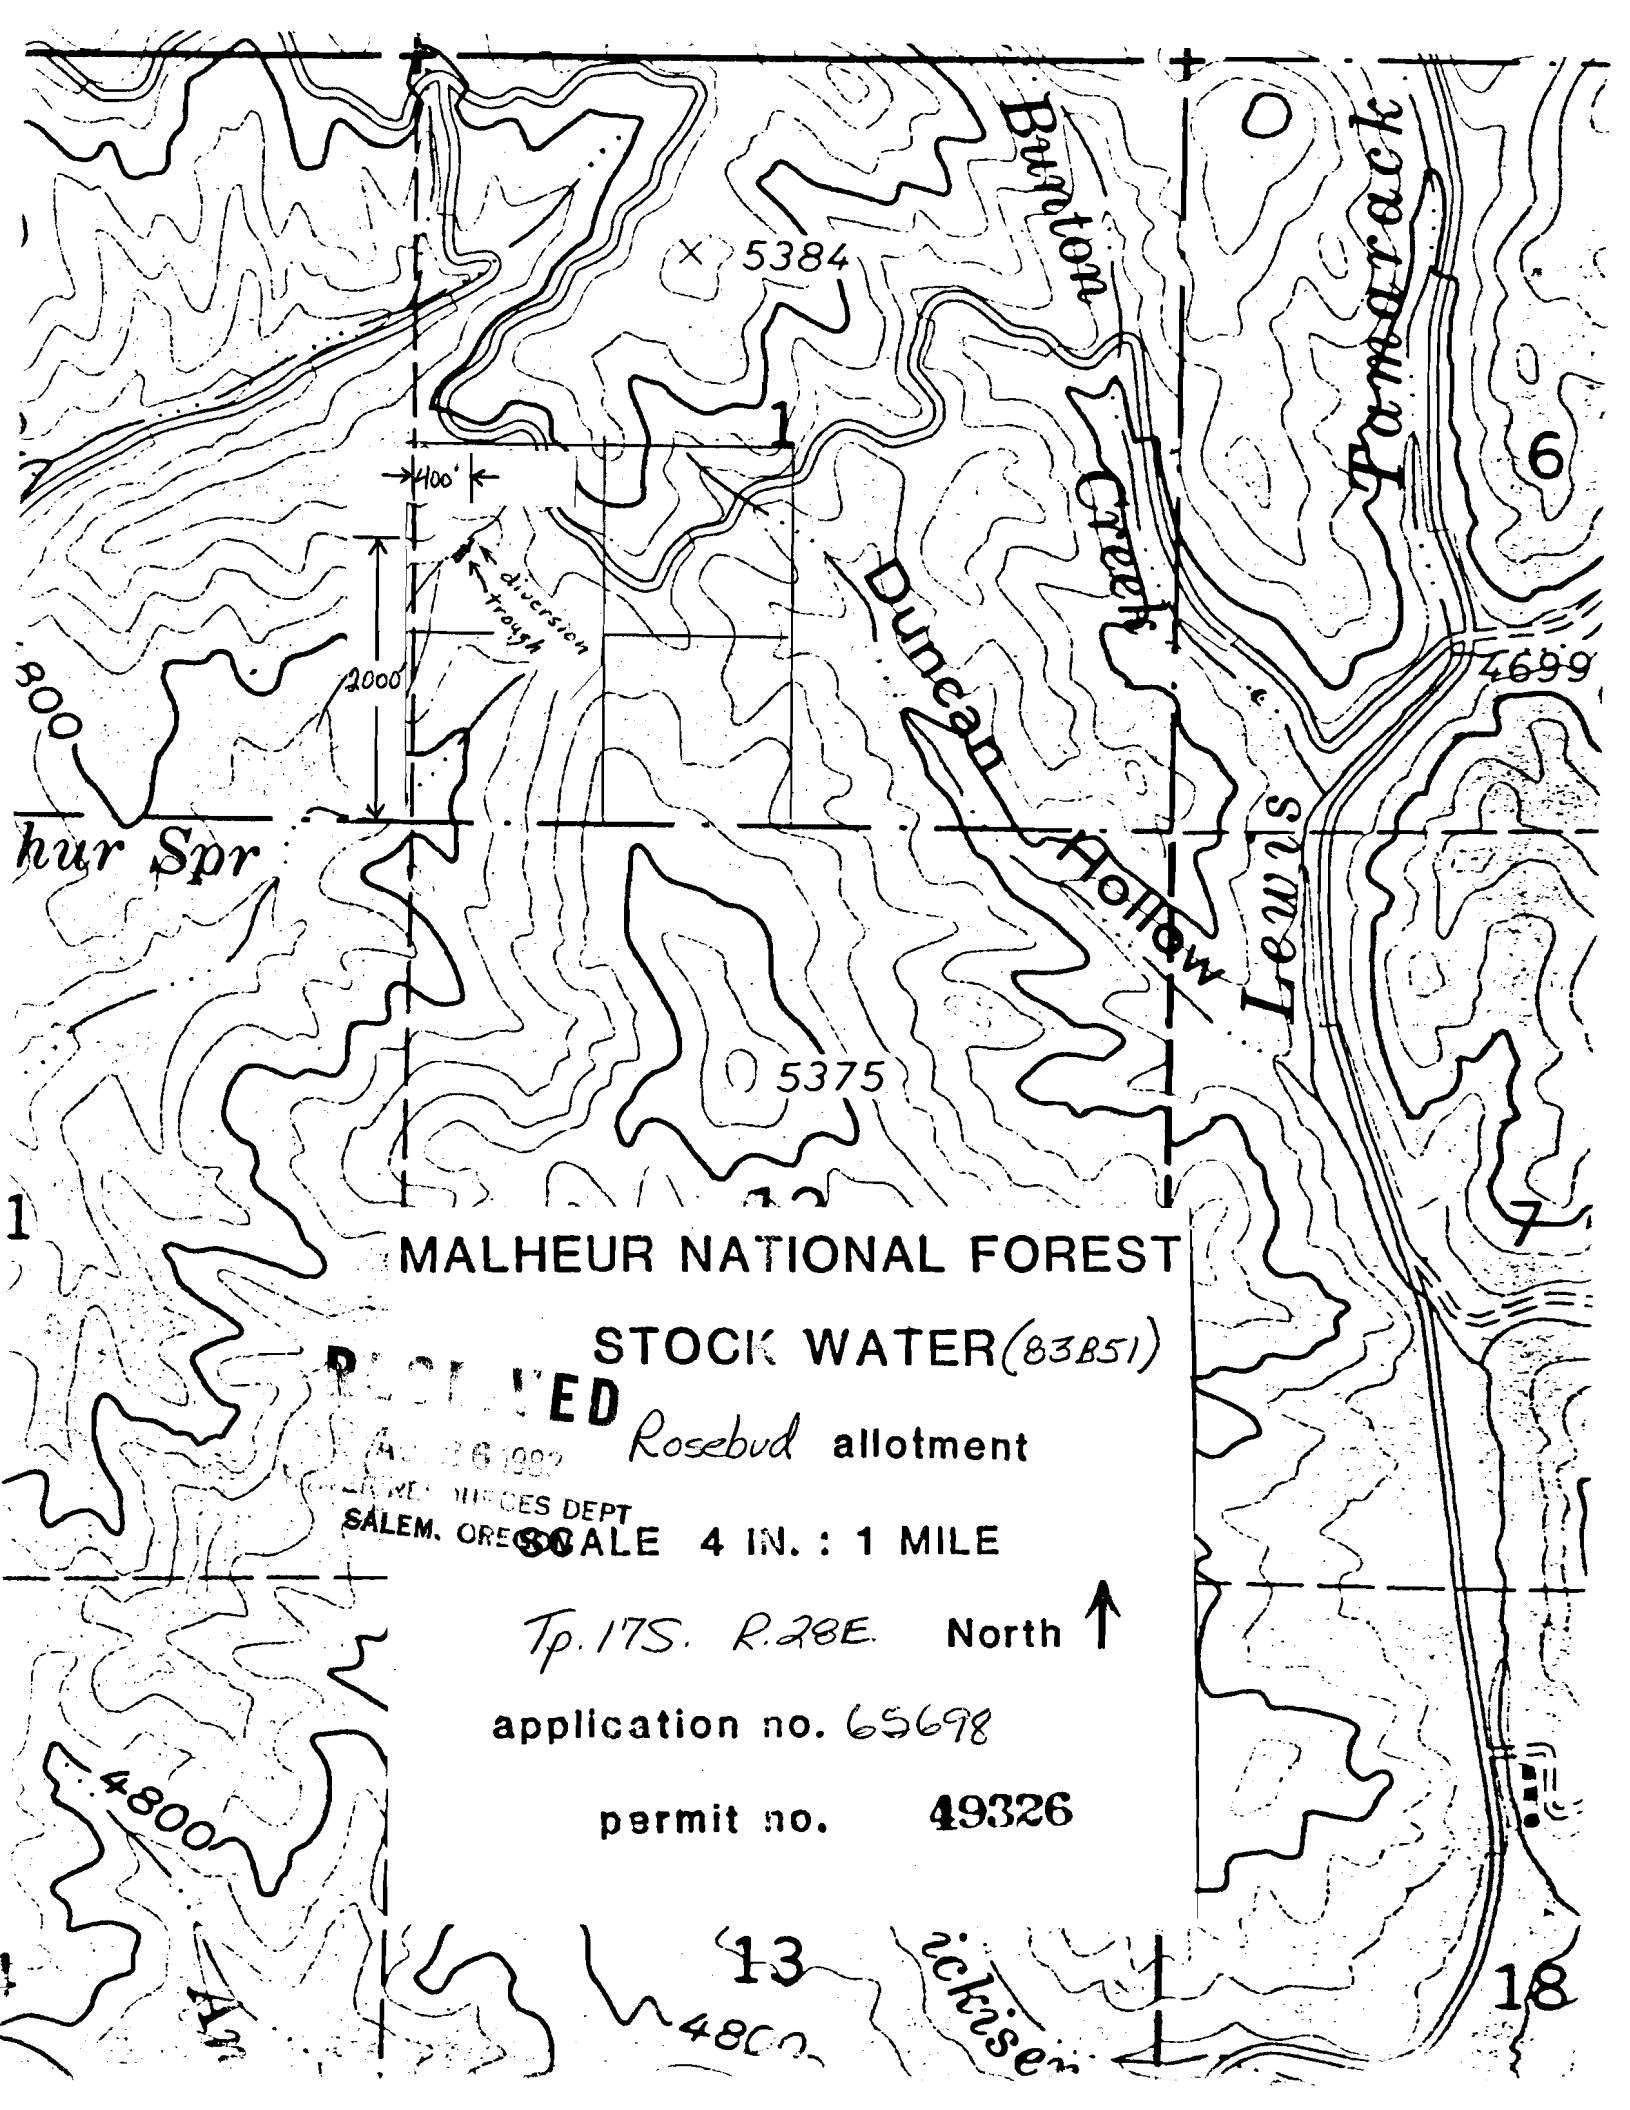

MALHEUR NATIONAL FOREST

STOCK WATER (83B51)

RECEIVED

Rosebud allotment

APR 26 1992


SALEM, ORE

SCALE 4 IN. : 1 MILE

Tp. 17S. R. 28E. North ↑

application no. 65698

permit no. 49326

13

4800

richsen

18