


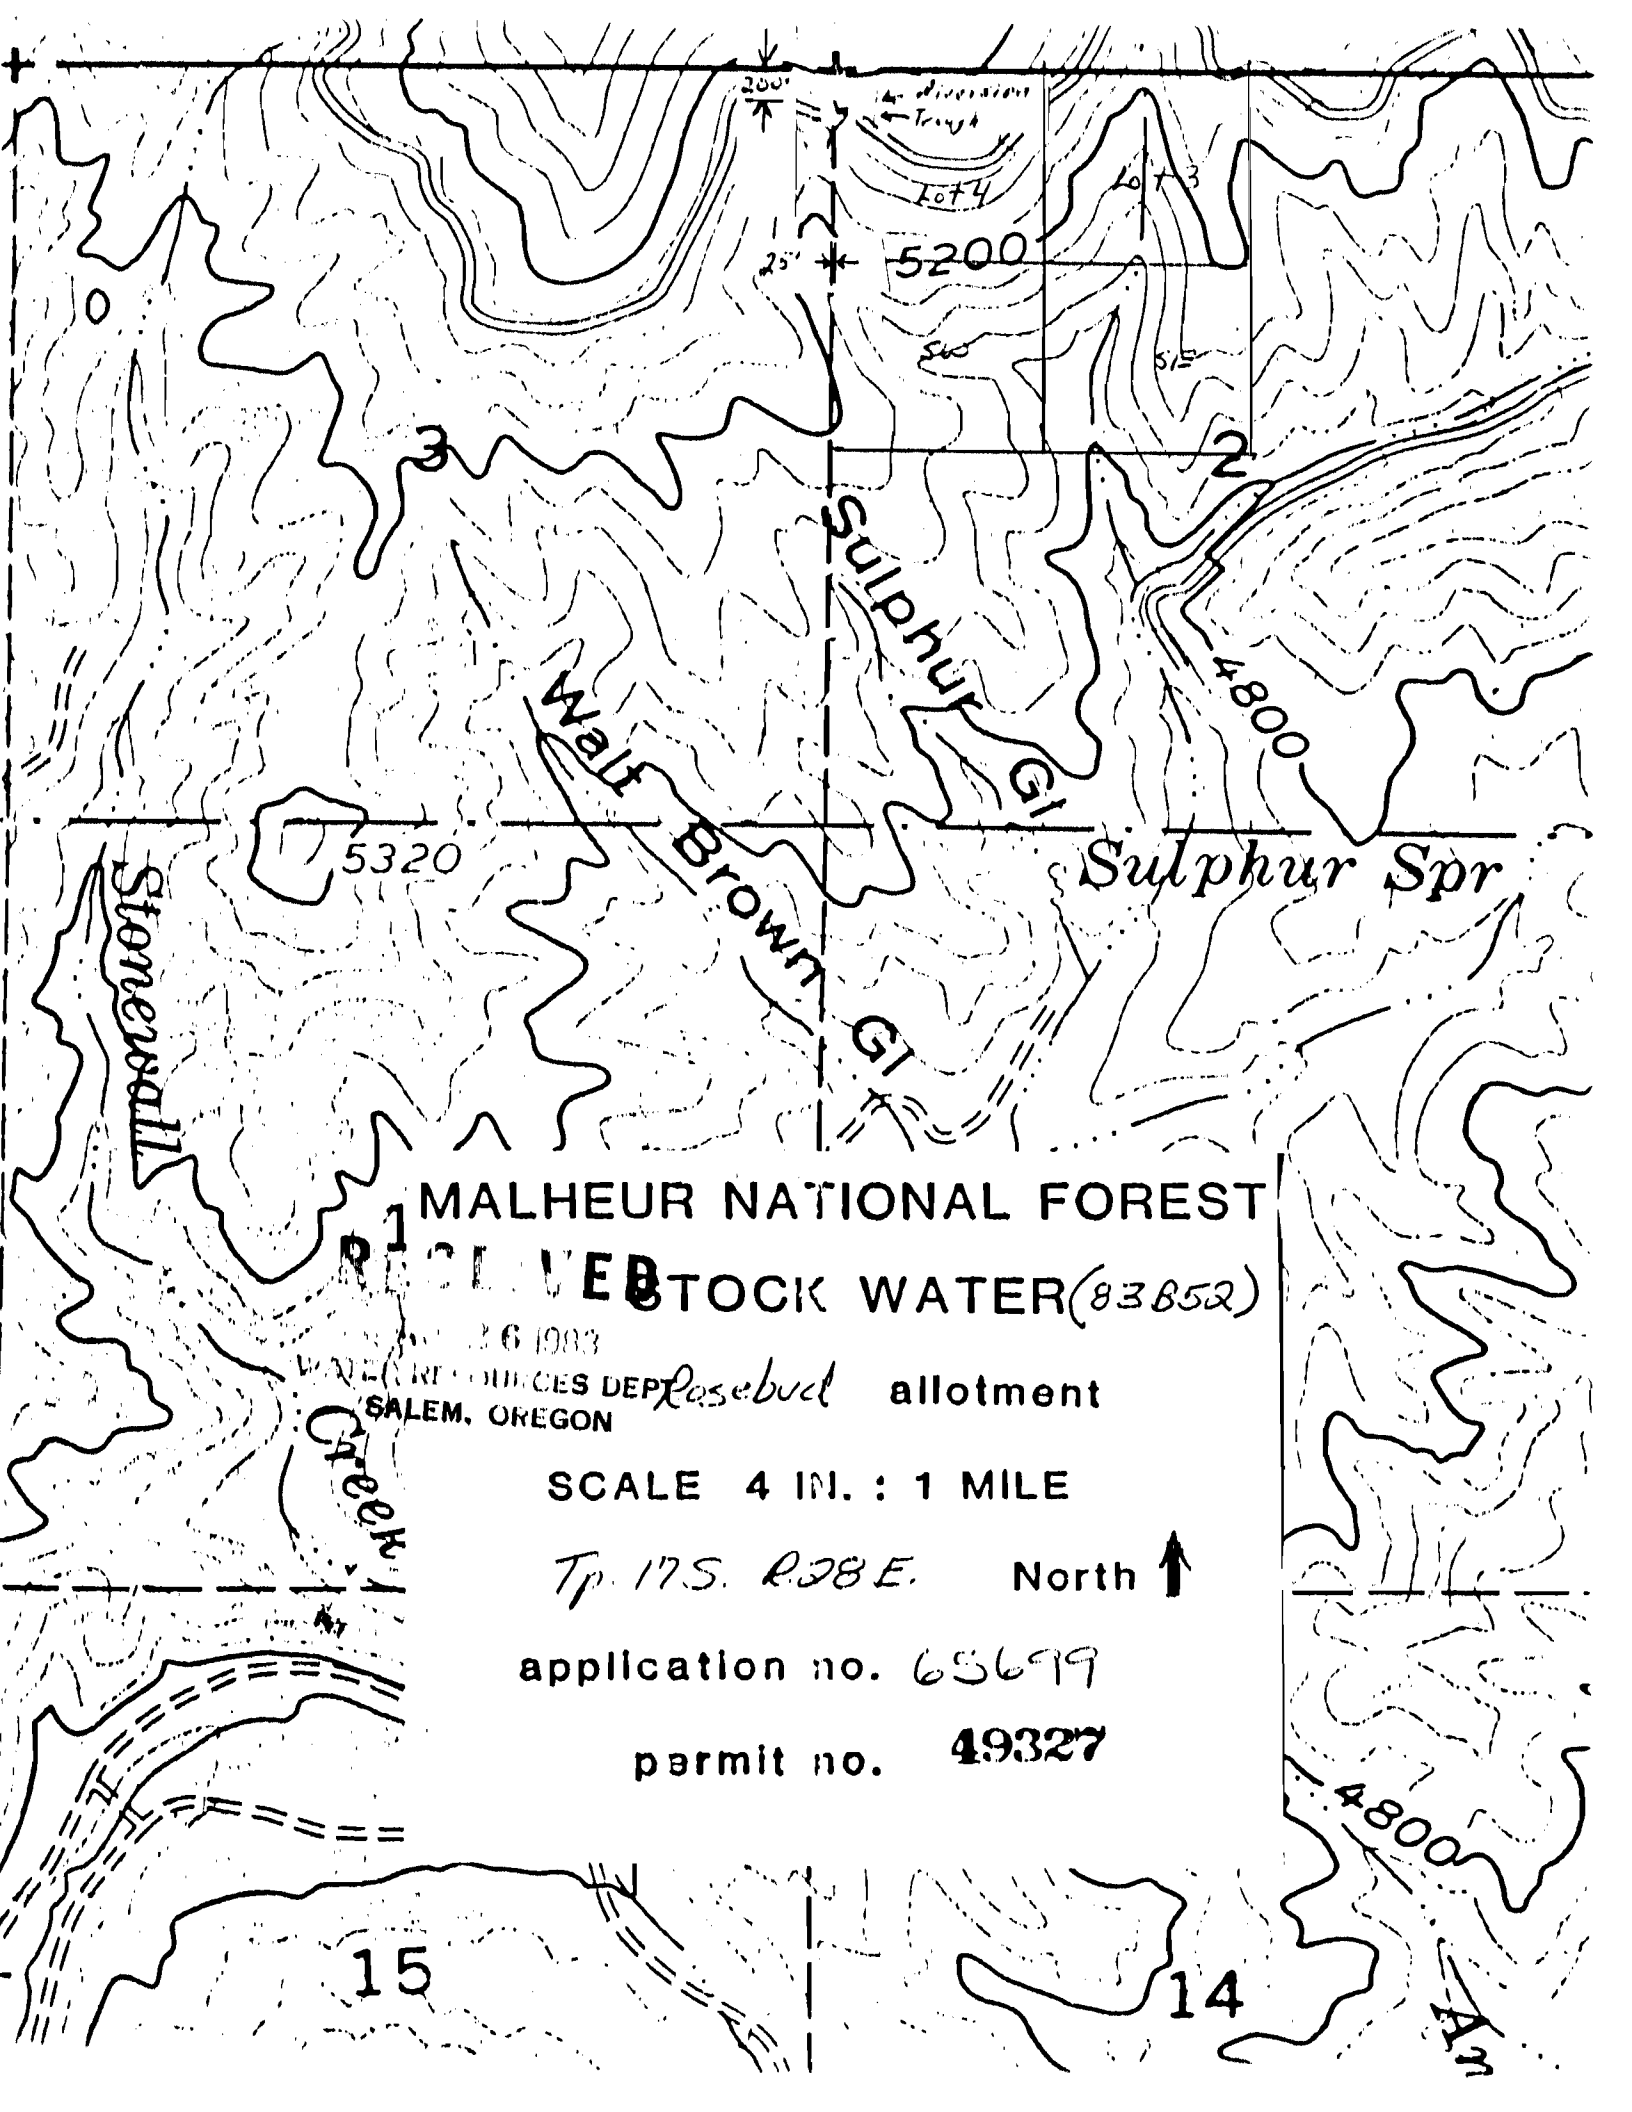

MALHEUR NATIONAL FOREST

PICKLEVE STOCK WATER (83852)

NOV 26 1983
WATER RESOURCES DEPT
SALEM, OREGON

Rosebud allotment

SCALE 4 IN. : 1 MILE

Tp. 17S. R28E. North ↑

application no. 65699

permit no. 49327