


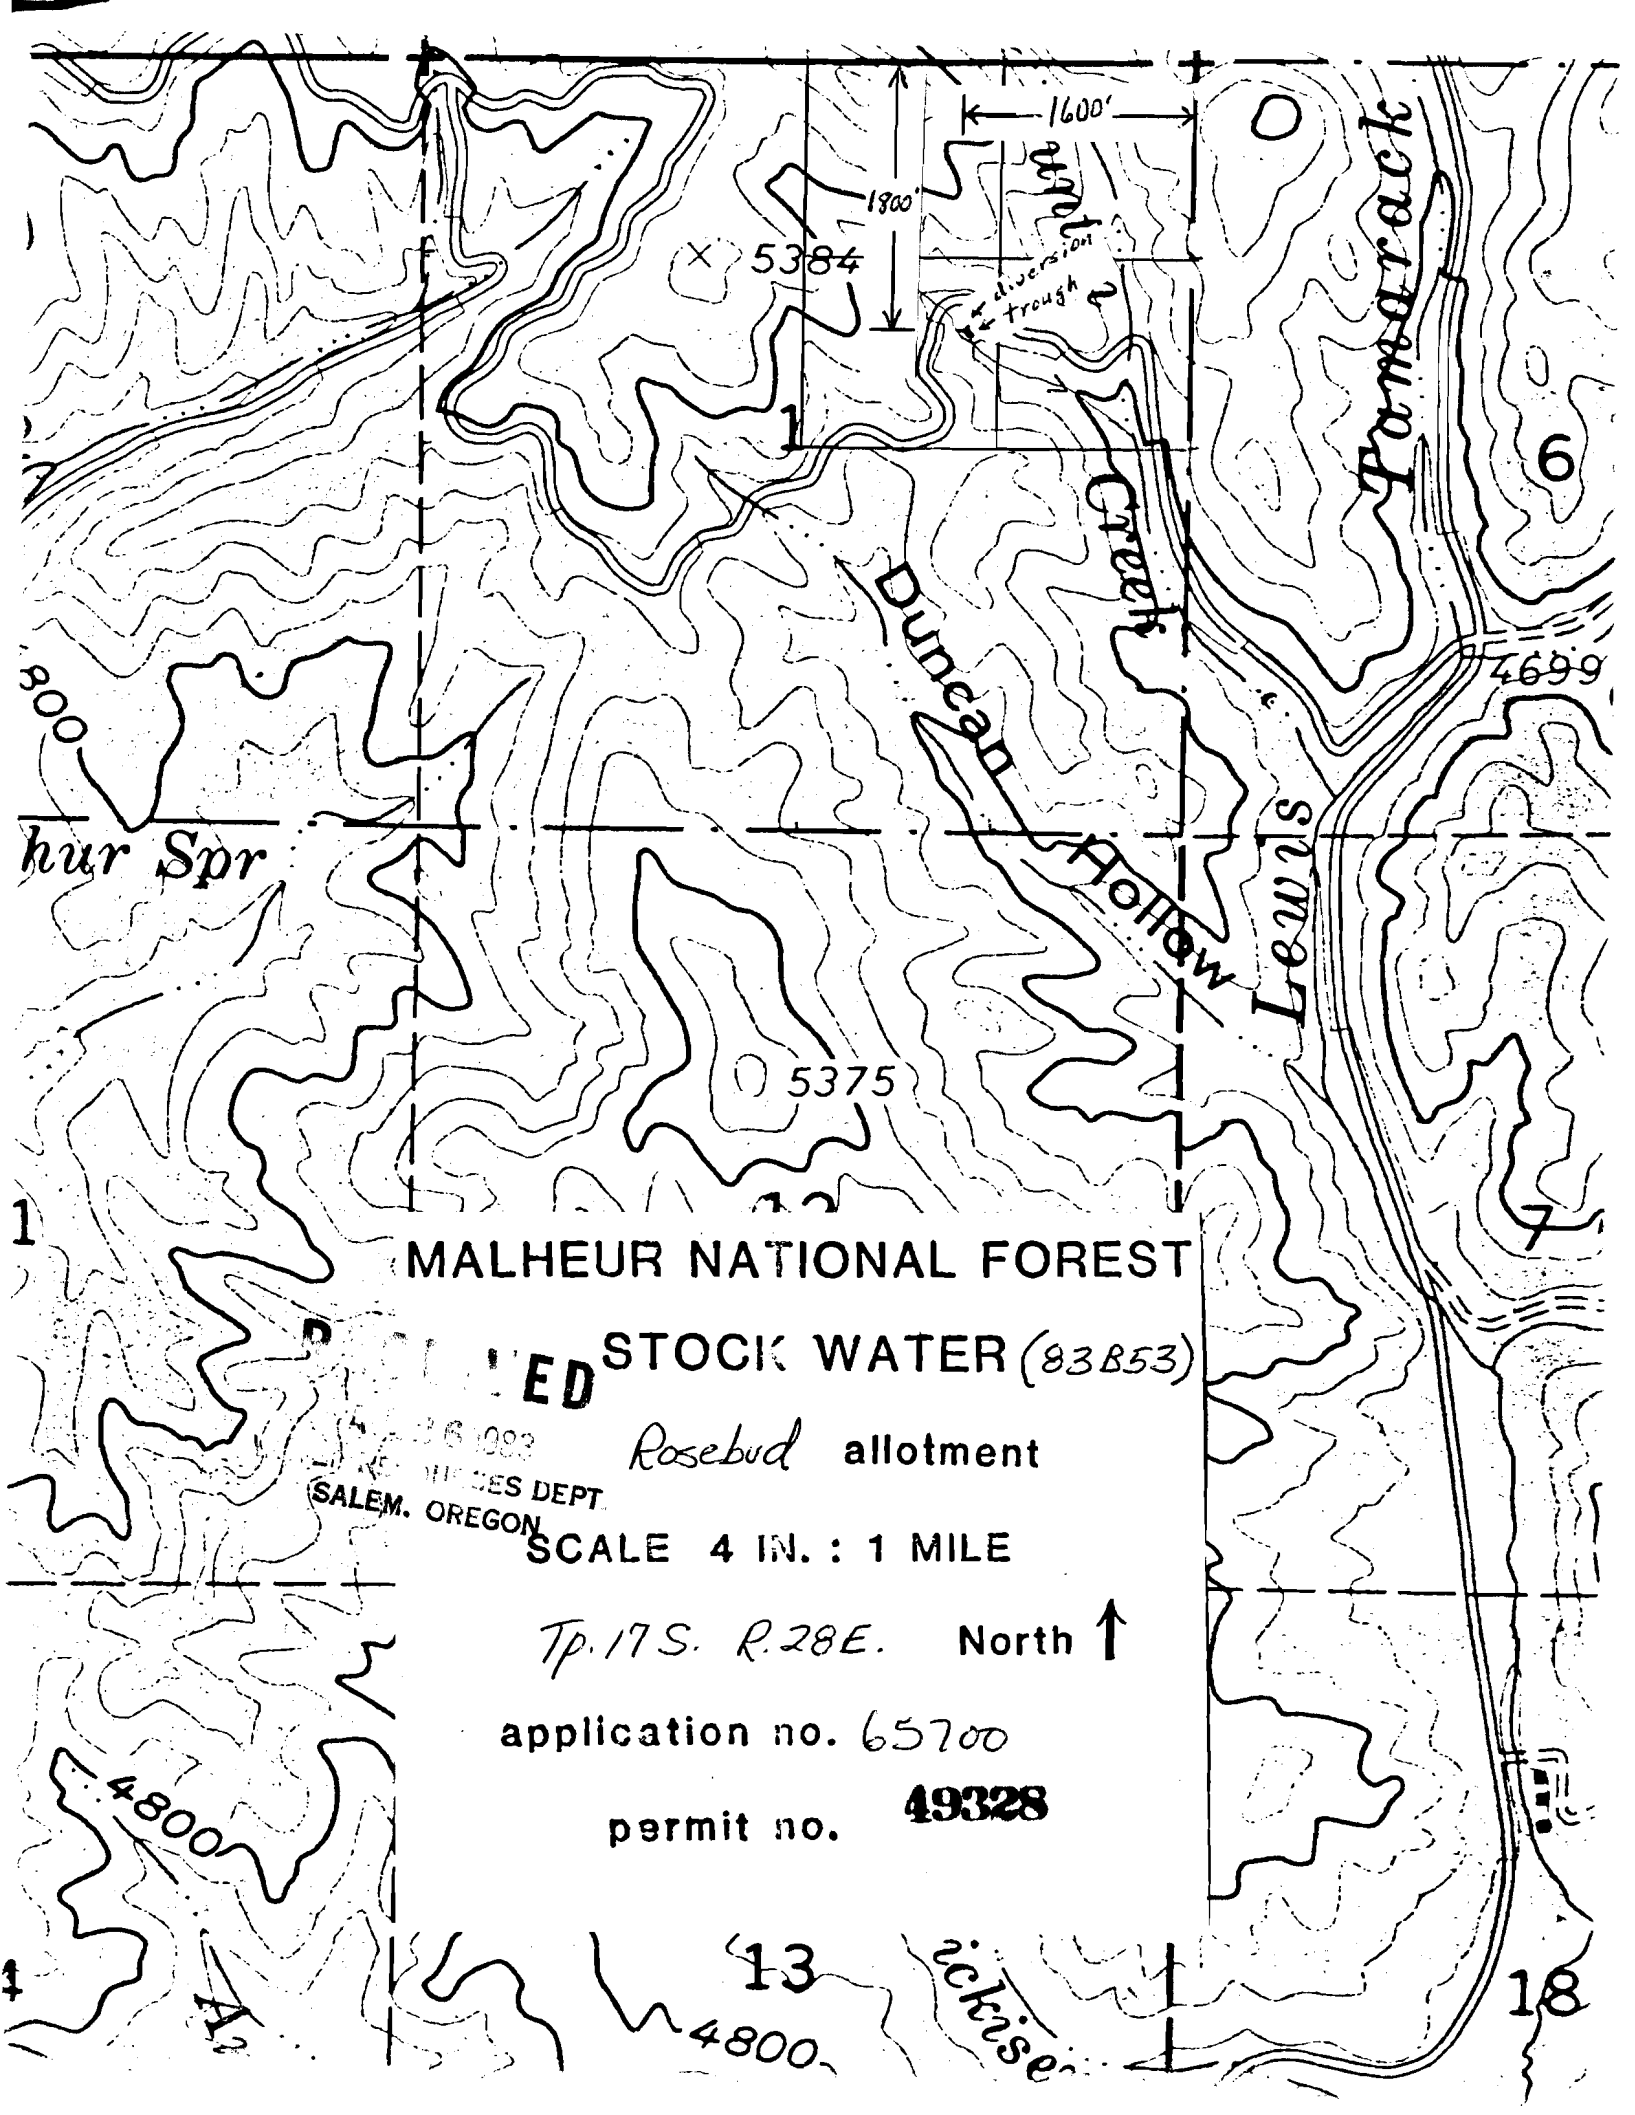

MALHEUR NATIONAL FOREST

STOCK WATER (83B53)

Rosebud allotment

SALEM, OREGON

SCALE 4 IN. : 1 MILE

Tp. 17 S. R. 28 E. North ↑

application no. 65700

permit no. 49328