


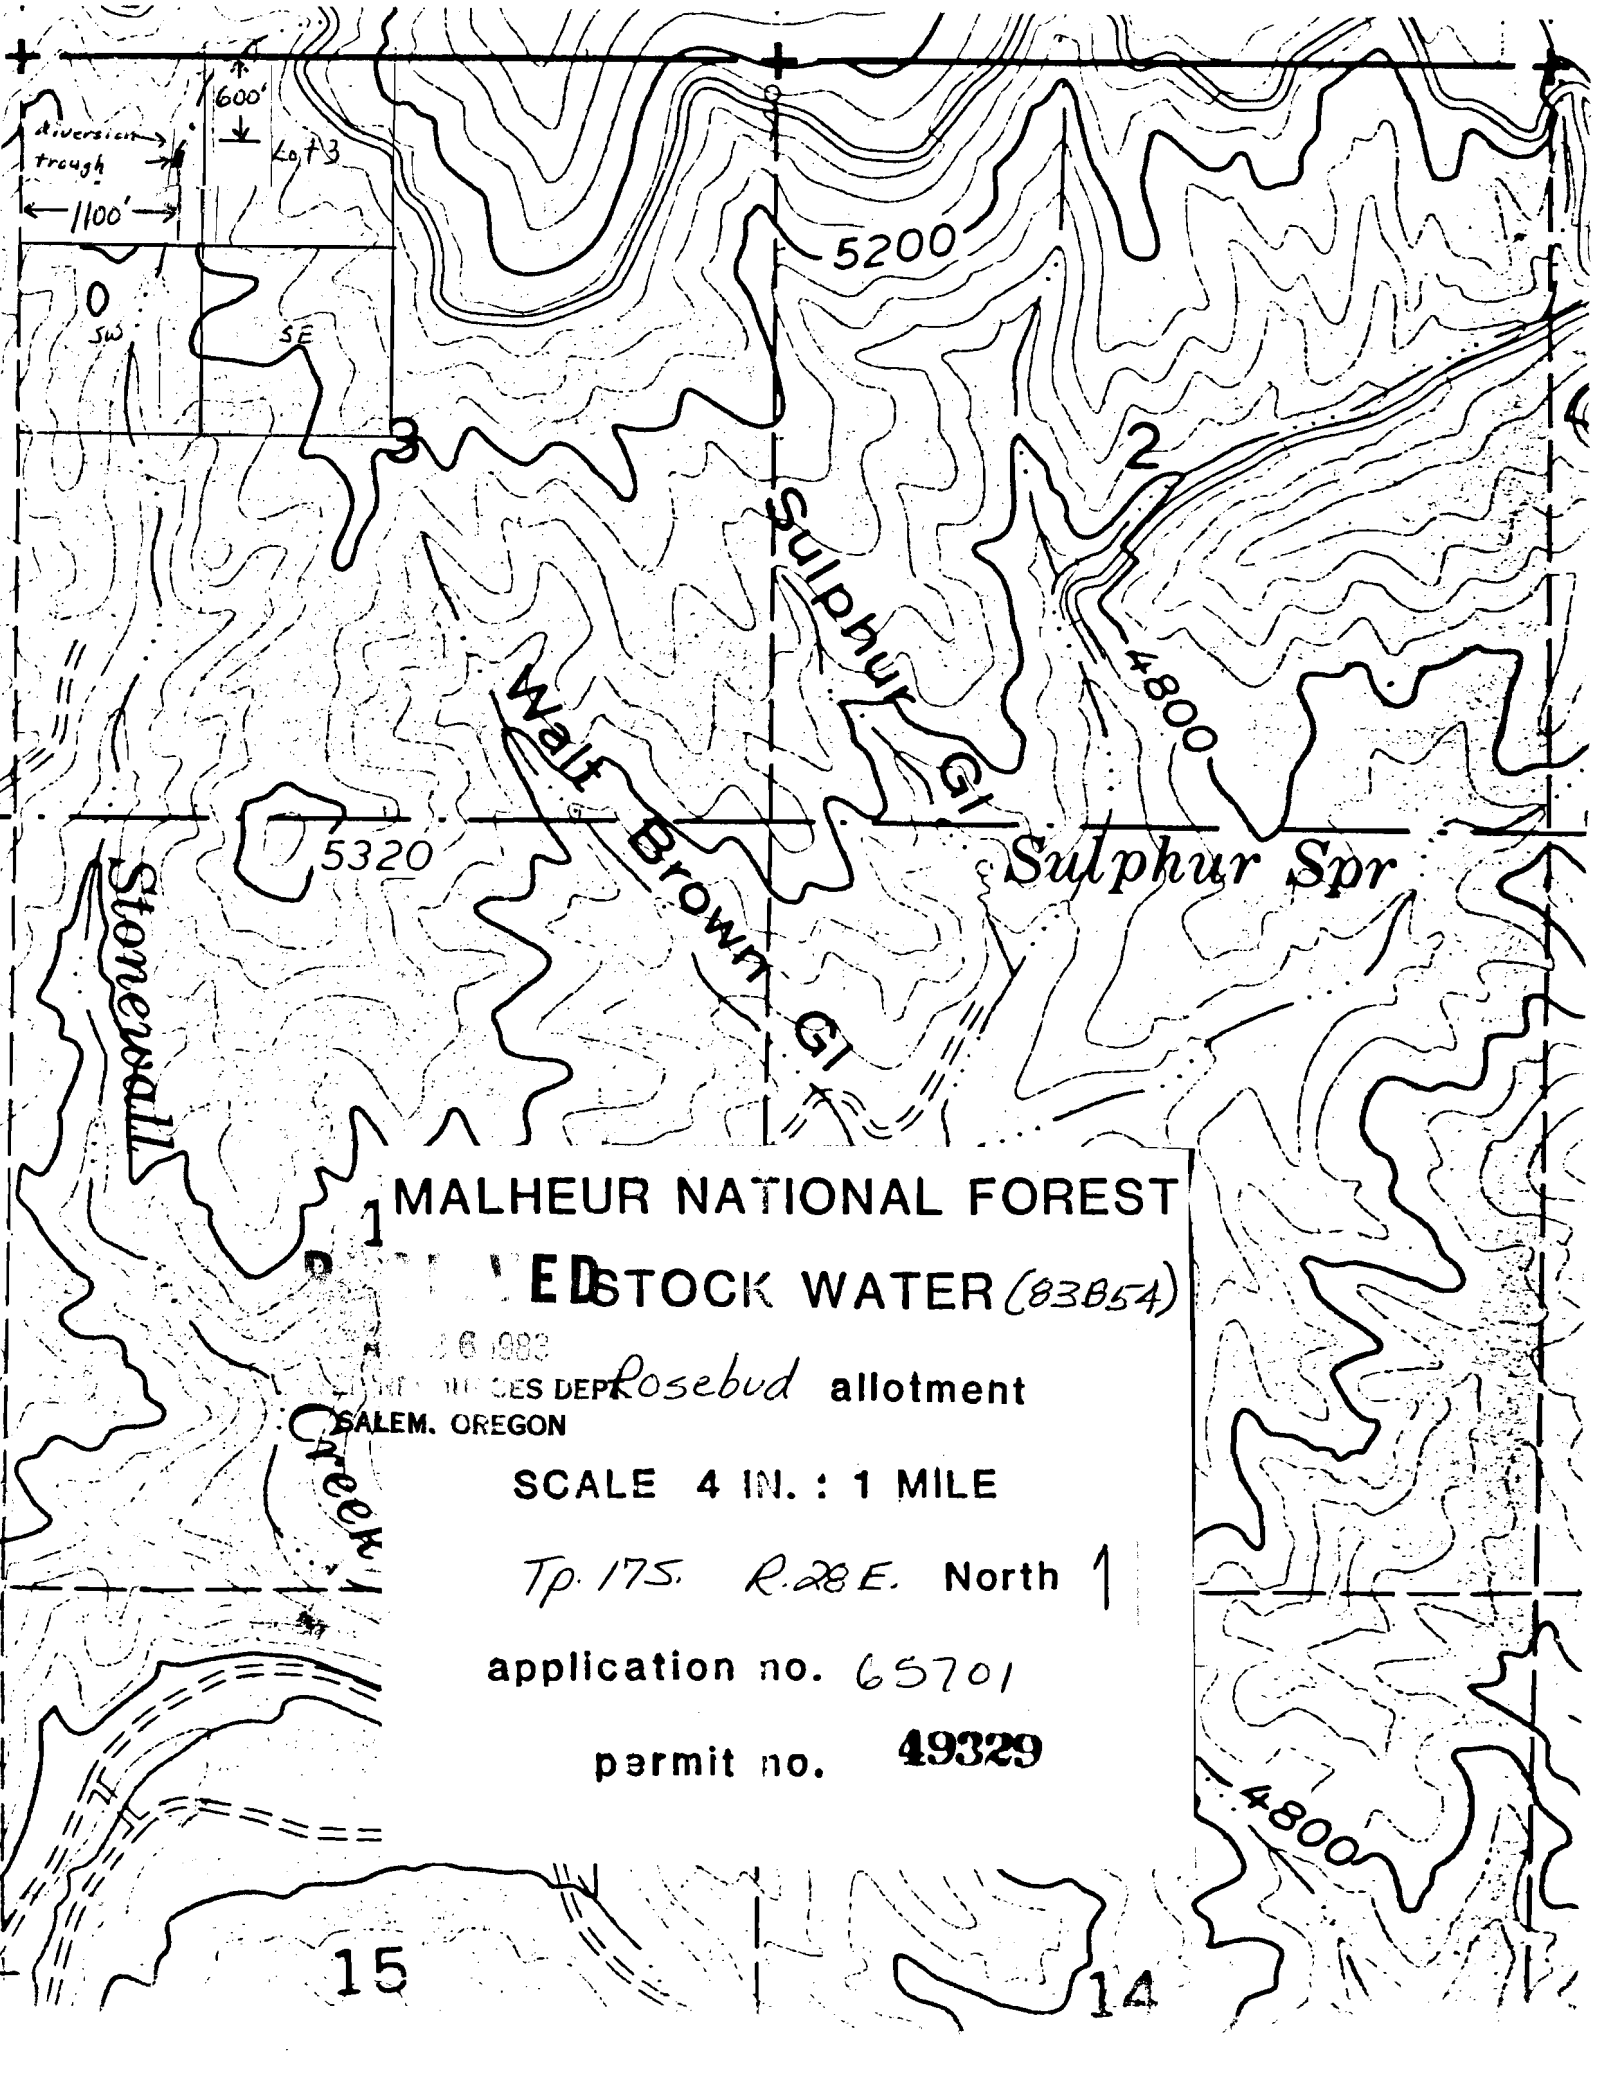

MALHEUR NATIONAL FOREST

EDSTOCK WATER (83B54)

APR 26 1983
SALEM, OREGON
Rosebud allotment

SCALE 4 IN. : 1 MILE

Tp. 17S. R. 28E. North 1

application no. 65701

permit no. 49329

15

14