


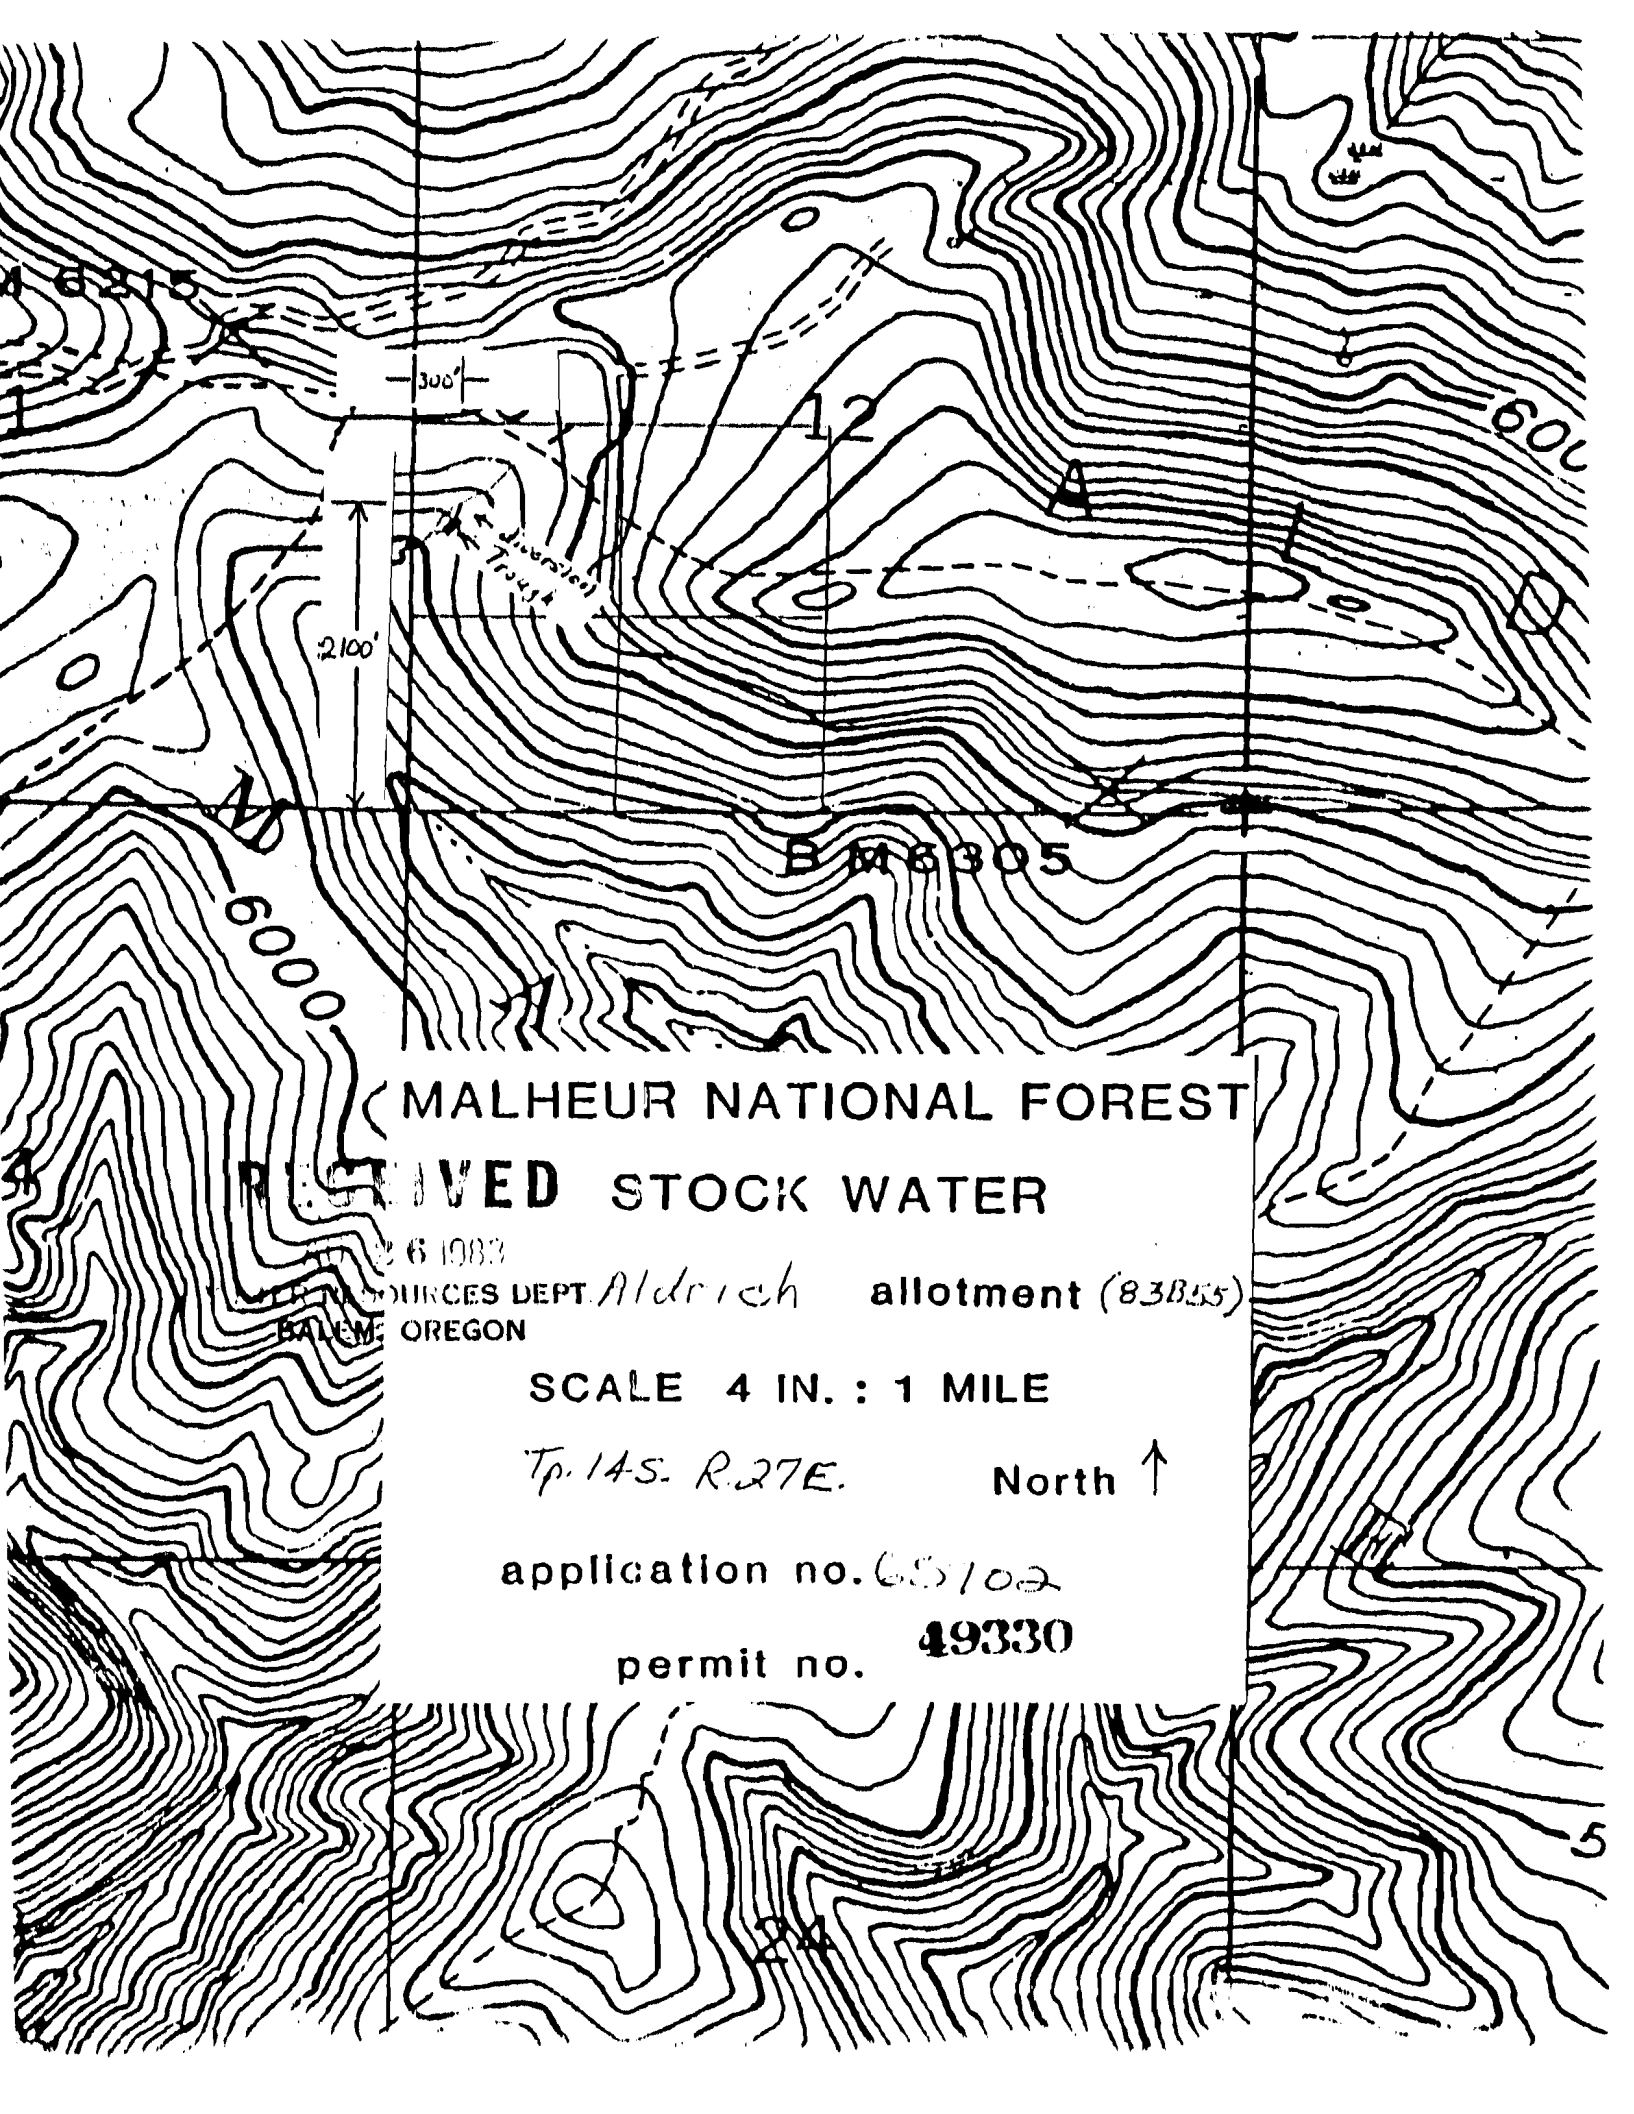

MALHEUR NATIONAL FOREST


JUN 26 1983

WATER RESOURCES DEPT. *Aldrich* allotment (83B55)
BALEME OREGON

SCALE 4 IN. : 1 MILE

Tp. 14S. R. 27E.

North ↑

application no. *65102*

permit no. **49330**